


03 ENLARGED CORRIDOR 118 DEMOLITION PLAN

SCALE: 1/4" = 1'-0"

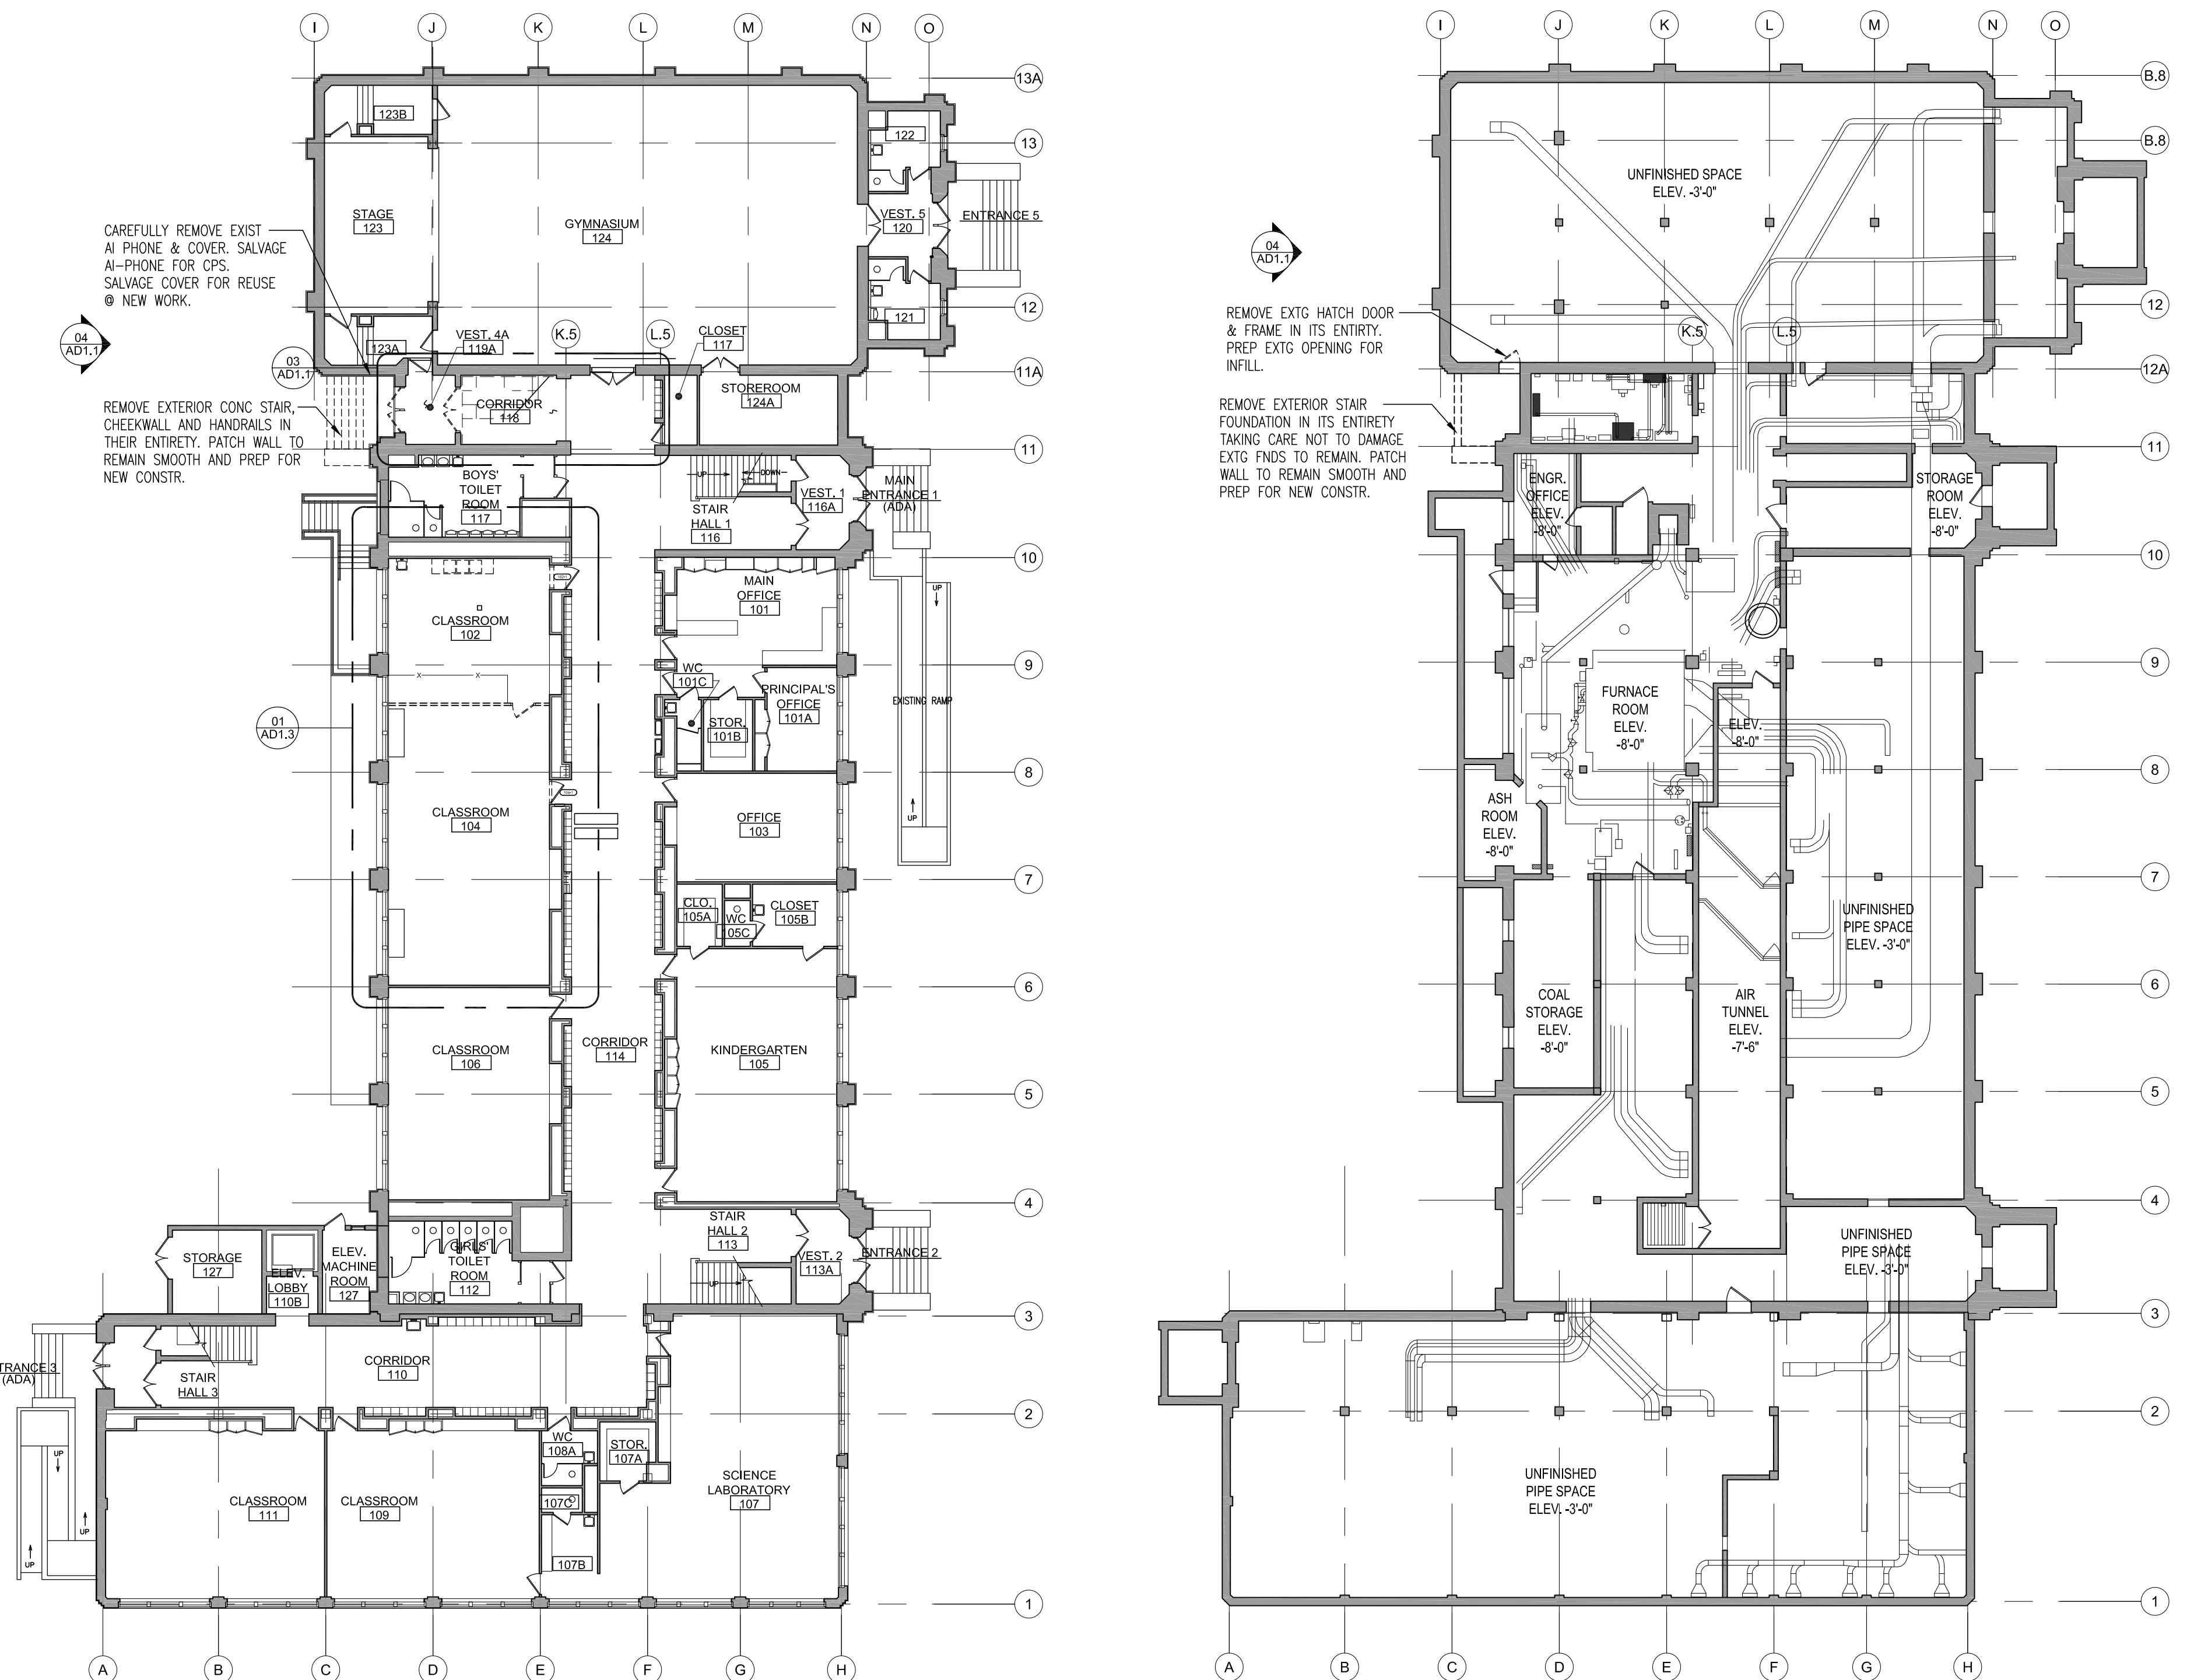

02 1ST FLOOR DEMO PLAN

SCALE: 1/16" = 1'-0"

01 BASEMENT DEMO PLAN

SCALE: 1/16" = 1'-0"


GENERAL DEMOLITION NOTES

- CONTRACTOR TO COORDINATE ALL REMOVAL WITH THE REQUIREMENTS OF NEW CONSTRUCTION.
- CONTRACTOR TO PROTECT FROM DAMAGE ALL EXISTING BUILDING COMPONENTS TO REMAIN.
- ALL HAZARDOUS MATERIALS INCLUDING ASBESTOS PIPE INSULATION WHERE PRESENT, SHALL BE REMOVED AND DISPOSED OF APPROPRIATELY. REFER TO ENVIRONMENTAL PROJECT MANUAL AND DRAWINGS FOR MITIGATION AND REMEDIATION SCOPE. AREAS OF UNFINISHED MATERIALS DUE TO DEMOLITION/REMOVAL OF THE WORK ARE TO BE REPAIRED/PATCHED TO CREATE A CONTINUOUS FINISH THAT MATCHES TO EXISTING ADJACENT AREAS. SEE FINISH PLANS A12.1 AND ENLARGED PLANS AND ELEVATIONS A8.7 FOR DESCRIPTION OF FINISH WORK.
- CONTRACTOR RESPONSIBLE FOR ALL SHORING AND BRACING REQUIRED FOR IMPLEMENTATION OF WORK.
- CONTRACTOR SHALL COORDINATE ALL UTILITY DISCONNECTION, CAPPING OFF, AND SHUTOFFS THAT MAY BE REQUIRED FOR DEMOLITION.
- CONTRACTOR IS RESPONSIBLE FOR THE LEGAL DISPOSAL OF ALL DEMOLISHED MATERIALS.
- CONTRACTOR TO VERIFY ALL EXISTING CONDITIONS AND DIMENSIONS IN FIELD PRIOR TO PROCEEDING WITH WORK. NOTIFY ARCHITECT OF ANY DISCREPANCIES.
- REFER TO MEP/FP AND STRUCTURAL DRAWINGS FOR ADDITIONAL ITEMS REQUIRING DEMOLITION AND COORDINATION.
- PROVIDE PROTECTION TO MECHANICAL GRILLES, DUCTS, AND EQUIPMENT TO PREVENT THE MIGRATION OF DUST AND DAMAGE TO THE UNITS.

ENVIRONMENTAL NOTE:
WARNING: LEAD-BASED PAINT MAY BE PRESENT WITHIN THE BUILDING. IT IS THE RESPONSIBILITY OF THE CONTRACTOR TO TAKE APPROPRIATE SAFETY MEASURES IN ACCORDANCE WITH APPLICABLE FEDERAL, STATE, AND LOCAL RULES AND REGULATIONS INCLUDING OSHA (1926.62) COMPLIANCE, WASTE CHARACTERIZATION AND WASTE DISPOSAL. ALL WORK WITH SURFACES CONTAINING LEAD-BASED PAINT SHALL BE DONE IN ACCORDANCE WITH SECTION 02 08 19 13.

LEGEND

- REMOVE EXISTING WALL
- INSULATED METAL SPANDREL PANEL
- EXPOSED BRICK IN STAIR 4
- MASONRY REMOVAL SCOPE
- REMOVE JOINT AND REPOINT MASONRY

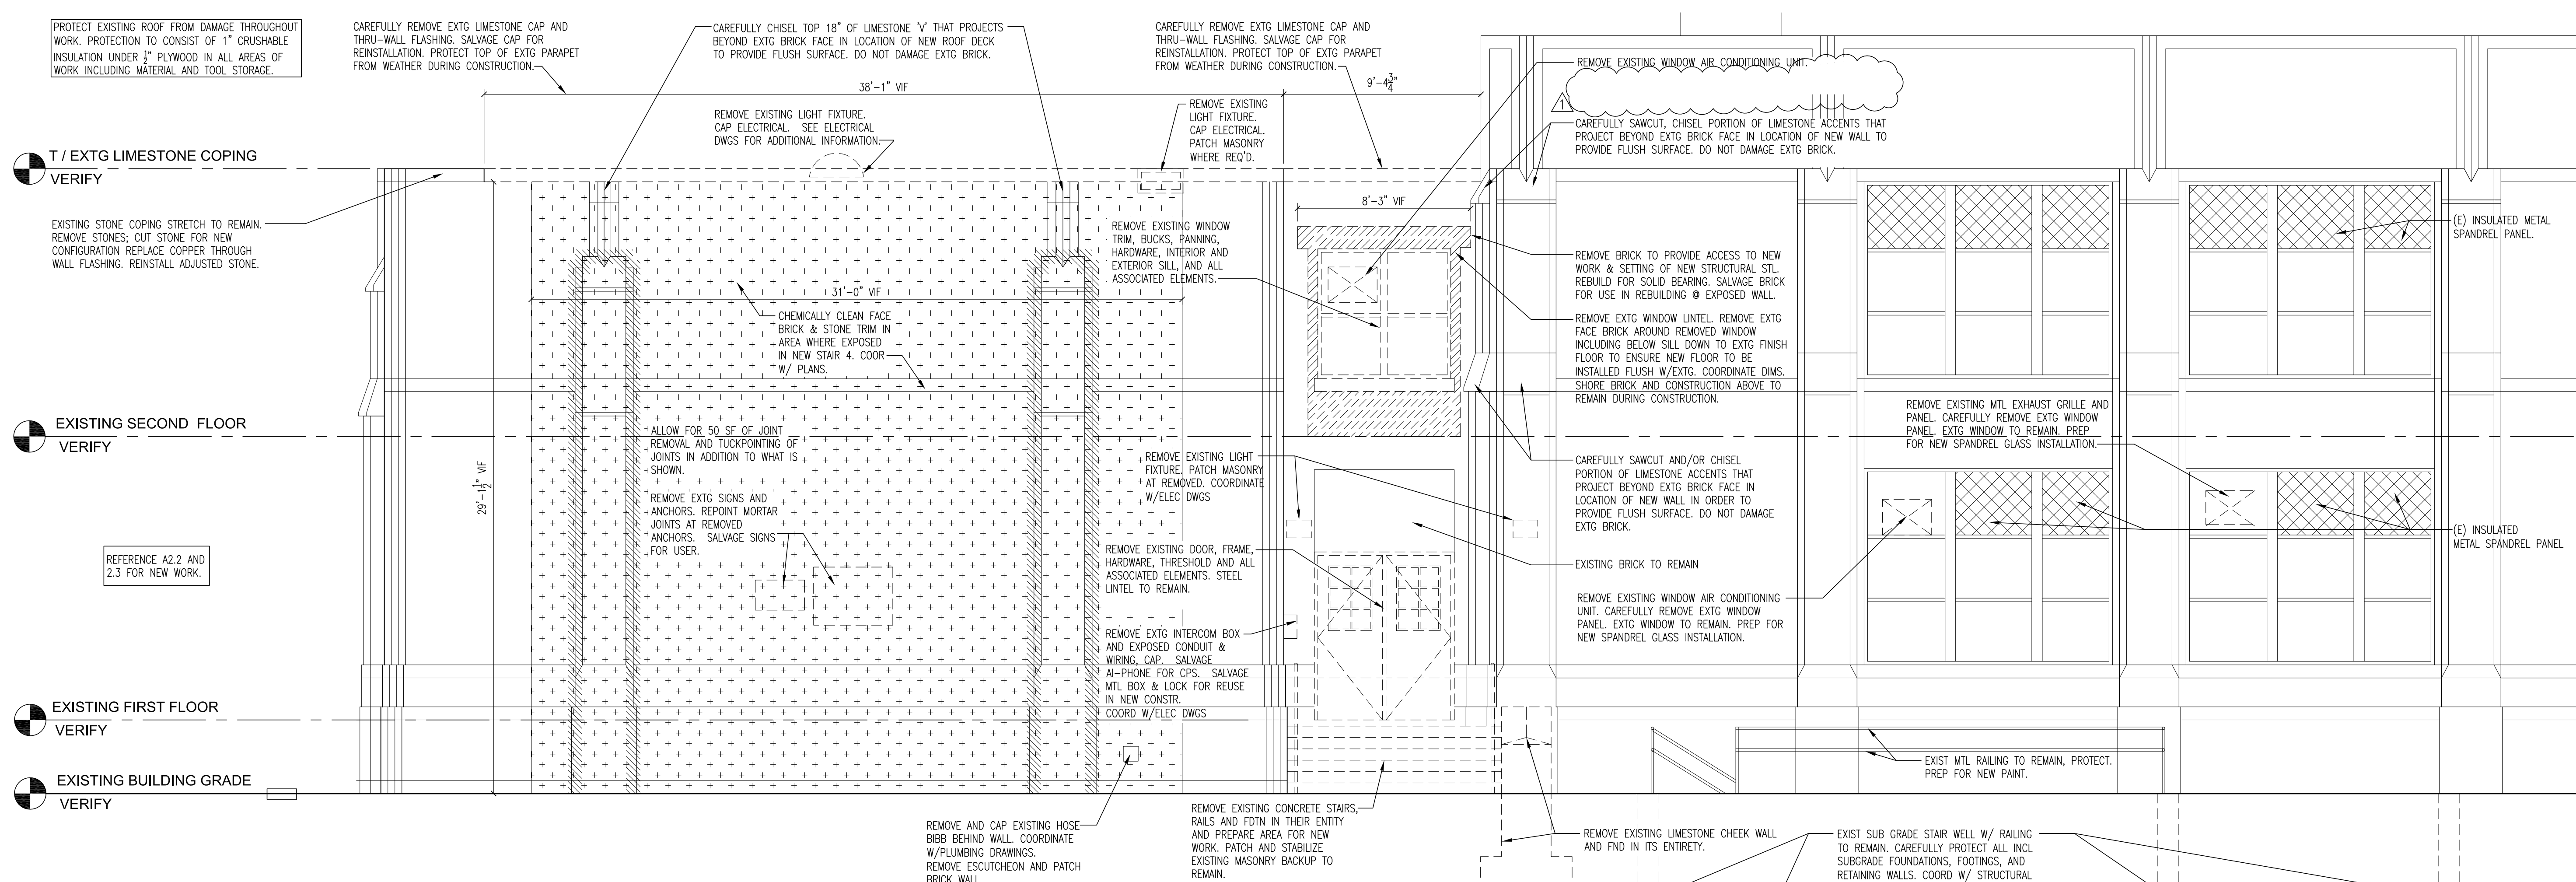

04 WEST ELEVATION - DEMO (ORIGINAL BUILDING)

SCALE: 1/4" = 1'-0"



EDISON PARK ELEMENTARY SCHOOL ANNEX
6220 N. OLCOTT AVE
CHICAGO, IL 60631
CHICAGO PUBLIC SCHOOLS
CITY OF CHICAGO, MAYOR RAHM EMANUEL

THESE DRAWINGS HAVE BEEN PREPARED AT AND UNDER MY SUPERVISION AND TO THE BEST OF MY KNOWLEDGE AND BELIEF CONFORM AND COMPLY WITH THE REQUIREMENTS OF THE CHICAGO DEPARTMENT OF BUILDING.

ILLINOIS
KATHLEEN O'DONNELL
REGISTERED ARCHITECT
001-016351
EXPIRATION DATE: NOVEMBER 30, 2014

TRIPARTITE, INC.
Architecture Restoration Design
4720 N. Virginia Ave.
Chicago, Illinois 60625
P: 773-581-4094
www.tripartiteinc.com

MATRIX ENGINEERING CORPORATION
331 N. JACKSON BLVD. 4TH FLOOR CHICAGO, IL 60654
STRUCTURAL ENGINEERING

SITE DESIGN GROUP, LTD.
1818 N. MICHIGAN AVE. SUITE 1001 CHICAGO, IL 60610
LANDSCAPE DESIGN

TERRA ENGINEERING, LTD.
225 W. OHIO STREET 4TH FLOOR CHICAGO, IL 60604
CIVIL ENGINEERING

CALOR DESIGN GROUP, LTD.
2017 N. WESTERN AVE. CHICAGO, IL 60657
MECHANICAL, PLUMBING, FIRE PROTECTION

TECHKNOW ENGINEERING, LLC
116 KOSTER ST. SUITE 1101 CHICAGO, IL 60605
QUALITY CONTROL, LOW VOLTAGE, SECURITY, FIRE ALARM

HJ KESSLER ASSOCIATES
1980 N. LAKE SHORE DRIVE, SUITE 501 CHICAGO, IL 60613
LEED CONSULTANT

EDGE ASSOCIATES, INC
200 E. LAKE STREET, SUITE 303 AUBURN, IL 60011
FOOD SERVICES

DOOR SECURITY SOLUTIONS
114 KOSTER AVE. HENNEBELL, IL 60158
HARDWARE CONSULTANT

PIN DROP ACOUSTICS
2017 W. LAKE STREET, #100 CHICAGO, IL 60608
ACOUSTIC CONSULTANT

ISSUANCE

MARK	DESCRIPTION	DATE
1	ISSUE FOR BID	12-18-2012
2	ADDENDUM 1	01-17-2013
3		
4		
5		
6		
7		
8		

SCALE: AS NOTED
PLOT DATE: 1/17/2013
PBC PROJECT NAME EDISON PARK ELEMENTARY SCHOOL ANNEX
PBC CONTRACT NO.:
PROJECT NO.: 05650


WARNING:
ASBESTOS-CONTAINING BUILDING MATERIALS ARE OR MAY BE PRESENT IN THE BUILDING. AN ASBESTOS MANAGEMENT PLAN IS AVAILABLE IN THE SCHOOL FOR REVIEW UPON REQUEST. NO PERSON MAY DISTURB ASBESTOS-CONTAINING MATERIALS UNLESS THAT PERSON IS A LICENSED ASBESTOS WORKER OR CONDUCTS SUCH WORK IN ACCORDANCE WITH SPECIFICATIONS CONTAINED IN THE PROJECT DOCUMENTS AND IN COMPLIANCE WITH ILLINOIS DEPARTMENT OF HEALTH RULES AND REGULATIONS.

TITLE:
BSMT & 1ST FLOOR
DEMO PLANS, DEMO
ELEVATION


SHEET

AD1.1

ENVIRONMENTAL NOTE:
 WARNING: LEAD-BASED PAINT MAY BE PRESENT WITHIN THE BUILDING. IT IS THE RESPONSIBILITY OF THE CONTRACTOR TO TAKE APPROPRIATE SAFETY MEASURES IN ACCORDANCE WITH APPLICABLE FEDERAL, STATE, AND LOCAL RULES AND REGULATIONS INCLUDING OSHA (1926.62) COMPLIANCE, WASTE CHARACTERIZATION AND WASTE DISPOSAL. ALL WORK WITH SURFACES CONTAINING LEAD-BASED PAINT SHALL BE DONE IN ACCORDANCE WITH SECTION 02 08 19.13.

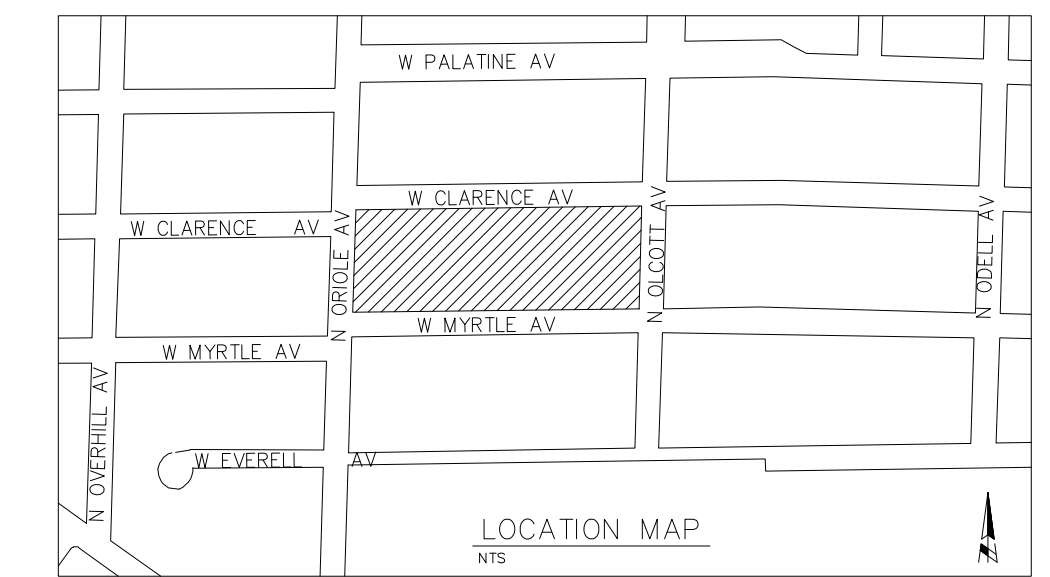

02 VICINITY PLAN
 SCALE: NTS

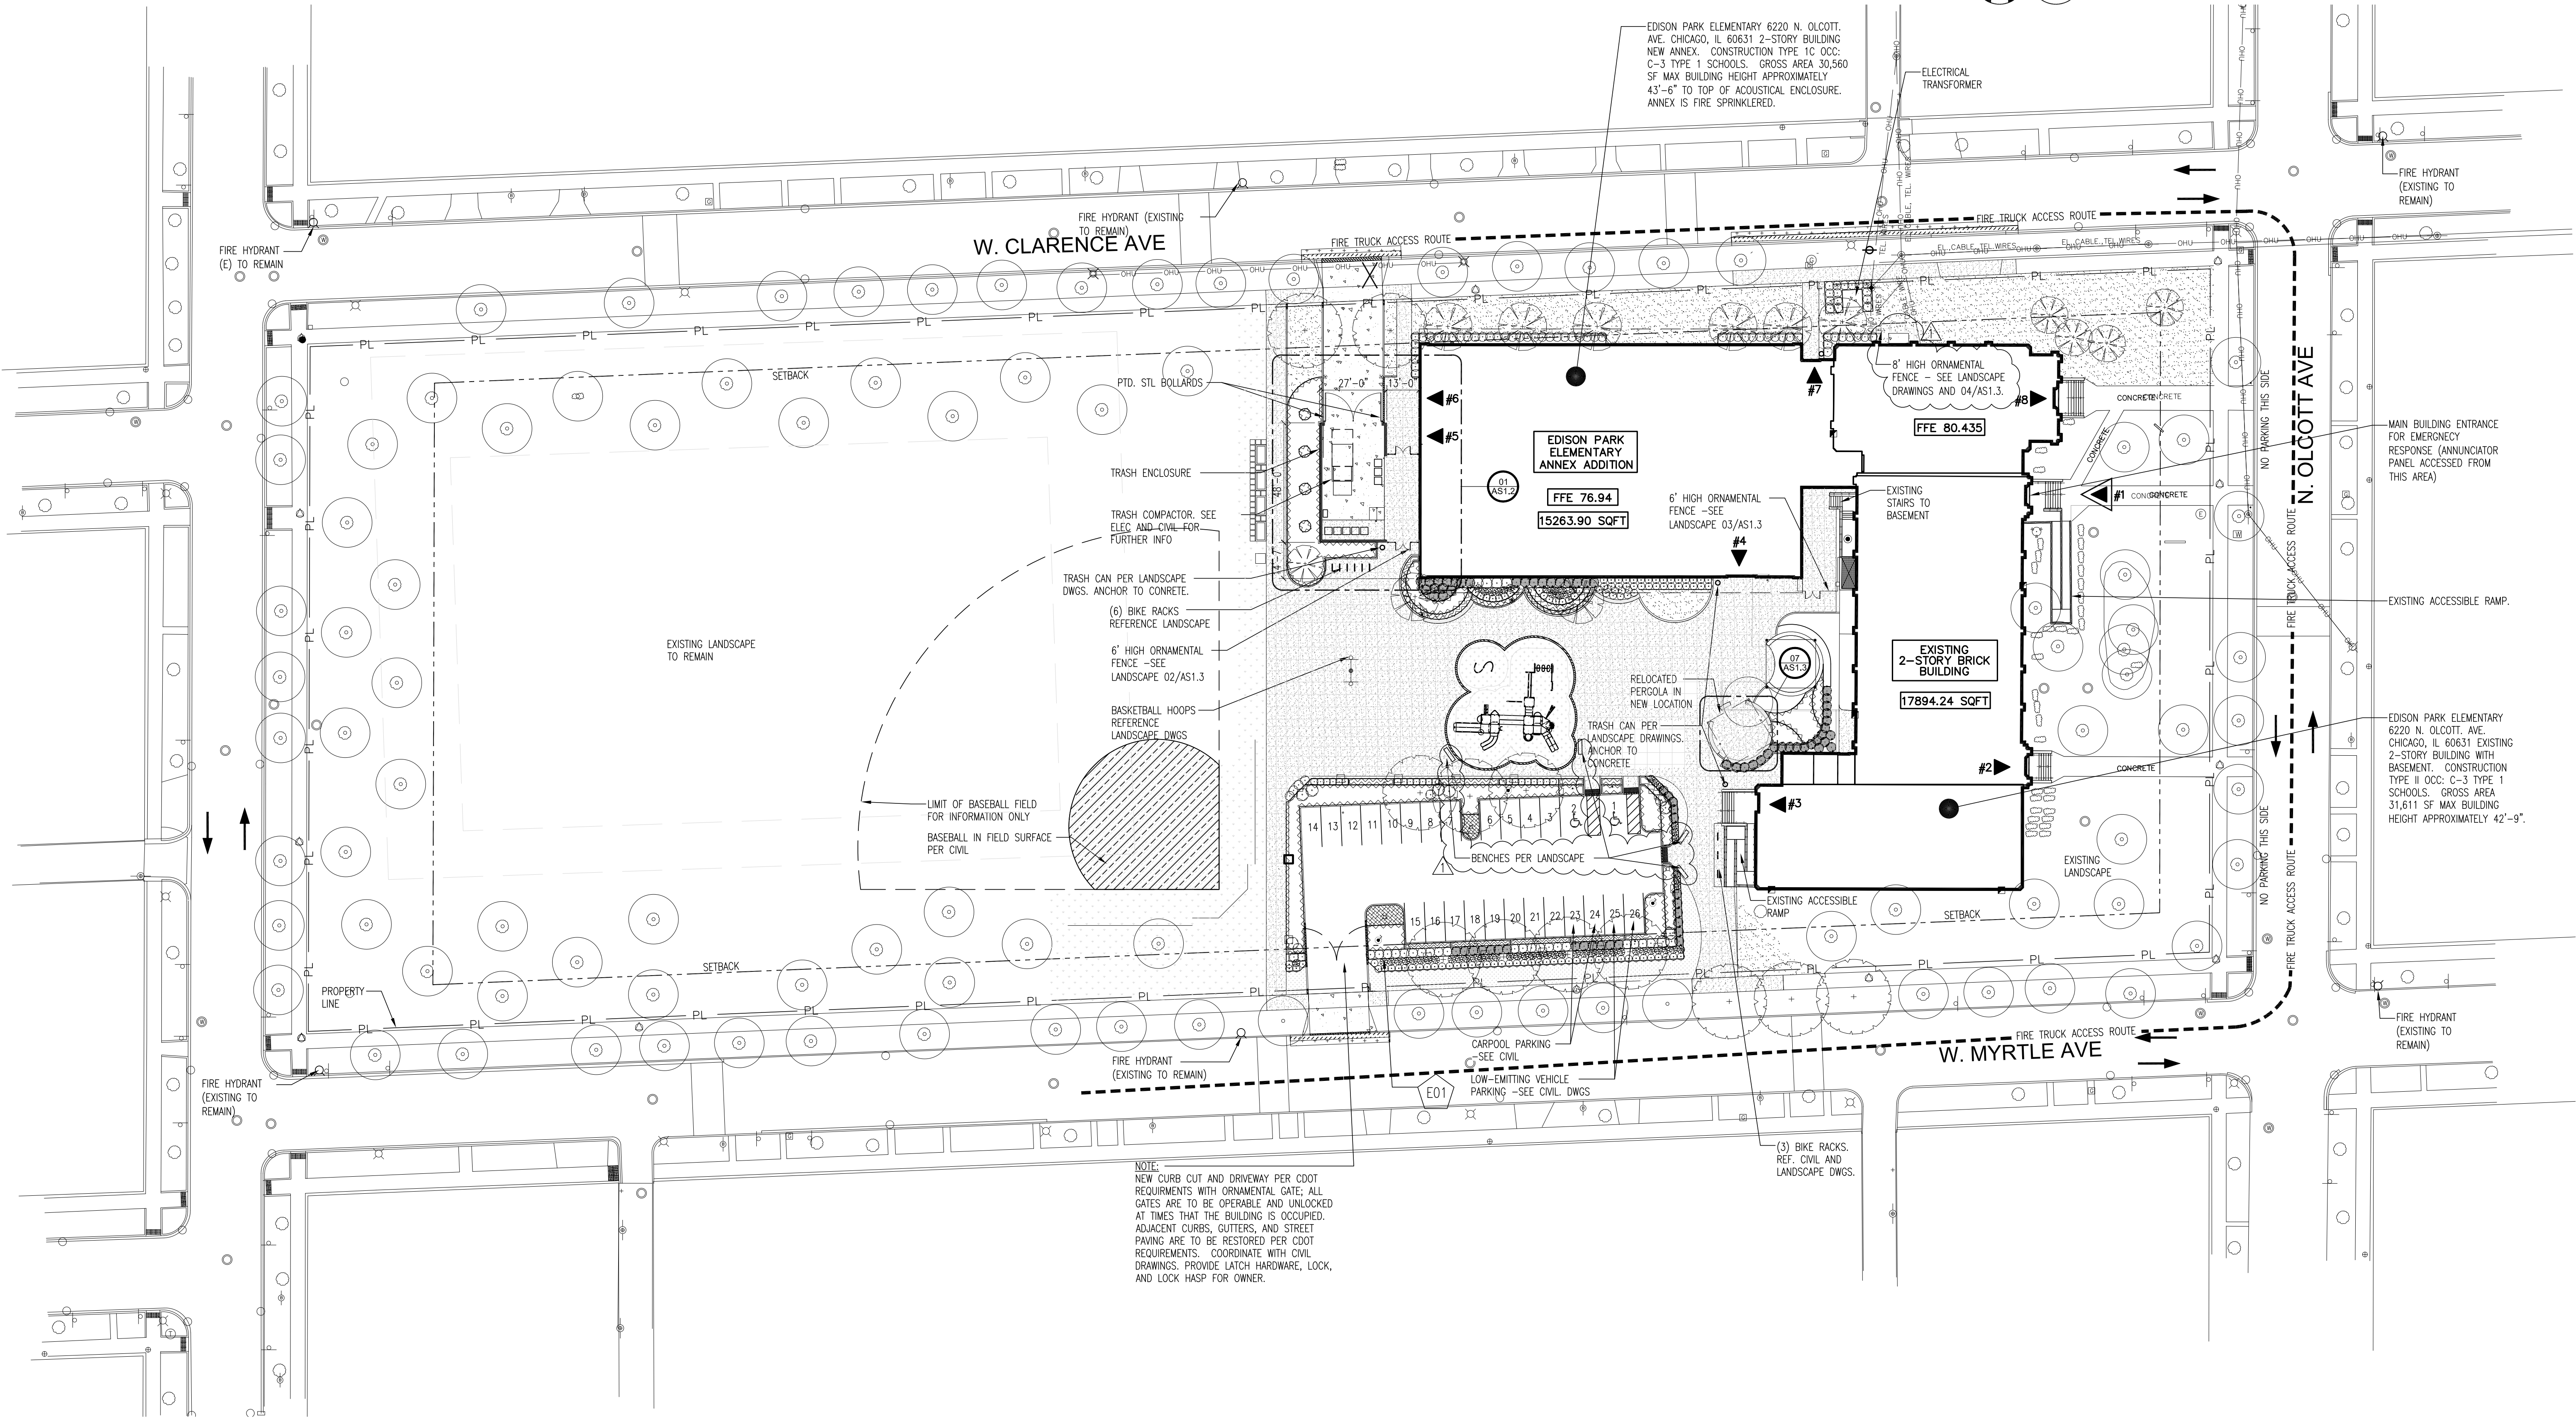

01 FIRE ACCESS SITE PLAN
 SCALE: 1/32" = 1'-0"

NOTE:
 REFERENCE A13.1 FOR ADDITIONAL EXTERIOR BUILDING SIGNAGE NOT SHOWN, CIVIL DRAWING FOR PARKING SIGNAGE AND LANDSCAPE DRAWINGS FOR INTERPRETIVE SIGNAGE.
 REFERENCE A1.1 & A1.2 FOR KEY PLANS

EXISTING BUILDING OCCUPANCY BREAKDOWN:

205F/PP	●	GYMNASIUM
205F/PP	●	CLASSROOM
305F/PP	●	SCIENCE LAB
1005F/PP	●	OFFICE
155F/PP	●	TEACHERS LOUNGE WITH FIXED SEATS
BASEMENT: 6 OCCUPANTS		
1ST FLOOR: 408 OCCUPANTS PER EXITING CALCULATIONS		
2ND FLOOR: 353 OCCUPANTS PER EXITING CALCULATIONS		
TOTAL: 767 OCCUPANTS PER EXITING CALCULATIONS		

BUILDING FLOOR PRINT AREA

EXISTING BUILDING	17,894.24 SQFT
PROPOSED ANNEX	15,263.90 SQFT
TOTAL	33,158.14 SQFT

PROJECT BOUNDARY
 ENTIRE SITE: 66,500 SQ FT (1.52 ACRES)

SITE PLAN SYMBOLS KEY

- PL — PROPERTY LINE
- - - - - SETBACK LINE
- ⊕ FIRE HYDRANT
- ▲ # ENTRANCE / EXIT
- ▲#— FIRE TRUCK ACCESS
- ▲# MAIN BUILDING ENTRY / EXIT
- ORNAMENTAL FENCE AT PARKING AREA, REFERENCE LANDSCAPE DRAWINGS
- X — CHAINLINK FENCE
- EXX REFERENCE EXTERIOR SIGNAGE SCHEDULE A13.3
- ▨ BASEBALL INFIELD SURFACE

GENERAL SITE NOTES

- REFER TO CIVIL AND LANDSCAPE SHEETS FOR EXTENT OF DEMOLITION AND AREAS OF NEW CONSTRUCTION.

FIRE ACCESS NOTES

- EXISTING SCHOOL DOES NOT HAVE A SPRINKLER SYSTEM.
- EXISTING BUILDING DOES NOT HAVE STANDPIPES.
- FIRE ALARM SYSTEM WILL BE EXISTING AND NEW FIRE ALARM PANEL FOR ANNEX WILL BE PROVIDED TO TIE INTO THE EXISTING SYSTEM.
- A 5-FOOT CLEARANCE WILL BE MAINTAINED AROUND ALL EXISTING FIRE HYDRANTS.
- NO ADDITIONAL FIRE HYDRANTS ARE PROPOSED.
- FIRE DEPARTMENT ACCESS TO THE BUILDING DOES NOT REQUIRE ENTERING THROUGH LOCKED GATES.
- ALL DIMENSIONS ARE TO FACE OF CURB OR BUILDING, UNLESS NOTED OTHERWISE.

ANNEX OCCUPANCY BREAKDOWN:

205F/PP	●	CLASSROOM
305F/PP	●	SCIENCE LAB
1005F/PP	●	OFFICE
155F/PP	●	DINING AREA WITH FIXED SEATS
1ST FLOOR: 269 OCCUPANTS PER EXITING CALCULATIONS		
2ND FLOOR: 387 OCCUPANTS PER EXITING CALCULATIONS		
TOTAL: 656 OCCUPANTS PER EXITING CALCULATIONS		



EDISON PARK ELEMENTARY SCHOOL ANNEX
 6220 N. OLCOTT AVE
 CHICAGO, IL 60631
 CHICAGO PUBLIC SCHOOLS
 CITY OF CHICAGO, MAYOR RAHM EMANUEL

THESE DRAWINGS HAVE BEEN PREPARED AT AND FOR UNDER MY SUPERVISION AND TO THE BEST OF MY KNOWLEDGE AND BELIEF CONFORM AND COMPLY WITH THE REQUIREMENTS OF THE CHICAGO DEPARTMENT OF BUILDING.

ILLINOIS
 KATHLEEN O'DONNELL
 REGISTERED ARCHITECT
 001-016351
 EXPIRATION DATE: NOVEMBER 30, 2014

TRIPARTITE, INC.
 Architecture Restoration Design
 4720 N. Virginia Ave.
 Chicago, Illinois 60625
 P: 773-581-4094
 www.tripartiteinc.com

MATRIX ENGINEERING CORPORATION
 3318 N. JACKSON BLVD., 4TH FLOOR / CHICAGO, IL 60654
 STRUCTURAL ENGINEERING

SITE DESIGN GROUP, LTD.
 808 S. MICHIGAN AVE., SUITE 1001 / CHICAGO, IL 60605
 LANDSCAPE DESIGN

TERRA ENGINEERING, LTD.
 235 W. OHIO STREET, 4TH FLOOR / CHICAGO, IL 60604
 CIVIL ENGINEERING

CALOR DESIGN GROUP, LTD.
 2017 N. WESTERN AVE. / CHICAGO, IL 60647
 MECHANICAL, PLUMBING, FIRE PROTECTION

TECHKNOW ENGINEERING, LLC
 1648 W. 95TH ST., SUITE 1100 / CHICAGO, IL 60658
 QUALITY CONTROL, LOW VOLTAGE, SECURITY, FIRE ALARM

HJ KESSLER ASSOCIATES
 1860 N. LAKE SHORE DRIVE, SUITE 501 / CHICAGO, IL 60613
 LEED CONSULTANT

EDGE ASSOCIATES, INC.
 202 S. LAKE STREET, SUITE 303 / ABBOTTBURG, IL 60101
 FOOD SERVICES

DOOR SECURITY SOLUTIONS
 114 KOSTER AVE., HENNEPINSVILLE, IL 60146
 HARDWARE CONSULTANT

PIN DROP ACOUSTICS
 201 W. LAKE STREET, #100 / CHICAGO, IL 60606
 ACOUSTIC CONSULTANT

ISSUANCE

MARK	DESCRIPTION	DATE
1	ISSUE FOR BID	12-18-2012
2	ADDENDUM 1	01-17-2013
3	---	---
4	---	---
5	---	---
6	---	---
7	---	---
8	---	---

SCALE: AS NOTED
 PLOT DATE: 1/17/2013
 PROJECT NAME: EDISON PARK ELEMENTARY SCHOOL ANNEX
 PROJECT NO.: 09650
 PBC CONTRACT NO.: --
 WARNING: ASBESTOS-CONTAINING BUILDING MATERIALS ARE OR MAY BE PRESENT IN THIS BUILDING. AN ASBESTOS MANAGEMENT PLAN IS AVAILABLE IN THE SCHOOL. FOR REVIEW UPON REQUEST. NO PERSON MAY DISTURB ASBESTOS-CONTAINING MATERIALS UNLESS THAT PERSON IS A LICENSED ASBESTOS WORKER OR CONSULTS WITH A LICENSED ASBESTOS CONSULTANT IN ACCORDANCE WITH SPECIFICATIONS CONTAINED IN THE PROJECT DOCUMENTS AND IN COMPLIANCE WITH ILLINOIS DEPARTMENT OF HEALTH RULES AND REGULATIONS.

TITLE:
 FIRE DEPT. SITE PLAN REVIEW

SHEET
 AS1.1

THESE DRAWINGS HAVE BEEN PREPARED AT AND FOR UNDER MY SUPERVISION AND TO THE BEST OF MY KNOWLEDGE AND BELIEF CONFORM AND COMPLY WITH THE REQUIREMENTS OF THE CHICAGO DEPARTMENT OF BUILDING.

ILLINOIS
KATHLEEN O'DONNELL
REGISTERED ARCHITECT
001-016351
EXPIRATION DATE: NOVEMBER 30, 2014

TRIPARTITE, INC.
Architecture Restoration Design
4720 N. Virginia Ave.
Chicago, Illinois 60625
P: 773-581-0894
www.tripartiteinc.com

MATRIX ENGINEERING CORPORATION
3318 JACKSON BLVD., 4TH FLOOR, CHICAGO, IL 60654
STRUCTURAL ENGINEERING

SITE DESIGN GROUP, LTD.
808 S. MICHIGAN AVE., SUITE 1001, CHICAGO, IL 60605
LANDSCAPE DESIGN

TERRA ENGINEERING, LTD.
225 W. OHIO STREET, 4TH FLOOR, CHICAGO, IL 60604
CIVIL ENGINEERING

CALOR DESIGN GROUP, LTD.
2011 N. WESTERN AVE., CHICAGO, IL 60647
MECHANICAL, PLUMBING, FIRE PROTECTION

TECHKNOW ENGINEERING, LLC
1016 S. STATE ST., SUITE 1100, CHICAGO, IL 60605
QUALITY CONTROL, LOW VOLTAGE, SECURITY, FIRE ALARM

HJ KESSLER ASSOCIATES
1860 LAKE SHORE DRIVE, SUITE 501, CHICAGO, IL 60613
LEED CONSULTING

EDGE ASSOCIATES, INC.
202 S. LAKE STREET, SUITE 303, AUBURN, IL 60011
FOOD SERVICES

DOOR SECURITY SOLUTIONS
114 COCKER AVE., HENNEBELLE, IL 60155
HARDWARE CONSULTANT

PIN DROP ACOUSTICS
2011 N. LAKE STREET, #100, CHICAGO, IL 60606
ACOUSTIC CONSULTANT

ISSUANCE

MARK	DESCRIPTION	DATE
1	ISSUE FOR BID	12-18-2012
2	ADDENDUM 1	01-17-2013
3	---	---
4	---	---
5	---	---
6	---	---
7	---	---
8	---	---

SCALE: AS NOTED
PLOT DATE: 1/17/2013

PFC PROJECT NAME: EDISON PARK ELEMENTARY SCHOOL ANNEX


PBC CONTRACT NO.:

PROJECT NO.: 05650

WARNING: ASBESTOS-CONTAINING BUILDING MATERIALS ARE OR MAY BE PRESENT IN THIS BUILDING. AN ASBESTOS MANAGEMENT PLAN IS AVAILABLE AT THE SCHOOL FOR REVIEW UPON REQUEST. NO WORK SHALL BE PERFORMED ON ASBESTOS-CONTAINING MATERIALS UNLESS THAT PERSONNEL ARE LICENSED ASBESTOS WORKERS OR CONTRACTORS WHO WORK IN ACCORDANCE WITH SPECIFICATIONS CONTAINED IN THE PROJECT DOCUMENTS AND IN COMPLIANCE WITH ILLINOIS DEPARTMENT OF HEALTH RULES AND REGULATIONS.

TITLE:
ROOF PLAN - ANNEX

SHEET

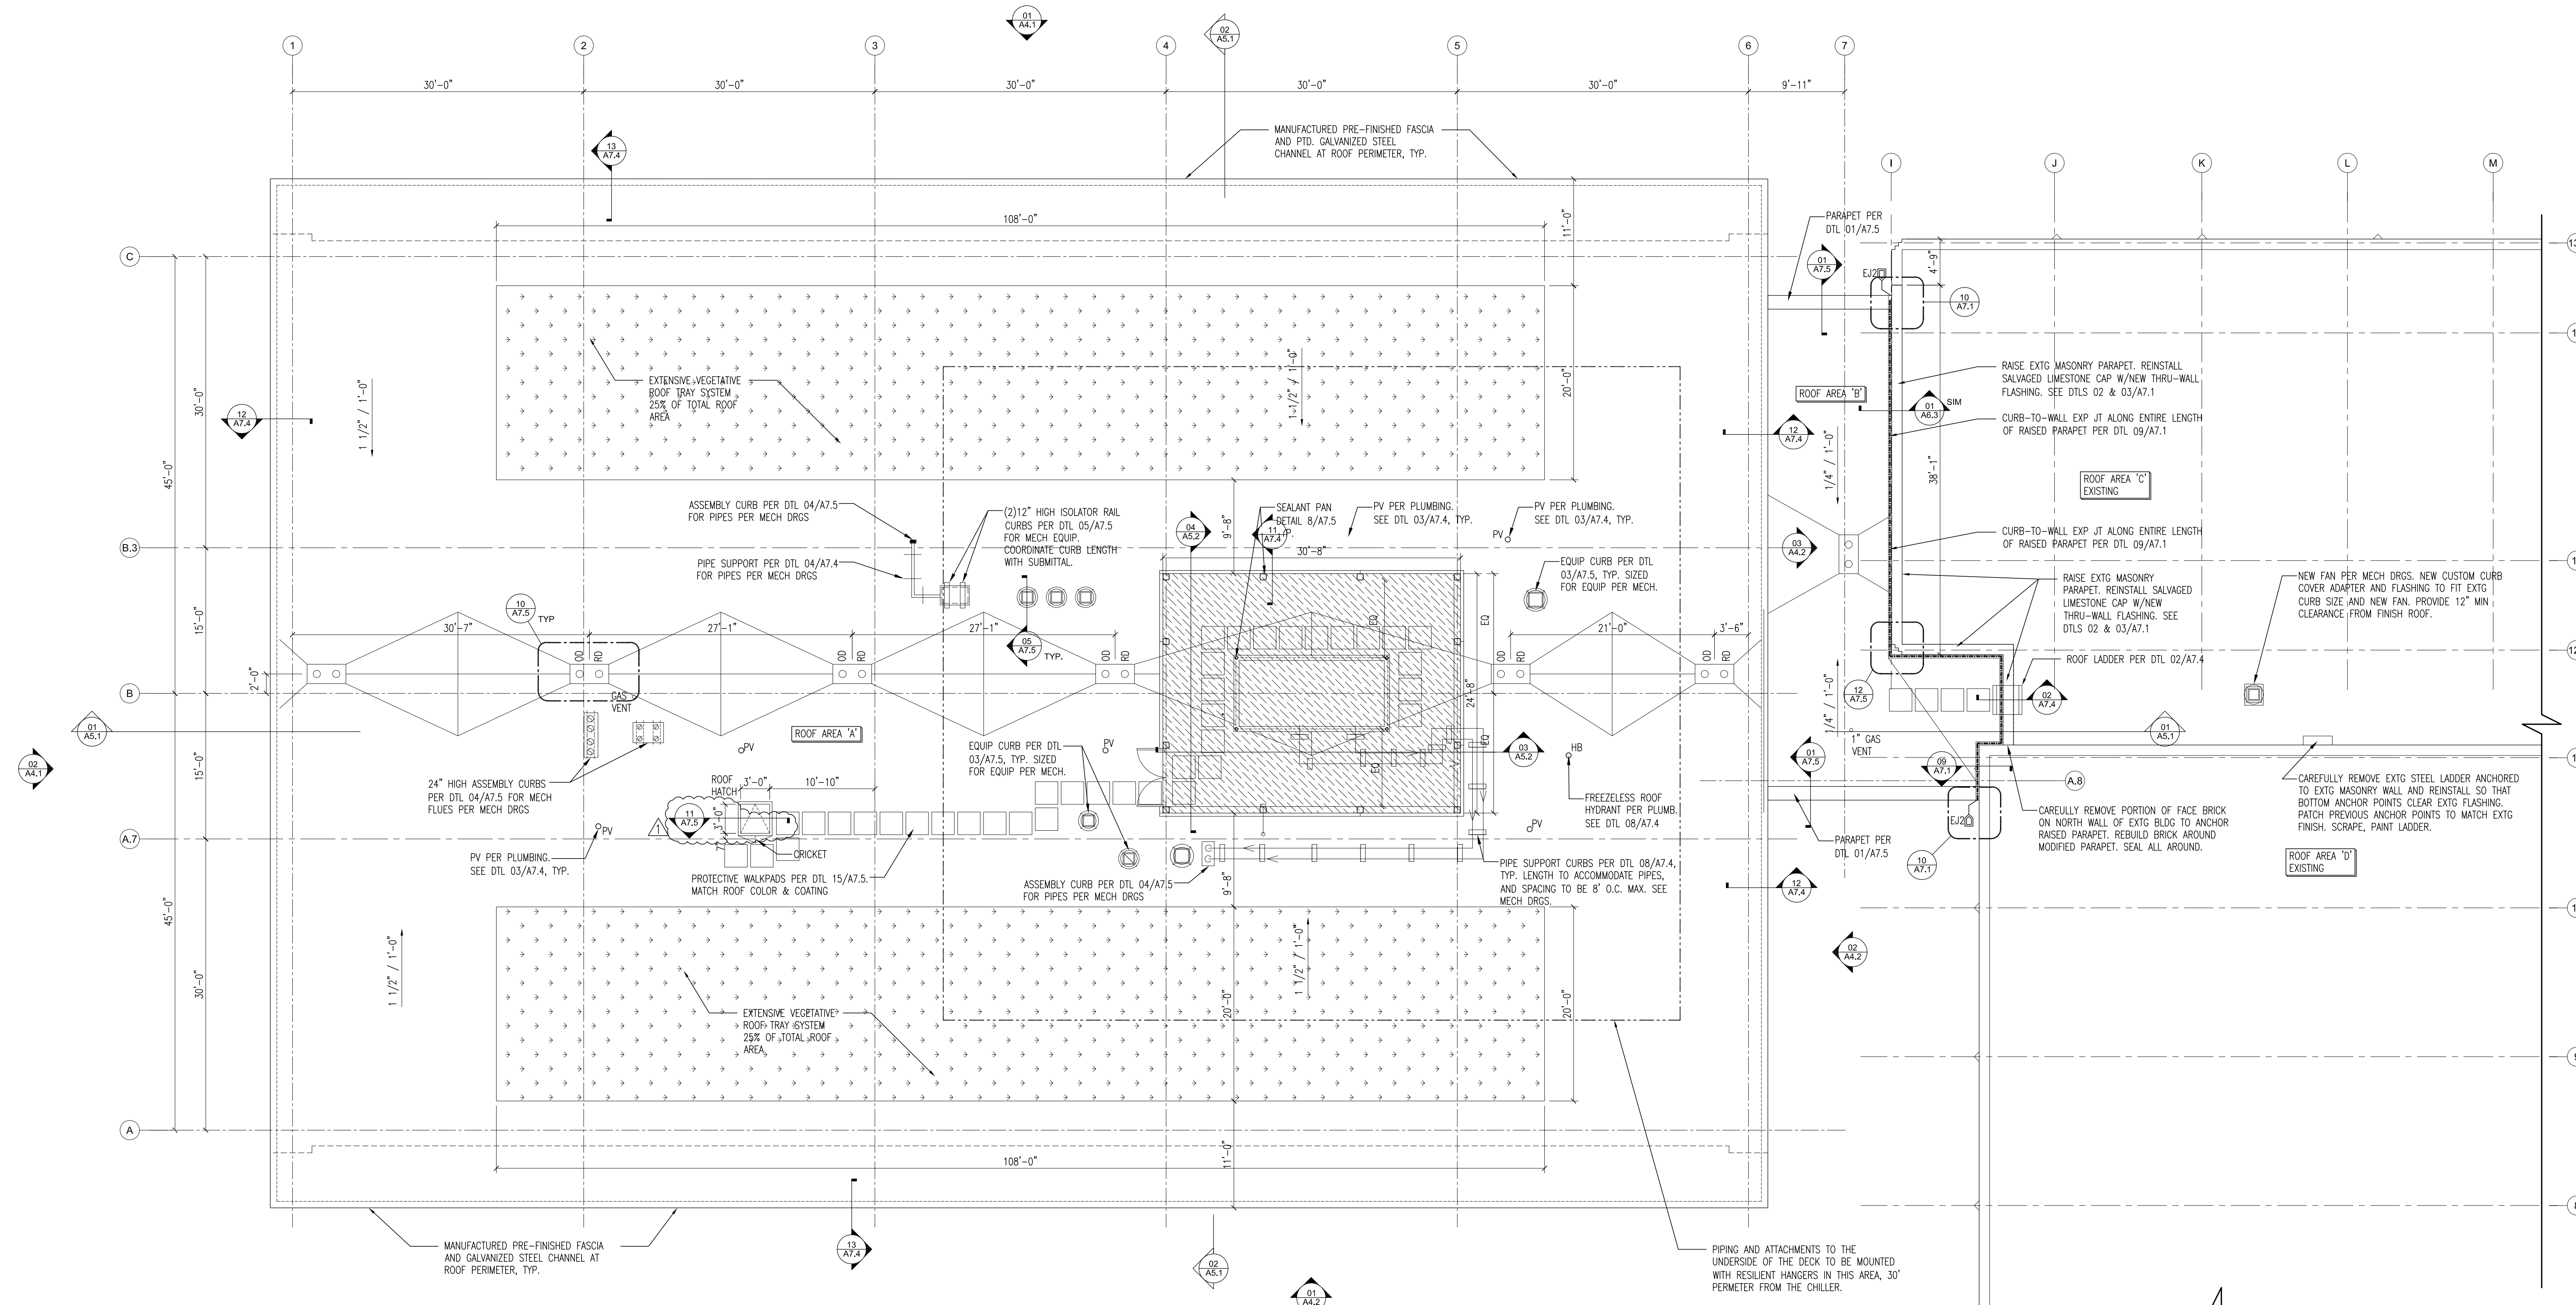

01 ROOF PLAN - ANNEX

SCALE: 1/8" = 1'-0"

GENERAL ROOF PLAN NOTES

- ROOF SYSTEM PROVIDED SHALL BE A CLASS 'A' ROOF SYSTEM.
- ALL WORK TO BE COORDINATED WITH MASON AND ROOF CONTRACTORS.
- COORDINATE WITH PLUMBING AND MECHANICAL CONTRACTORS FOR LOCATIONS AND QUANTITIES OF WALL WORK PENETRATIONS. (I.E. VENTS, FLUES, STACKS, ETC.)
- REMOVE ALL DEBRIS FROM ROOF SURFACES, DRAINS, AND GUTTERS. ROOF A AND B TO RECEIVE FACTORY APPLIED WHITE REFLECTIVE COATING IN AREAS UNDER EXTENSIVE VEGETATIVE TRAY SYSTEM. THIS COATING MAY BE OMITTED IF CONTRACTOR CAN DEMONSTRATE CLEARLY THAT COATING HAS INDEED BEEN INSTALLED AT REQUIRED AREAS. FIELD TOUCH-UP ALL MARRED AREAS OF THE COATING. THIS INCLUDES AREAS MARRED BY ASPHALT.
- EXIST'G ROOFING SYSTEM @ ROOF'S C&D IS UNDER WARRANTY. PERFORM ALL WORK IN STRICT ACCORDANCE W/ WARRANTIES MANUFACTURER'S ROOMS.
- FOR ALL WORK TAKING PLACE IN ROOF AREA C & D, PROTECTION OF 2" (AT MIN.) PLYWD OVER 1" CRUSHABLE INSULATION, WORK TRAFFIC AND MATERIAL STORAGE IS PROHIBITED ON UNPROTECTED ROOF SURFACE.
- ALL PREFABRICATED ROOF ACCESSORIES INCLUDING CURBS, ISOLATORS, ETC. ARE TO BE DESIGNED TO ACCOMMODATE THE 1 1/2" SLOPED DECK.
- THE PURPOSE OF THE CHANGE IN INSULATION HEIGHT AT ROOF 'A' AND THE MECHANICAL AREA IS TO ENSURE THAT THE FINAL FINISH ROOF SURFACE IS FLUSH WITH NO STEPS OR CHANGES IN LEVEL BETWEEN ROOF AREAS.
- FILL ALL CELLULAR DECK FLUTES EXPOSED WITH THE RUNNING PIPES OR WITH STRUCTURAL PENETRATIONS THROUGH THE DECK TO REDUCE THERMAL BRIDGING.

ROOF AREAS


ROOF AREA 'A'	SLOPED STRUCTURE ACHIEVES INDICATED SLOPE WITH NON-TAPERED INSULATION.
ROOF AREA 'B'	LEVEL DECK WITH TAPERED INSULATION TO ACHIEVE INDICATED SLOPE.
ROOF AREA 'C'	EXISTING TO REMAIN
ROOF AREA 'D'	EXISTING TO REMAIN
MECHANICAL AREA	SEE ROOF PLAN SYMBOLS 'AREA UNDER MECHANICAL'

ENVIRONMENTAL NOTE:

WARNING: LEAD-BASED PAINT MAY BE PRESENT WITHIN THE BUILDING. IT IS THE RESPONSIBILITY OF THE CONTRACTOR TO TAKE APPROPRIATE SAFETY MEASURES IN ACCORDANCE WITH APPLICABLE FEDERAL, STATE, AND LOCAL RULES AND REGULATIONS INCLUDING OSHA (1926.52). FILL ALL CELLULAR DECK FLUTES EXPOSED WITH THE RUNNING PIPES OR WITH SURFACES CONTAINING LEAD-BASED PAINT SHALL BE DONE IN ACCORDANCE WITH SECTION 02 08 19.13.

ROOF PLAN SYMBOLS KEY

	VEGETATIVE ROOF. SEE LANDSCAPE DRAWINGS
	ROOF AND OVERFLOW DRAIN
	MECHANICAL EXHAUST FAN. REFERENCE MECH DRAWINGS FOR EQUIPMENT. SIZE CURB TO ACCOMMODATE EQUIP. SEE 02/A7.5
	MECHANICAL EQUIPMENT ON ISOLATOR RAIL CURBS W/ ASSOC. PIPING.
	ROOF HATCH WITH CRICKET
	2' X 2' ROOF WALKING PAD
	ROOF LADDER OVER PARAPET WALL
	PV = VENT THROUGH ROOF
	AREA OF CONCRETE BELOW ROOF MEMBRANE. REFERENCE STRUCTURAL DRAWINGS AND 6/A7.4. "AREA UNDER MECHANICAL"
	ROOF HYDRANT
	PIPING AND ATTACHMENTS MOUNTED TO THE UNDERSIDE OF THE DECK TO BE MOUNTED WITH RESILIENT HANGERS IN THIS AREA, A 30" DISTANCE FROM THE ROOF TOP CHILLER.
	CURB FOR MECHANICAL FLUES. REF. 04/A7.5 COORDINATE CURB SIZE WITH PIPING. SEE MECHANICAL DRAWINGS.

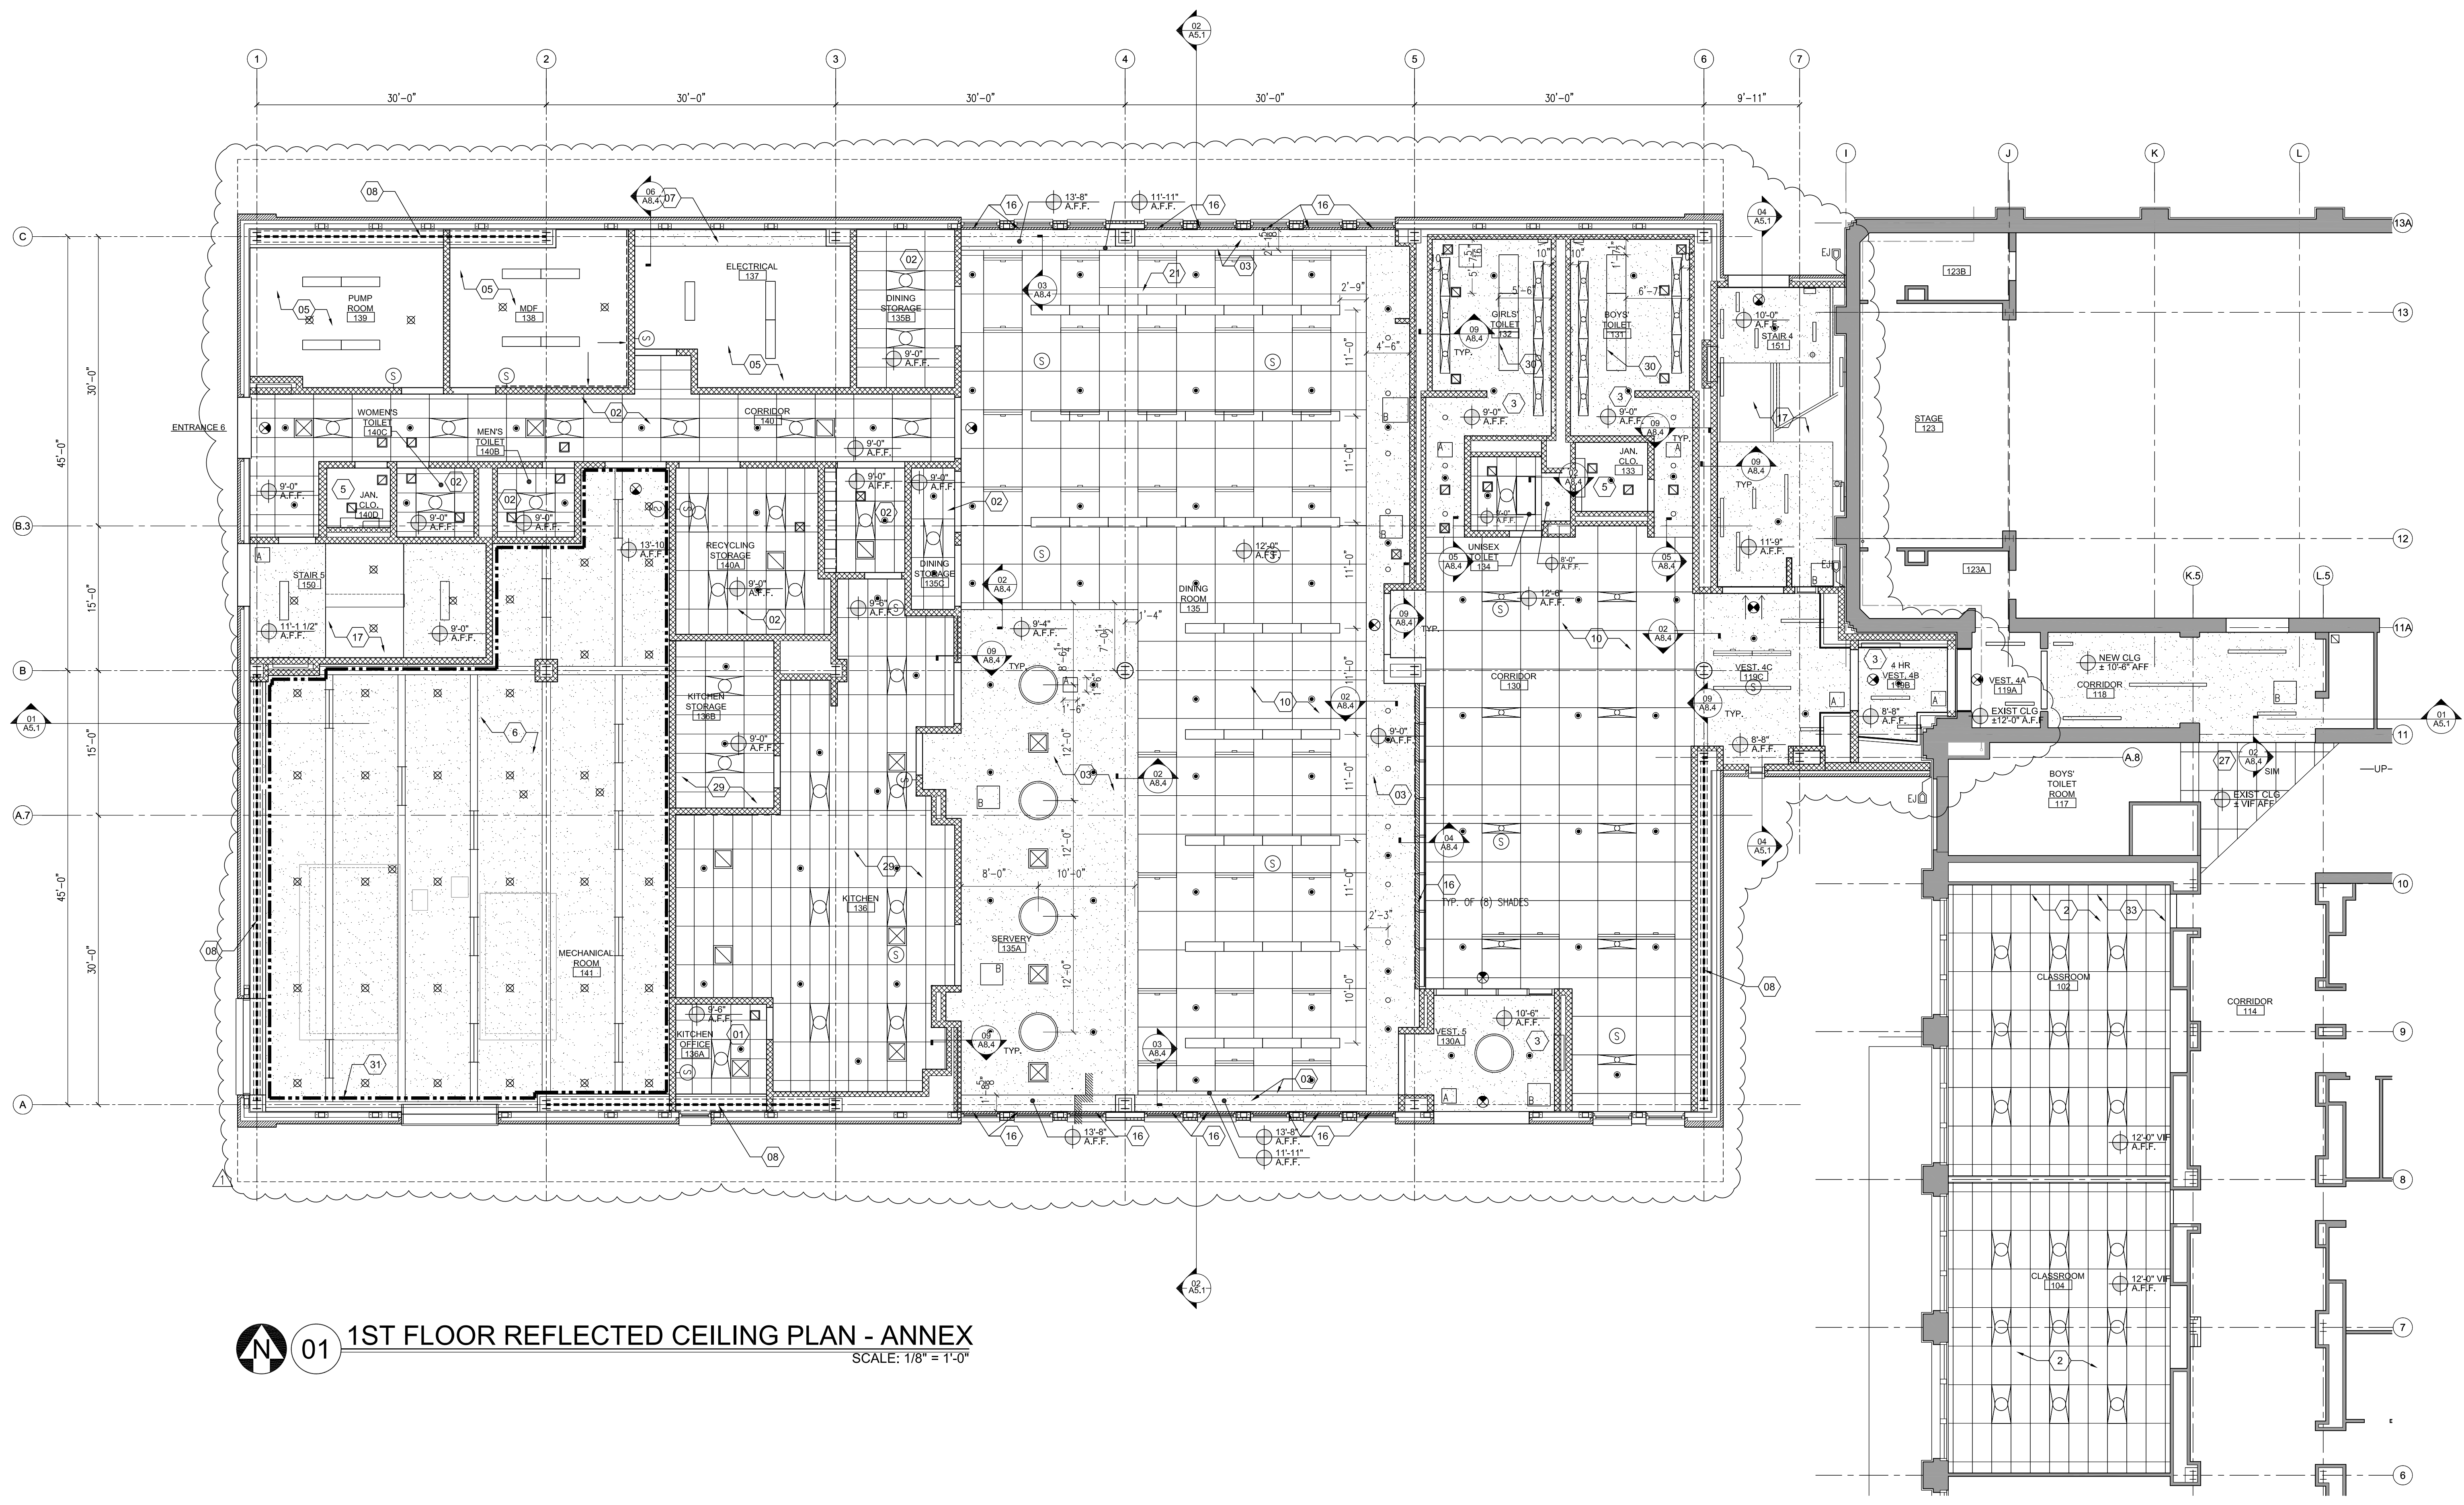

01 1ST FLOOR REFLECTED CEILING PLAN - ANNEX
SCALE: 1/8" = 1'-0"

- ### CEILING KEYNOTE LEGEND
- 2'x2' SUSPENDED ACOUSTICAL CEILING TYPE 'A' ON 9/16" GRID
 - 2'x4' SUSPENDED ACOUSTICAL CEILING TYPE 'B' ON 9/16" GRID
 - GYP-SUM BOARD CEILING/SOFFIT PAINTED (PT-1) UNO.
 - EXPOSED STEEL LINTEL PAINTED (PT-1)
 - EXPOSED CONSTRUCTION-NOT PAINTED (SPRAY-APPLIED FIREPROOFING WHERE REQUIRED)
 - MECHANICAL ROOM CEILING-(2) LAYERS 5/8" GYP BOARD W/ OVERLAPPING JOINTS, SUSPENDED FROM COMPOSITE METAL DECK FROM VIBRATION ISOLATORS, COVERED W/ 2" THICK SPRAY APPLIED ACOUSTICAL SOUND ABSORPTION MATERIAL. SEAL ALL PENETRATIONS W/ ACOUSTIC SEALANT. SEE 5/A7.2
 - ENCLOSE DUCTS IN ELECTRICAL ROOM W/ 2HR SFFIT, UL1467. SEE DETAIL 6/A8.4.
 - LATERAL BRACING
 - PAINTED EXPOSED STRUCTURE, DECK, DUCTWORK, PIPING, CONDUIT, ETC. (PT-1)
 - 4'x4' ACOUSTICAL CEILING TYPE 'D' ON 1/2" GRID
 - GYP-SUM BOARD SOFFIT PTD. ACCENT COLOR; MARCH ADJ. WALL (SEE INT. ELEV. + FIN PLANS)
 - 2" HIGH PREFIN. EXTRUDED ALUM. EDGE SUSPENSION TRIM
 - PTD. EXPOSED STRUCTURE, DECK DUCTWORK, PIPING, CONDUIT, ETC. (ACCENT COLOR)
 - 2" PREFINISHED REVEAL TRIM, FRY-RELET DRAW-625-625 (BASIS OF DESIGN)
 - MASONRY LINTEL PAINTED TO MATCH ADJ. WALL COLOR
 - MOTORIZED WINDOW SHADE
 - PAINTED EXPOSED STAIR STRUCTURE, INCL. CHANNELS, PAN, BEAMS, PLATES, CONNECTIONS, GUARDRAILS, & ASSOC. ELEMENTS
 - GYP. BO. CEILING CONTROL JOINT W/CONT. 2" PREFIN. ALUM. REVEAL TO MATCH PANEL COLOR
 - CONTROL JOINT
 - SGT. LINTEL COORD. W/STRUCTURAL
 - 12'x9' MOTORIZED PROJECTION SCREEN
 - EXPOSED STRUCTURE PAINTED WITH INTUMESCENT PAINT FOR 1-HR RATING
 - SUSPENDED CLG. THERMAL EXPANSION JOINT REF. SET #1/A8.3
 - 4 HR SHFT WALL CEILING, PARTITION TO UNDERSIDE OF SHFT WALL CEILING AND FIRE SEAF.
 - WATER RESISTANT GYP-SUM BOARD CEILING PAINTED PT-1
 - MANUAL ROLLER SHADE AND FASCIA
 - EXISTING CEILING GRID TO REMAIN, PROTECT/SHORE/ADJUST WHEN IMPACTED BY WORK
 - ACOUSTIC CELLULAR ROOF DECK WITH SOUND ABSORB. MTRL. WITH MIN. NRC 0.95
 - 2'x4' SUSPENDED CEILING TYPE 'C'
 - SUSP. RECESSED PREFIN. RADIANT PANEL, COORD. LOCATION W/ MECH.
 - PIPING AND ATTACHMENTS TO THE DECK IN THIS AREA ARE REQUIRED TO BE MOUNTED WITH RESILIENT HANGERS.
 - ACOUSTIC TILE CEILING AND GRID AT 9'-0" A.F.F.
 - SUSP. CEILING TO BE INSTALLED AT SAME HEIGHT OF EXISTING CEILING TO BE REMOVED.

- ### CEILING SYMBOLS KEY
- 9'-0" A.F.F. CEILING HEIGHT
 - THRU WALL VERTICAL BUILDING EXPANSION JOINT, 2" (OR GREATER) WIDTH. CONTINUOUS FOR BUILDING ENVELOPE SEAL AT NEW TO EXISTING BUILDING JUNCTION. SEE DETAIL 08/A7.1
 - 2'x4' LAY-IN/RECESSED FLUORESCENT FIXTURE (SEE ELECTRICAL DWGS)
 - 1'x4' RECESSED FLUORESCENT FIXTURE (SEE ELECTRICAL DWGS)
 - SUSPENDED FLUORESCENT FIXTURE (SEE ELECTRICAL DWGS)
 - 1"x4, 6, 8, LINEAR FLUORESCENT LIGHT, RECESSED WALL TO CEILING, SEE INTERIOR ELEVATIONS FOR MORE INFO. (SEE ELECTRICAL DWGS)
 - 1'x4' FLUORESCENT FIXTURE (SEE ELECTRICAL DWGS)
 - CLG MTD SINGLE FACE EXIT SIGN (SEE ELECTRICAL DWGS)
 - CLG MTD DOUBLE FACE EXIT SIGN (SEE ELECTRICAL DWGS)
 - RECESSED FLUORESCENT FIXTURE (SEE ELECTRICAL DWGS)
 - RECESSED FIXTURE W/ ROUND TRIM (SEE ELECTRICAL DWGS)
 - WALL MTD LIGHT (SEE ELECTRICAL DWGS)
 - EMERGENCY LIGHTING UNIT (SEE ELECTRICAL DWGS)
 - RETURN AIR DIFFUSER (SEE MECHANICAL DWGS)
 - SUPPLY AIR DIFFUSER (SEE MECHANICAL DWGS)
 - ACCESS PANEL (COORD. W/ MECH., ELEC., PLUMBING WORK) X REFERS TO SIZE/TYP. SEE SCHEDULES THIS SHEET.
 - SUPPLY SLOT DIFFUSER (SEE MECHANICAL DWGS) COORD. FINAL LOCATION W/ ARCHITECT.
 - SPRINKLER HEAD (SEE F.P. DWGS)
 - CLG MTD SPEAKER (SEE ELECTRICAL DWGS)
 - WALL MTD SPEAKER (SEE ELECTRICAL DWGS)
 - SMOKE DETECTOR (SEE ELECTRICAL DWGS)
 - GYP-SUM BOARD CLG (PAINTED, SEE FINISH LEGEND SHEET A12.3)
 - WINDOW SHADES AND PREFIN. HOUSING
 - RECESSED RADIANT CLG. PANEL
 - SUSPENDED/CEILING MOUNTED PROJECTION MOUNT
 - CEILING FAN (SEE ELEC. DRAWINGS FOR REQUIREMENTS)
 - PIPING AND ATTACHMENTS TO THE DECK IN THIS AREA ARE REQUIRED TO BE MOUNTED WITH RESILIENT HANGERS.
 - CHANGE IN ELEVATION

ACCESS PANEL SCHEDULE

TYPE	DIMENSIONS	FRAMED	FRAMELESS	FLUSH	RECESSED
A	18"x18"	X		X	
B	28"x28"	X		X	
C	12"x12"	X		X	
AP-0	28"x28"	X		X	

- ### GENERAL CEILING NOTES
- ALL CEILING GRIDS SHALL BE CENTERED IN ROOMS UNLESS NOTED OTHERWISE.
 - ALL LIGHT FIXTURES AND DIFFUSERS SHALL BE CENTERED ON THE TILE UNLESS NOTED OTHERWISE.
 - ALL SPRINKLER HEADS SHALL BE CENTERED ON 2'x2" SCOPE OF 2'x4' GRID UNLESS NOTED OTHERWISE. SPRINKLER PACKAGE IS DESIGN-BUILT BY CONTRACTOR; THE LOCATION OF HEADS IS INDICATED FOR INFORMATION ONLY. THE ACTUAL NUMBER AND EXACT LOCATION OF HEADS MAY VARY. THE CONTRACTOR SHALL COORDINATE THE FOLLOWING:
 - A) THE LOCATION OF HEADS IN LAY-IN CEILING TILES SHALL BE CENTERED WITHIN 2'x2" SCOPE OF 2'x4' TILES UNO.
 - B) ALL SPRINKLER MAINS AND BRANCH PIPING SHALL RUN UNEXPOSED TO VIEW EXCEPT IN ROOMS WITHOUT FINISHED CEILING.
 - C) ALL EXPOSED SPRINKLER PIPING SHALL BE PAINTED TO MATCH CEILING COLOR, IN ROOMS DESIGNATED WITHOUT PAINTED CEILING, SPRINKLER BRANCH-PIPING PAINT COLOR SHALL BE SELECTED BY ARCHITECT.
 - ALL ROUND COLUMNS SHALL RECEIVE ROUND CEILING GRID TRIM.
 - ALL GYP-SUM BOARD SOFFITS SHALL HAVE 5/8" REVEAL EDGE AT ADJACENT PARTITIONS EXCEPT WHERE REQUIRED TO BE FIRE-RATED.
 - COORDINATE SPRAY FIREPROOFING REQUIREMENTS WITH CODE MATRIX, LIFE SAFETY PLANS, WALL SECTIONS, AND SPECIFICATIONS.
 - CONTRACTOR TO COORDINATE LOCATION OF PLUMBING AND MECH. VALVES, TRANSFORMERS AND ABOVE-CEILING COMPONENTS WITH LOCATIONS OF CEILING ACCESS PANELS IN GYP. BO. CEILING AREAS.
 - EXPOSED EXTERIOR FERROUS METAL SHALL BE HOT-DIPPED GALVANIZED, WHERE EXPOSED TO VIEW STEEL SHALL BE PREPARED, PRIMED, AND PAINTED WITH HIGH PERFORMANCE PAINT COATING IN ACCORDANCE WITH SPECIFICATIONS SECTION 09110 UNO.
 - REFER TO MECHANICAL, PLUMBING, FIRE PROTECTION, AND ELECTRICAL DRAWINGS FOR ADDITIONAL INFORMATION.
 - THE MECHANICAL ROOM CEILING SYSTEM AN ACOUSTICAL BARRIER. ALL PENETRATIONS MUST BE ACOUSTICALLY SEALED AS NOTED.

ENVIRONMENTAL NOTE:
WARNING: LEAD-BASED PAINT MAY BE PRESENT WITHIN THE BUILDING. IT IS THE RESPONSIBILITY OF THE CONTRACTOR TO TAKE APPROPRIATE SAFETY MEASURES IN ACCORDANCE WITH APPLICABLE FEDERAL, STATE, AND LOCAL RULES AND REGULATIONS INCLUDING OSHA 1926.62) COMPLIANCE. MUST CHARACTERIZATION AND WASTE DISPOSAL. ALL WORK WITH SURFACES CONTAINING LEAD-BASED PAINT SHALL BE DONE IN ACCORDANCE WITH SECTION 02 10 13.

CHICAGO

BUILDING SCHOOLS

ACROSS CHICAGO

CHICAGO PUBLIC SCHOOLS

CPS

EDISON PARK ELEMENTARY SCHOOL ANNEX

6220 N. OLCOTT AVE
CHICAGO, IL 60631

CHICAGO PUBLIC SCHOOLS

CITY OF CHICAGO, MAYOR RAHIM EMANUEL

THESE DRAWINGS HAVE BEEN PREPARED AT AND/OR UNDER MY SUPERVISION AND TO THE BEST OF MY KNOWLEDGE AND BELIEF CONFORM AND COMPLY WITH THE REQUIREMENTS OF THE CHICAGO DEPARTMENT OF BUILDING.

ILLINOIS
JAMES M. O'DONNELL
REGISTERED ARCHITECT
001-016351
EXPIRATION DATE: NOVEMBER 30, 2014

TRIPARTITE, INC.
Architecture Restoration Design
4720 N. Virginia Ave.
Chicago, Illinois 60625
P: 773-581-0894
www.tripartiteinc.com

MATRIX ENGINEERING CORPORATION
3318 N. JACKSON BLVD., 4TH FLOOR / CHICAGO, IL 60654
STRUCTURAL ENGINEERING

SITE DESIGN GROUP, LTD.
188 S. MICHIGAN AVE., SUITE 1000 / CHICAGO, IL 60605
LANDSCAPE DESIGN

TERRA ENGINEERING, LTD.
225 W. OHIO STREET, 4TH FLOOR / CHICAGO, IL 60604
CIVIL ENGINEERING

CALOR DESIGN GROUP, LTD.
2017 N. WESTERN AVE. / CHICAGO, IL 60647
MECHANICAL, PLUMBING, FIRE PROTECTION

TECHKNOW ENGINEERING, LLC
1816 S. MICHIGAN AVE., SUITE 1000 / CHICAGO, IL 60605
QUALITY CONTROL, LOW VOLTAGE, SECURITY, FIRE ALARM

HJ KESSLER ASSOCIATES
1860 N. LAKE SHORE DRIVE, SUITE 501 / CHICAGO, IL 60613
LEED CONSULTING

EDGE ASSOCIATES, INC.
200 S. LAKE STREET, SUITE 300 / ABBOTTSVILLE, IL 60101
FOOD SERVICES

DOOR SECURITY SOLUTIONS
114 KOSTER AVE., HENNEBELLE, IL 60150
HARDWARE CONSULTANT

PIN DROP ACOUSTICS
2017 N. LAKE STREET, #100 / CHICAGO, IL 60606
ACOUSTIC CONSULTANT

ISSUANCE


MARK	DESCRIPTION	DATE
1	ISSUE FOR BID	12-18-2012
2	ADDENDUM 1	01-17-2013
3	----	----
4	----	----
5	----	----
6	----	----
7	----	----
8	----	----

SCALE: AS NOTED
PLOT DATE: 1/17/2013
PBC PROJECT NAME: EDISON PARK ELEMENTARY SCHOOL ANNEX
PROJECT NO.: 05650
PBC CONTRACT NO.: -
PROJECT NO.: 05650

WARNING:
ASBESTOS-CONTAINING BUILDING MATERIALS ARE OR MAY BE PRESENT IN THIS BUILDING. AN ASBESTOS MANAGEMENT PLAN IS AVAILABLE IN THE SCHOOL. FOR REVIEW UPON REQUEST. NO PERSON MAY REMOVE OR DESTROY ASBESTOS-CONTAINING MATERIALS UNLESS THAT PERSON IS A LICENSED ASBESTOS WORKER OR CONTRACTOR WHO IS IN ACCORDANCE WITH THE PROJECT DOCUMENTS AND IN COMPLIANCE WITH ILLINOIS DEPARTMENT OF HEALTH RULES AND REGULATIONS.

TITLE:
1ST FLOOR REFLECTED CEILING PLAN

SHEET **A3.1**

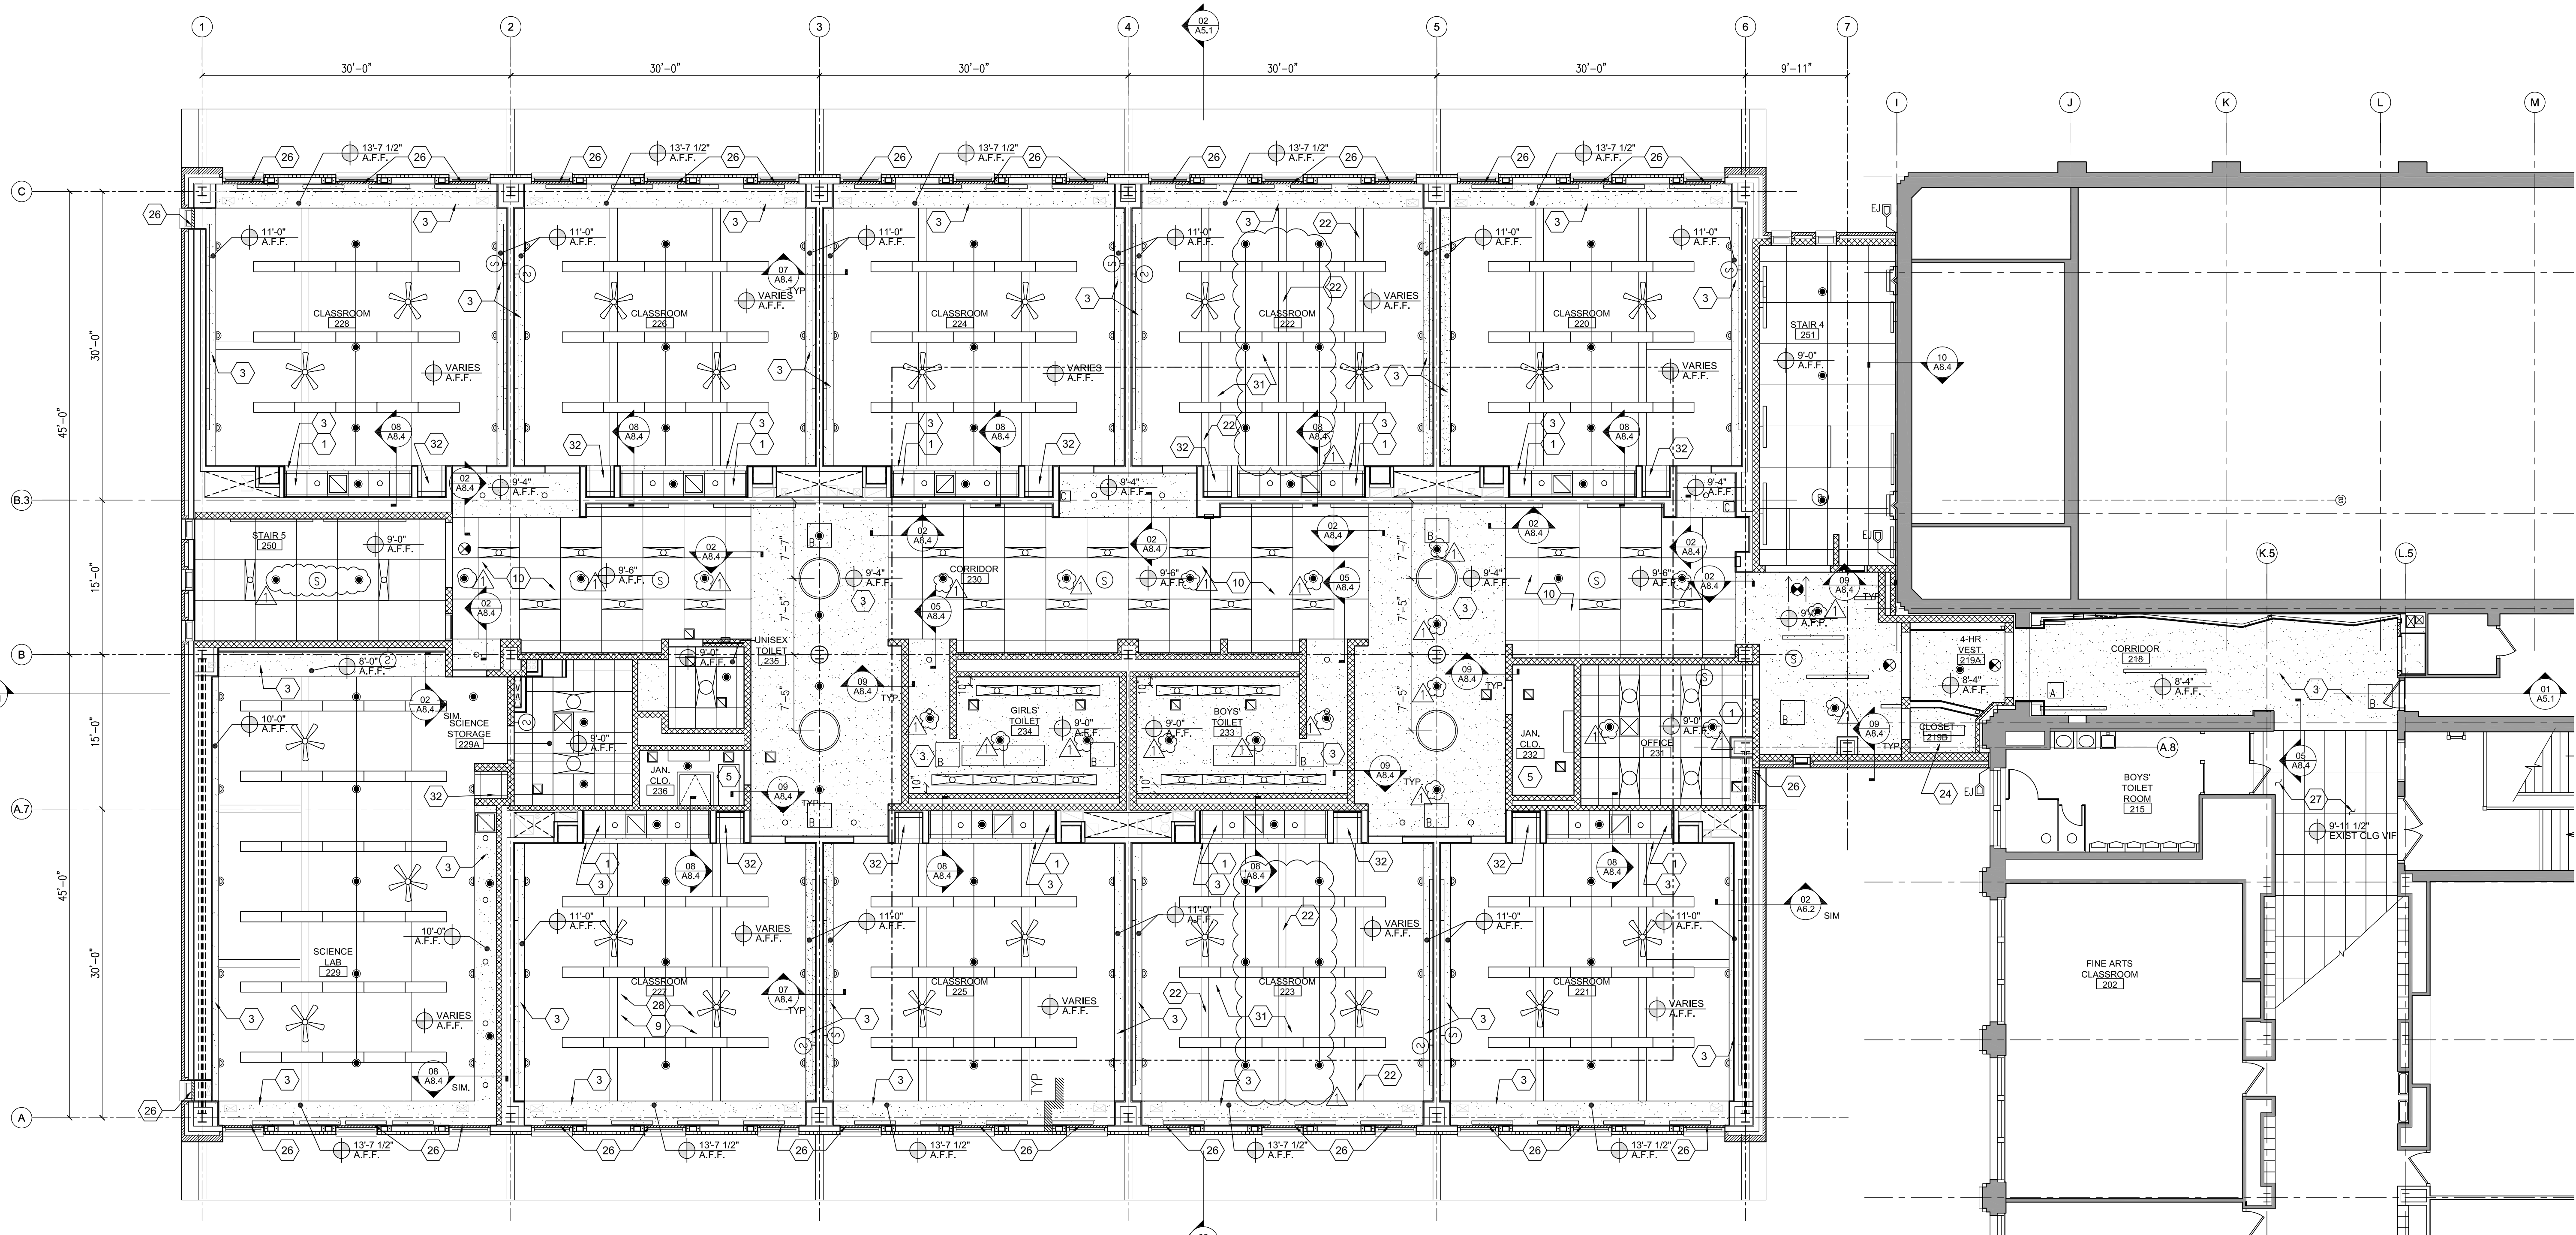

01 2ND FLOOR REFLECTED CEILING PLAN - ANNEX
SCALE: 1/8" = 1'-0"

ACCESS PANEL SCHEDULE

TYPE	DIMENSIONS	FRAMED	FRAMELESS	FLUSH	RECESSED
A	18"x18"	X	X	X	
B	28"x28"	X	X	X	
C	12"x12"	X	X	X	
AP-D	28"x28"	X		X	

NOTE: COORDINATE FINAL LOCATIONS WITH PLUMBING AND MECHANICAL WORK.

- GENERAL CEILING NOTES**
- ALL CEILING GRIDS SHALL BE CENTERED IN ROOMS UNLESS NOTED OTHERWISE.
 - ALL LIGHT FIXTURES AND DIFFUSERS SHALL BE CENTERED ON THE TILE UNLESS NOTED OTHERWISE.
 - ALL SPRINKLER HEADS SHALL BE CENTERED ON 2'X2' SCORE OF 2'X4' GRID UNLESS NOTED OTHERWISE. SPRINKLER PACKAGE IS DESIGN-BUILD BY CONTRACTOR; THE LOCATION OF HEADS IS INDICATED FOR INFORMATION ONLY. THE ACTUAL NUMBER AND EXACT LOCATION OF HEADS MAY VARY; THE CONTRACTOR SHALL COORDINATE THE FOLLOWING:
 - A) THE LOCATION OF HEADS IN LAY-IN CEILING TILES SHALL BE CENTERED WITHIN 2'X2' SCOPE OF 2'X4' TILES U.N.O.
 - B) ALL SPRINKLER MAINS AND BRANCH PIPING SHALL RUN UNEXPOSED TO VIEW EXCEPT IN ROOMS WITHOUT FINISHED CEILINGS.
 - C) ALL EXPOSED SPRINKLER PIPING SHALL BE PAINTED TO MATCH CEILING COLOR. IN ROOMS DESIGNATED WITHOUT PAINTED CEILING, SPRINKLER BRANCH-PIPING PAINT COLOR SHALL BE SELECTED BY ARCHITECT.
 - ALL ROUND COLUMNS SHALL RECEIVE ROUND CEILING GRID TRIM.
 - ALL GYPSUM BOARD SOFFITS SHALL HAVE 5/8" REVEAL EDGE AT ADJACENT PARTITIONS EXCEPT WHERE REQUIRED TO BE FIRE-RATED.
 - COORDINATE SPRAY FIREPROOFING REQUIREMENTS WITH CODE MATRIX, LIFE SAFETY PLANS, WALL SECTIONS, AND SPECIFICATIONS.
 - CONTRACTOR TO COORDINATE LOCATION OF PLUMBING AND MECH. VALVES, TRANSFORMERS AND ABOVE-CEILING COMPONENTS WITH LOCATIONS OF CEILING ACCESS PANELS IN GYP. BD. CEILING AREAS.
 - EXPOSED EXTERIOR FERROUS METAL SHALL BE HOT-DIPPED GALVANIZED, WHERE EXPOSED TO VIEW STEEL SHALL BE PREPARED, PRIMED, AND PAINTED WITH HIGH PERFORMANCE PAINT COATING IN ACCORDANCE WITH SPECIFICATIONS SECTION 09110 U.N.O.
 - REFER TO MECHANICAL, PLUMBING, FIRE PROTECTION, AND ELECTRICAL DRAWINGS FOR ADDITIONAL INFORMATION.
 - THE MECHANICAL ROOM CEILING SYSTEM AN ACOUSTICAL BARRIER. ALL PENETRATIONS MUST BE ACOUSTICALLY SEALED AS NOTED. THE DUCTS, CONDUITS, PIPING, ETC. ARE TO BE RUN BELOW THE ACOUSTICAL BARRIER. REFERENCE DETAILS.

- CEILING KEYNOTE LEGEND**
- 2'X2' SUSPENDED ACOUSTICAL CEILING TYPE 'A' ON 9/16" GRID
 - 2'X4' SUSPENDED ACOUSTICAL CEILING TYPE 'B' ON 9/16" GRID
 - GYPSUM BOARD CEILING/SOFFIT PAINTED (PT-1) U.N.O.
 - EXPOSED STEEL LINTEL PAINTED (PT-1)
 - EXPOSED CONSTRUCTION-NOT PAINTED (SPRAY-APPLIED FIREPROOFING WHERE REQUIRED)
 - MECHANICAL ROOM CEILING-(2) LAYERS 5/8" GYP BOARD W/ OVERLAPPING JOINTS, SUSPENDED FROM COMPOSITE METAL DECK FROM VIBRATION ISOLATORS, COVERED W/ 2" THICK SPRAY APPLIED ACOUSTICAL SOUND ABSORPTION MATERIAL. SEAL ALL PENETRATIONS W/ ACOUSTIC SEALANT. SEE S/AT.2
 - ENCLOSE DUCTS IN ELECTRICAL ROOM W/ 2HR SOFFIT, UL#467. SEE DETAIL 6/AB.4.
 - LATERAL BRACING
 - PAINTED EXPOSED STRUCTURE, DECK, DUCTWORK, PIPING, CONDUIT, ETC. (PT-1)
 - 4'X4' ACOUSTICAL CEILING TYPE 'D' ON 1/2" GRID
 - GYPSUM BOARD SOFFIT PTD. ACCENT COLOR; MARCH ADJ. WALL (SEE INT. ELEV. + FIN PLANS)
 - 2" HIGH PREFIN. EXTRUDED ALUM EDGE SUSPENSION TRIM
 - PTD. EXPOSED STRUCTURE, DECK DUCTWORK, PIPING, CONDUIT, ETC. (ACCENT COLOR)
 - 8" PREFINISHED REVEAL TRIM. FRY-REGLT DRAW-625-625 (BASIS OF DESIGN)
 - MASONRY LINTEL PAINTED TO MATCH ADJ. WALL COLOR
 - MOTORIZED WINDOW SHADE
 - PAINTED EXPOSED STAIR STRUCTURE, INCL. CHANNELS, PAN, BEAMS, PLATES, CONNECTIONS, GUARDRAILS, & ASSOC. ELEMENTS
 - GYP. BD. CEILING CONTROL JOINT W/CONT. 1" PREFIN. ALUM. REVEAL TO MATCH PAINT COLOR
 - CONTROL JOINT
 - SGT. LINTEL COORD. W/STRUCTURAL
 - 12'X9" MOTORIZED PROJECTION SCREEN
 - EXPOSED STRUCTURE PAINTED WITH INTUMESCENT PAINT FOR 1-HR RATING
 - SUSPENDED CLG. THERMAL EXPANSION JOINT REF. DET. #1/AB.3
 - 4-HR SHFT WALL CEILING. PARTITION TO UNDERSIDE OF SHFT WALL CEILING AND FIRE SAFED.
 - WATER RESISTANT GYPSUM BOARD CEILING PAINTED PT-1
 - MANUAL ROLLER SHADE AND FASCIA
 - EXISTING CEILING GRID TO REMAIN. PROTECT/SHORE/ADJUST WHEN IMPACTED BY WORK
 - ACOUSTIC CELLULAR ROOF DECK WITH SOUND ABSORB. WTL. WITH MIN. NRC 0.95
 - 2'X4' SUSPENDED CEILING TYPE 'C'
 - SUSP. RECESSED PREFIN. RADIANT PANEL. COORD. LOCATION W/ MECH.
 - PIPING AND ATTACHMENTS TO THE DECK IN THIS AREA ARE REQUIRED TO BE MOUNTED WITH RESILIENT HANGERS.
 - ACOUSTIC TILE CEILING AND GRID AT 9'-0" A.F.F.
 - NEW CEILING TO BE INSTALLED AT SAME HEIGHT OF EXISTING CEILING TO BE REMOVED.

- CEILING SYMBOLS KEY**
- 9'-0" A.F.F. CEILING HEIGHT
 - THRU WALL VERTICAL BUILDING EXPANSION JOINT. 2" (OR GREATER) WIDTH. CONTINUOUS FOR BUILDING ENVELOPE SEAL AT NEW TO EXISTING BUILDING JUNCTION. SEE DETAIL 08/AT.1
 - 2'X4' LAY-IN/RECESSED FLUORESCENT FIXTURE (SEE ELECTRICAL DWGS)
 - 1'X4' RECESSED FLUORESCENT FIXTURE (SEE ELECTRICAL DWGS)
 - SUSPENDED FLUORESCENT FIXTURE (SEE ELECTRICAL DWGS)
 - 1x4, 6, 8, LINEAR FLUORESCENT LIGHT, RECESSED WALL TO CEILING, SEE INTERIOR ELEVATIONS FOR MORE INFO. (SEE ELECTRICAL DWGS)
 - 1'X4' FLUORESCENT FIXTURE (SEE ELECTRICAL DWGS)
 - CLG MTD SINGLE FACE EXIT SIGN (SEE ELECTRICAL DWGS)
 - CLG MTD DOUBLE FACE EXIT SIGN (SEE ELECTRICAL DWGS)
 - RECESSED FLORESCENT FIXTURE (SEE ELECTRICAL DWGS)
 - RECESSED FIXTURE W/ ROUND TRIM (SEE ELECTRICAL DWGS)
 - WALL MTD LIGHT (SEE ELECTRICAL DWGS)
 - EMERGENCY LIGHTING UNIT (SEE ELECTRICAL DWGS)
 - RETURN AIR DIFFUSER (SEE MECHANICAL DWGS)
 - SUPPLY AIR DIFFUSER (SEE MECHANICAL DWGS)
 - ACCESS PANEL (COORD. W/ MECH., ELEC., PLUMBING WORK) X REFERS TO SIZE/TYPE. SEE SCHEDULES SHEET.
 - SUPPLY SLOT DIFFUSER (SEE MECHANICAL DWGS) COORD. FINAL LOCATION W/ ARCHITECT.
 - SPRINKLER HEAD (SEE F.P. DWGS)
 - CLG MTD SPEAKER (SEE ELECTRICAL DWGS)
 - WALL MTD SPEAKER (SEE ELECTRICAL DWGS)
 - SMOKE DETECTOR (SEE ELECTRICAL DWGS)
 - GYPSUM BOARD CLG. (PAINTED, SEE FINISH LEGEND SHEET A12.3)
 - WINDOW SHADES AND PREFIN. HOUSING
 - RECESSED RADIANT CLG. PANEL
 - SUSPENDED/CEILING MOUNTED PROJECTION MOUNT
 - CEILING FAN (SEE ELEC. DRAWINGS FOR REQUIREMENTS)
 - PIPING AND ATTACHMENTS TO THE DECK IN THIS AREA ARE REQUIRED TO BE MOUNTED WITH RESILIENT HANGERS.
 - CHANGE IN ELEVATION

ISSUANCE

MARK	DESCRIPTION	DATE
1	ISSUE FOR BID	12-18-2012
2	ADDENDUM 1	01-17-2013
3	----	----
4	----	----
5	----	----
6	----	----
7	----	----
8	----	----

SCALE: AS NOTED
PLOT DATE: 1/17/2013
PROJECT NAME: EDISON PARK ELEMENTARY SCHOOL ANNEX
PROJECT NO.: 05650

ENVIRONMENTAL NOTE:
WARNING: LEAD-BASED PAINT MAY BE PRESENT WITHIN THE BUILDING. IT IS THE RESPONSIBILITY OF THE CONTRACTOR TO TAKE APPROPRIATE SAFETY MEASURES IN ACCORDANCE WITH APPLICABLE FEDERAL, STATE, AND LOCAL RULES AND REGULATIONS INCLUDING OSHA (1926.62) COMPLIANCE, WASTE CHARACTERIZATION AND WASTE DISPOSAL. ALL WORK WITH SURFACES CONTAINING LEAD-BASED PAINT SHALL BE DONE IN ACCORDANCE WITH SECTION 02 08 19.13.

CHICAGO DEPARTMENT OF BUILDING CONSTRUCTION

BUILDING SCHOOLS ACROSS CHICAGO

CHICAGO PUBLIC SCHOOLS CPS

EDISON PARK ELEMENTARY SCHOOL ANNEX

6220 N. OLCOTT AVE
CHICAGO, IL 60631

CHICAGO PUBLIC SCHOOLS
CITY OF CHICAGO, MAYOR RAHIM EMANUEL

THESE DRAWINGS HAVE BEEN PREPARED AT AND/OR UNDER MY SUPERVISION AND TO THE BEST OF MY KNOWLEDGE AND BELIEF CONFORM AND COMPLY WITH THE REQUIREMENTS OF THE CHICAGO DEPARTMENT OF BUILDING.

ILLINOIS
KATHLEEN O'DONNELL
REGISTERED ARCHITECT
001-016351
EXPIRATION DATE: NOVEMBER 30, 2014

TRIPARTITE, INC.
Architecture Restoration Design
4720 N. Virginia Ave.
Chicago, Illinois 60625
P: 773-548-4284
www.tripartiteinc.com

MATRIX ENGINEERING CORPORATION
331 N. JACKSON BLVD., 4TH FLOOR / CHICAGO, IL 60654
STRUCTURAL ENGINEERING

SITE DESIGN GROUP, LTD.
888 S. MICHIGAN AVE., SUITE 1001 / CHICAGO, IL 60605
LANDSCAPE DESIGN

TERRA ENGINEERING, LTD.
225 W. OHIO STREET, 4TH FLOOR / CHICAGO, IL 60654
CIVIL ENGINEERING

CALOR DESIGN GROUP, LTD.
2017 N. WESTERN AVE. / CHICAGO, IL 60647
MECHANICAL, PLUMBING, FIRE PROTECTION

TECHNOW ENGINEERING, LLC
106 S. ADAMS ST., SUITE 1100 / CHICAGO, IL 60603
QUALITY CONTROL, LOW VOLTAGE, SECURITY, FIRE ALARM, LEED CONSULTING

HJ KESSLER ASSOCIATES
1860 LAKE SHORE DRIVE, SUITE 501 / CHICAGO, IL 60613
LEED CONSULTING

EDGE ASSOCIATES, INC.
114 COCKER AVE., HENNEBELLE, IL 60155
FOOD SERVICES





DOOR SECURITY SOLUTIONS
HARDWARE CONSULTANT

PIN DROP ACOUSTICS
2017 N. WESTERN AVE. / CHICAGO, IL 60647
ACOUSTIC CONSULTANT

TITLE:
2ND FLOOR REFLECTED CEILING PLAN

A3.2

ENVIRONMENTAL NOTE:
WARNING: LEAD-BASED PAINT MAY BE PRESENT WITHIN THE BUILDING. IT IS THE RESPONSIBILITY OF THE CONTRACTOR TO TAKE APPROPRIATE SAFETY MEASURES IN ACCORDANCE WITH APPLICABLE FEDERAL, STATE, AND LOCAL RULES AND REGULATIONS INCLUDING OSHA (1926.62) COMPLIANCE, WASTE CHARACTERIZATION AND WASTE DISPOSAL. ALL WORK WITH SURFACES CONTAINING LEAD-BASED PAINT SHALL BE DONE IN ACCORDANCE WITH SECTION 02 08 19.13.

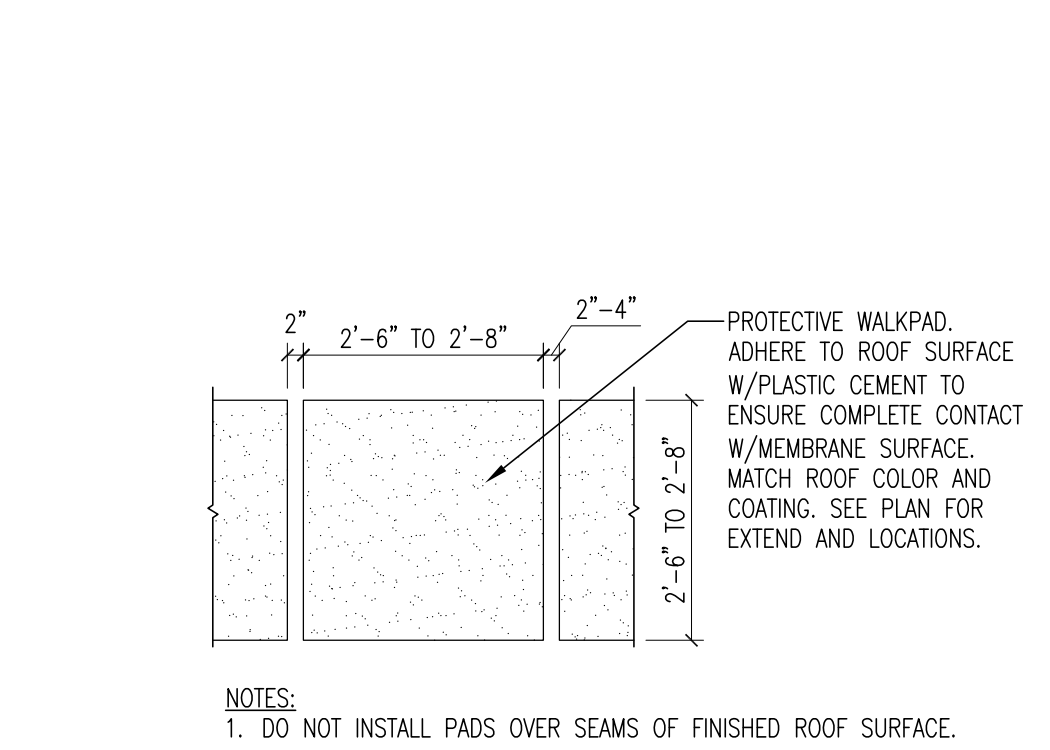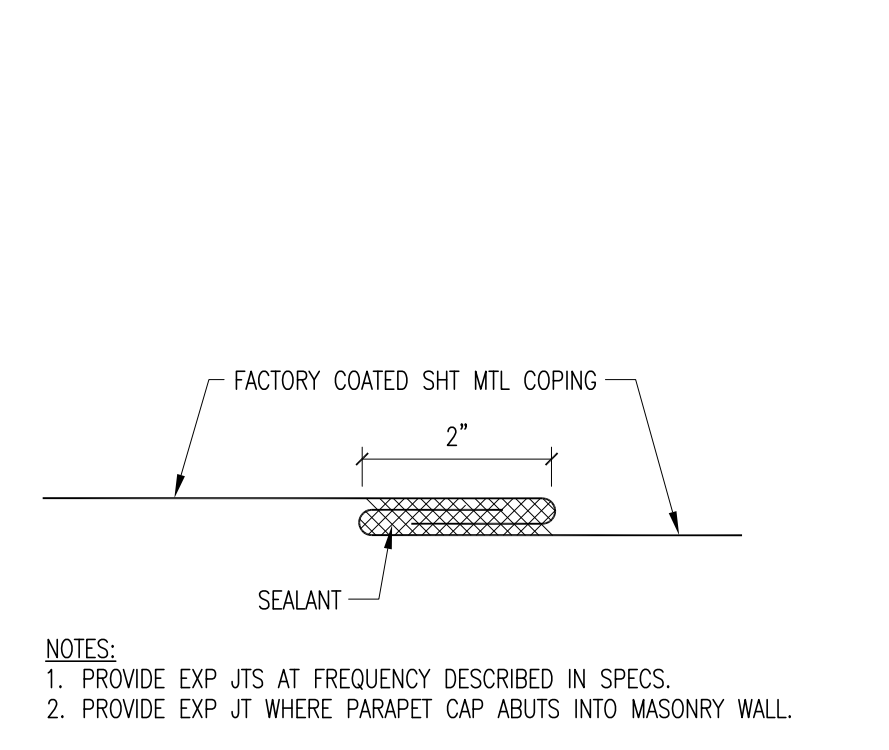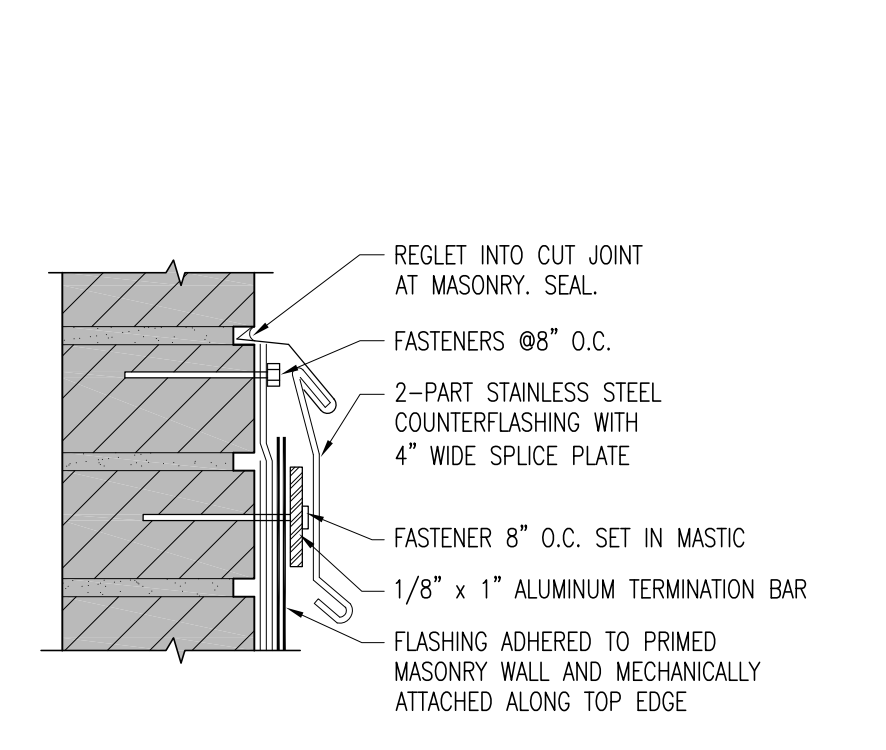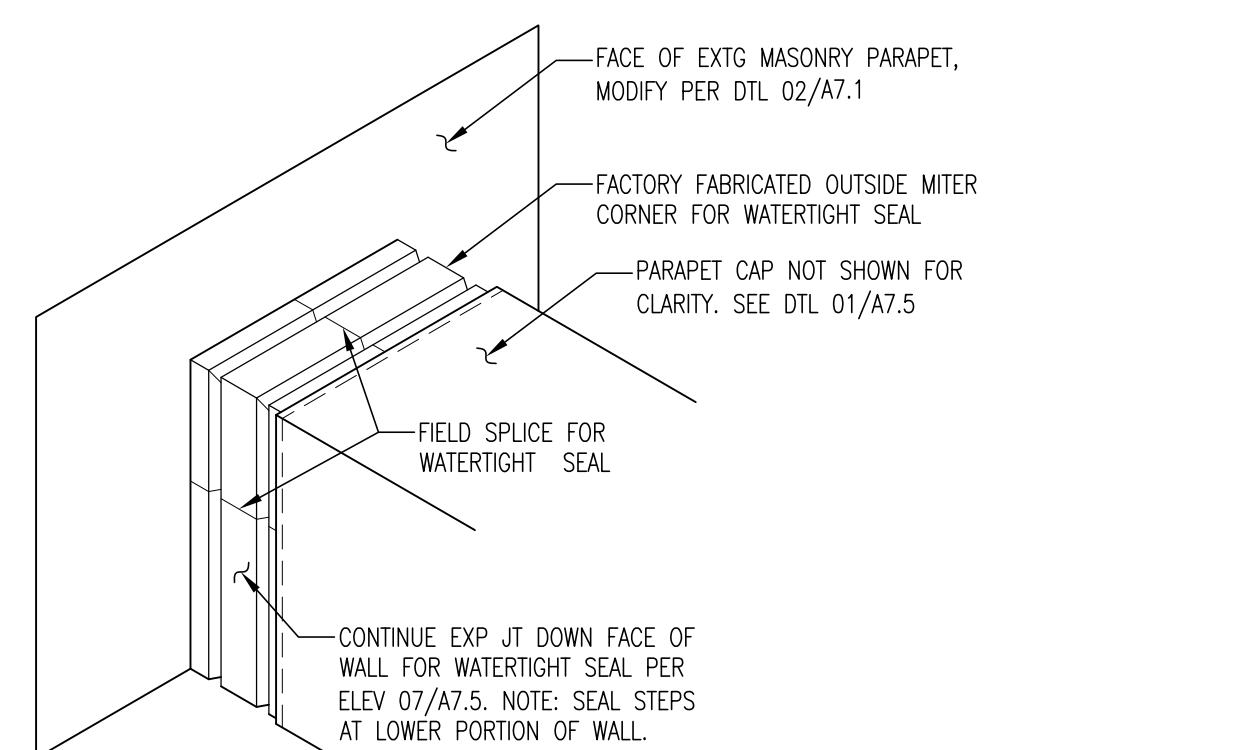


18 EXT WALL EXP JOINT MITER DIAGRAM SCALE: 1 1/2" = 1'-0"


17 COUNTER FLASHING SCALE: 3" = 1'-0"

16 FLAT LOCK EXP JOINT SCALE: 6" = 1'-0"


15 PROTECTIVE WALKPAD SCALE: 1/2" = 1'-0"

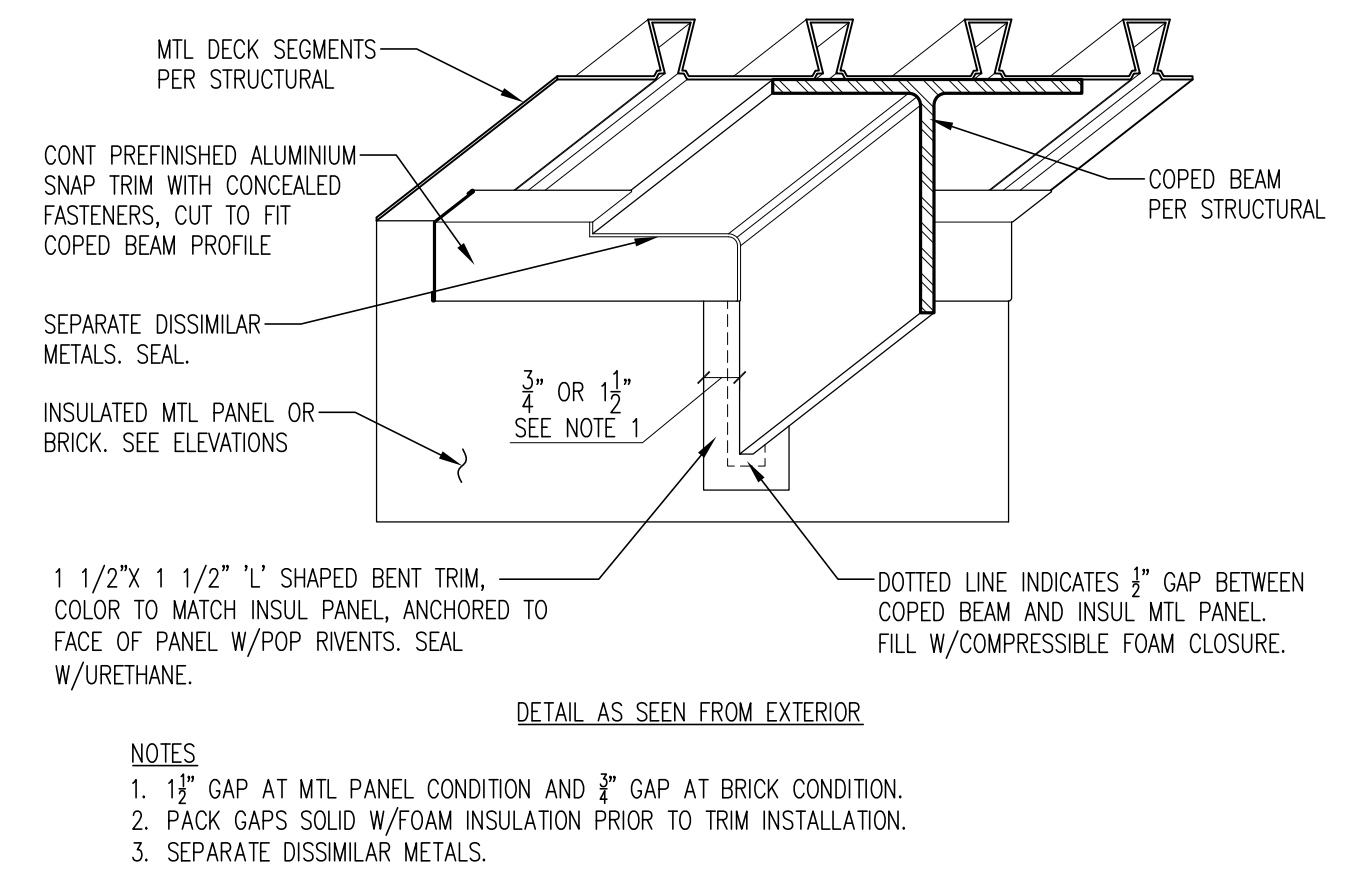


14 COPED BEAM DIAGRAM SCALE: 1 1/2" = 1'-0"

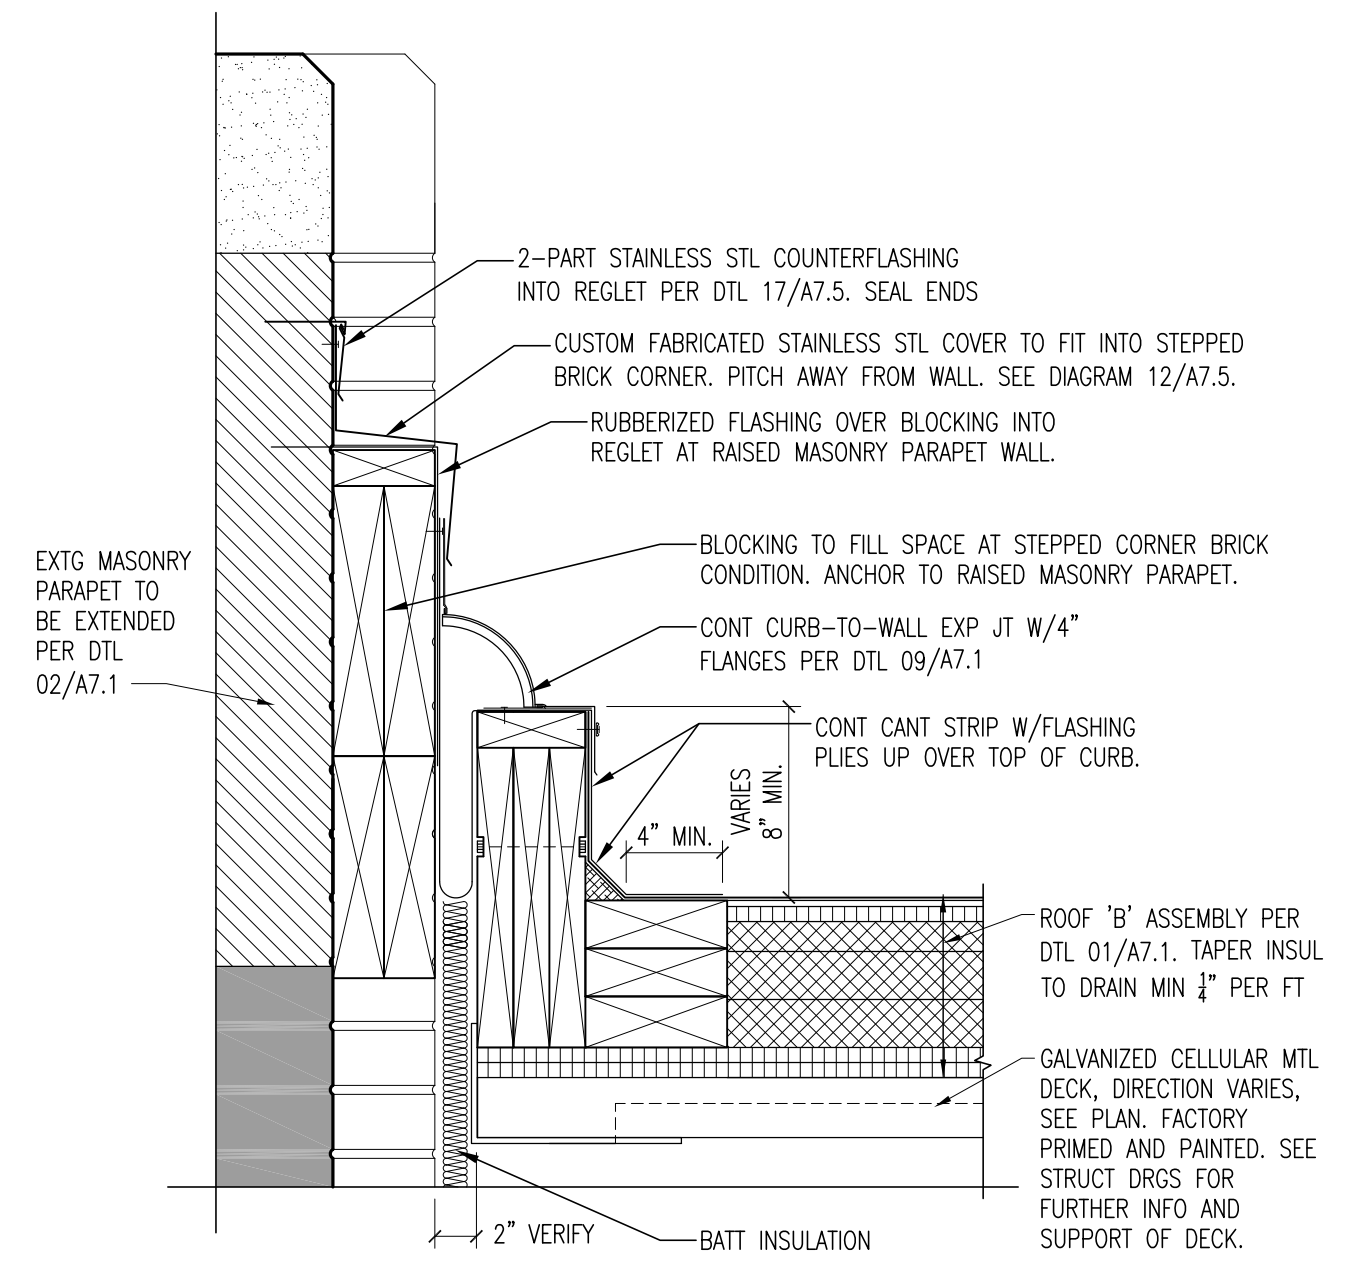




13 ROOF EXP JOINT AT CORNER SCALE: 1 1/2" = 1'-0"

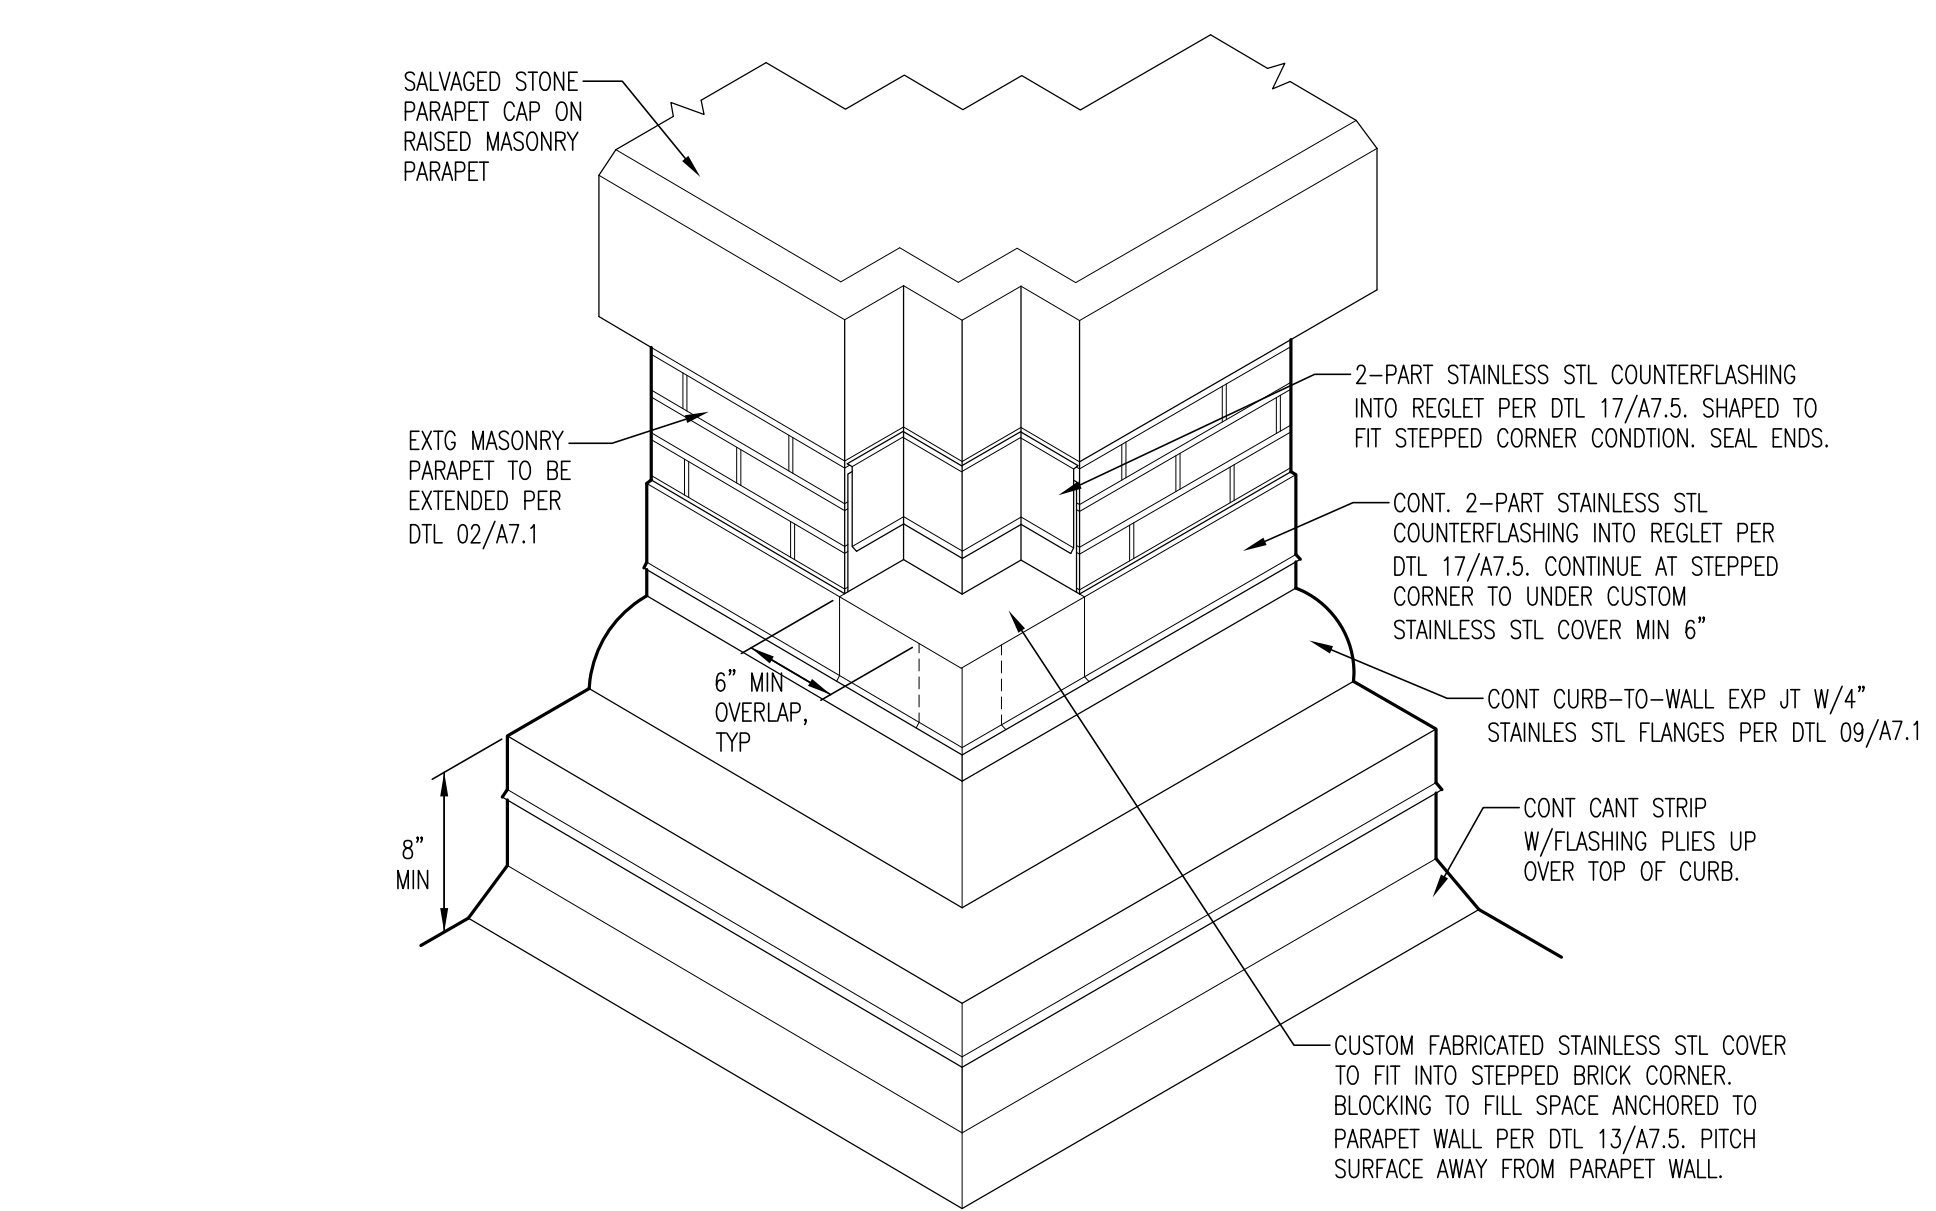


12 STEPPED BRICK CORNER DIAGRAM SCALE: 1" = 1'-0"

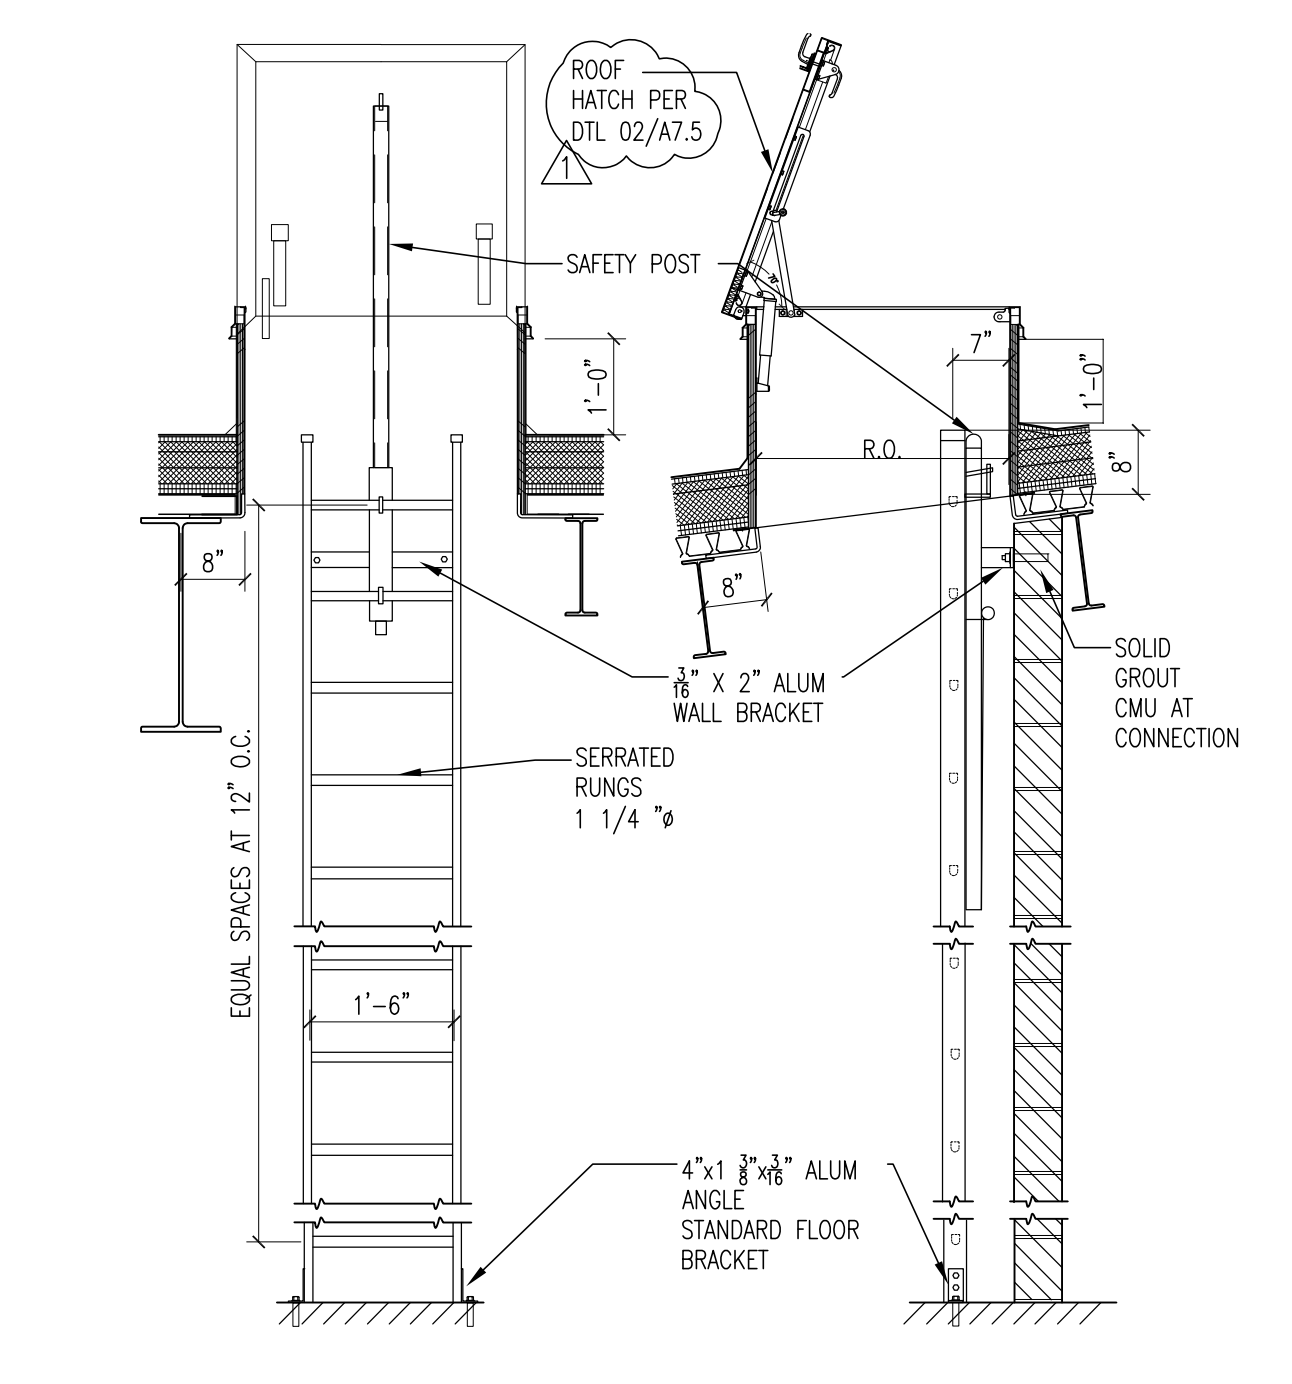


11 ROOF HATCH LADDER SCALE: 1/2" = 1'-0"

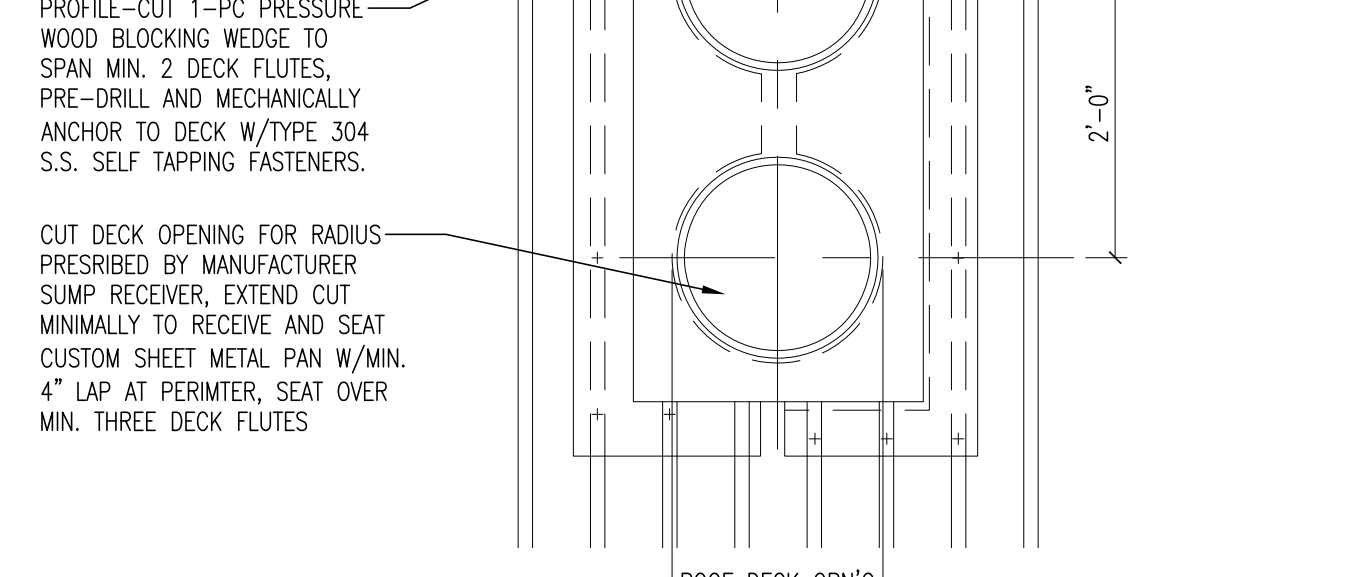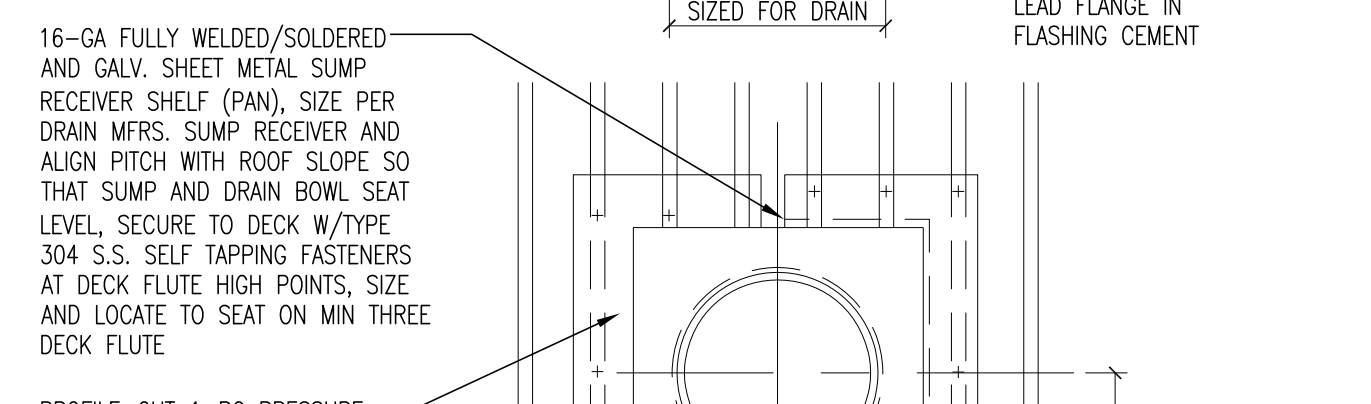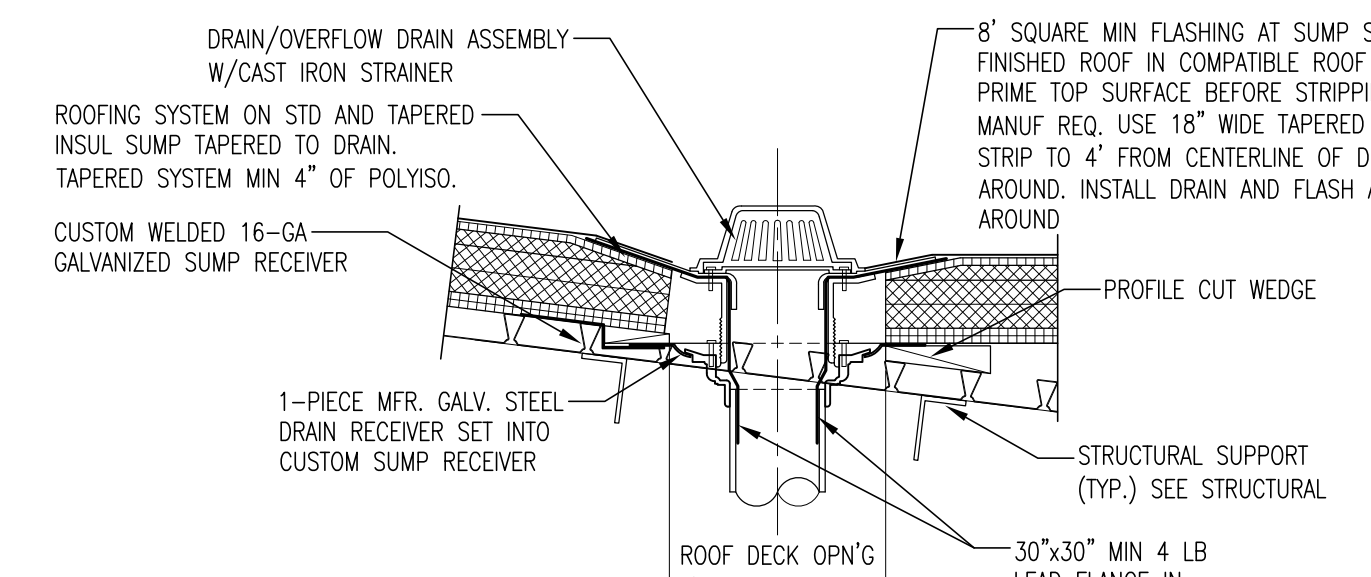


10 ROOF DRAIN DETAIL SCALE: 3/4" = 1'-0"

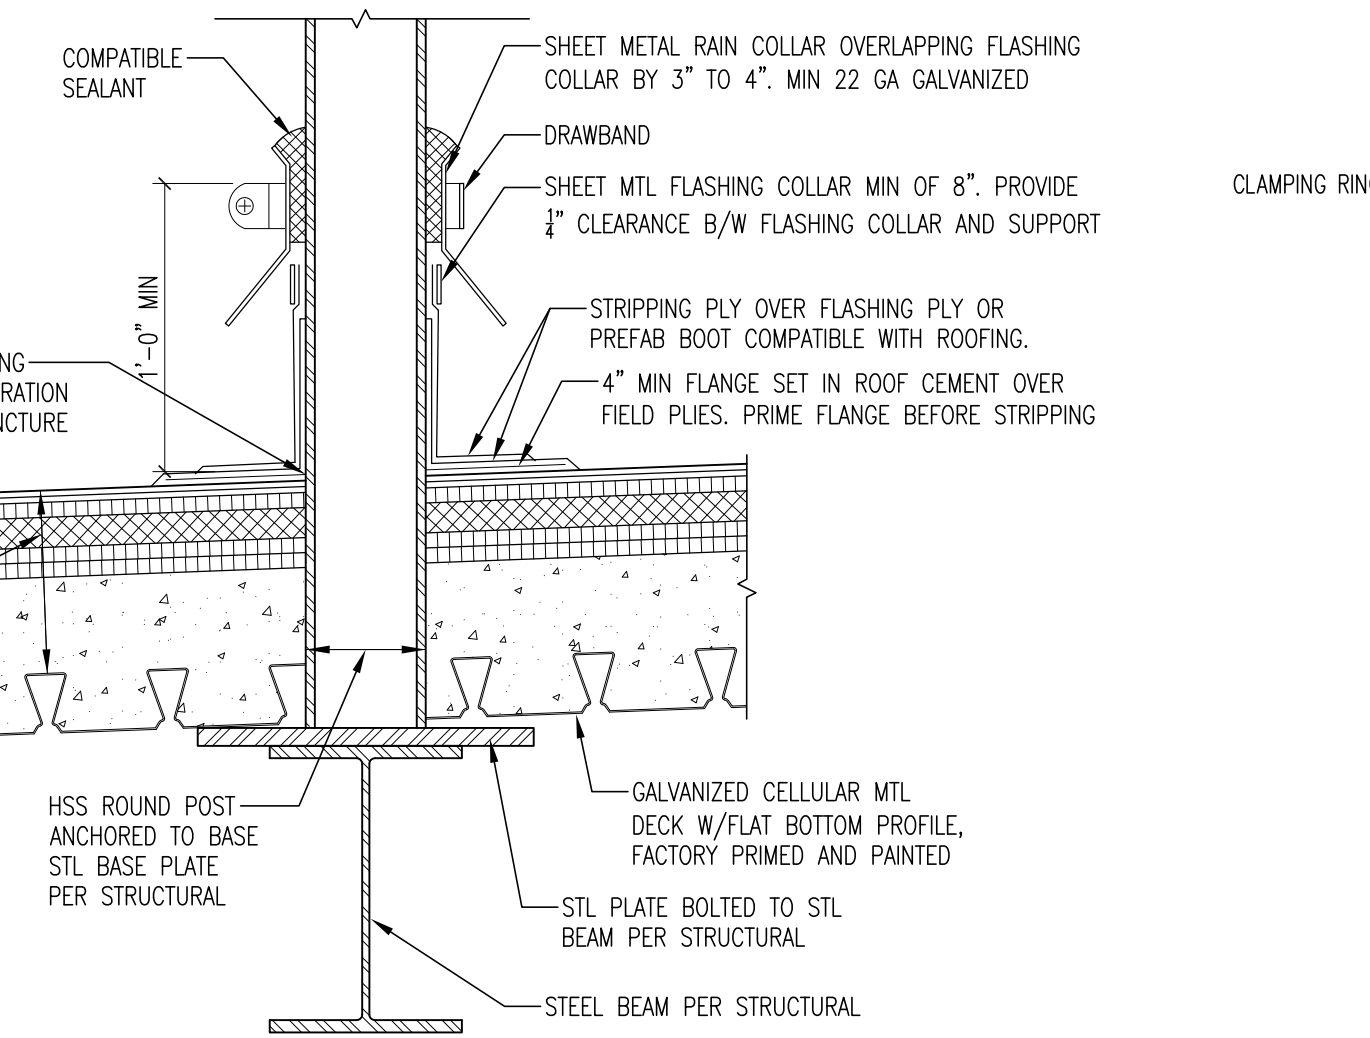


09 PENETRATION AT STRUCTURAL SUPPORT FOR EQUIPMENT SCALE: 1 1/2" = 1'-0"

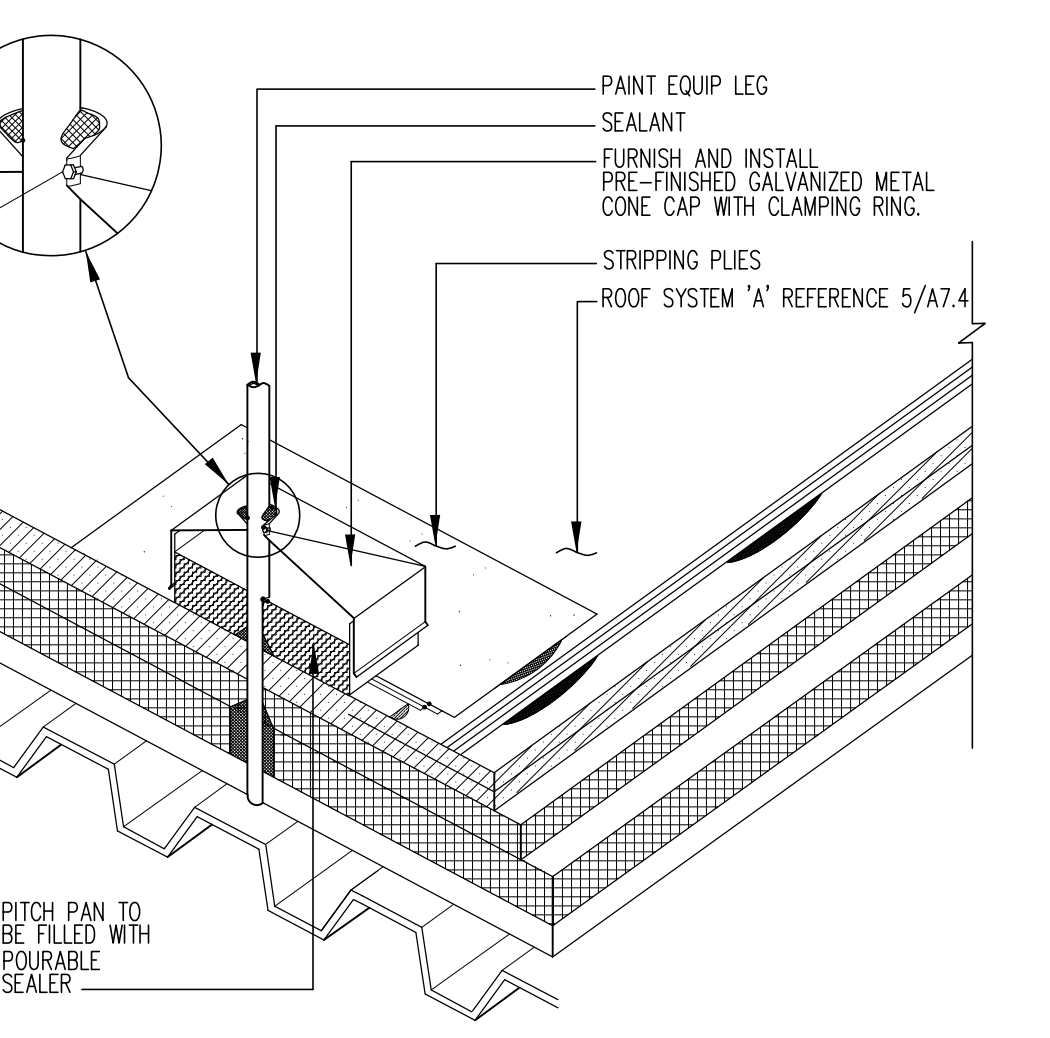


08 SEALANT PAN DETAIL SCALE: 3/4" = 1'-0"

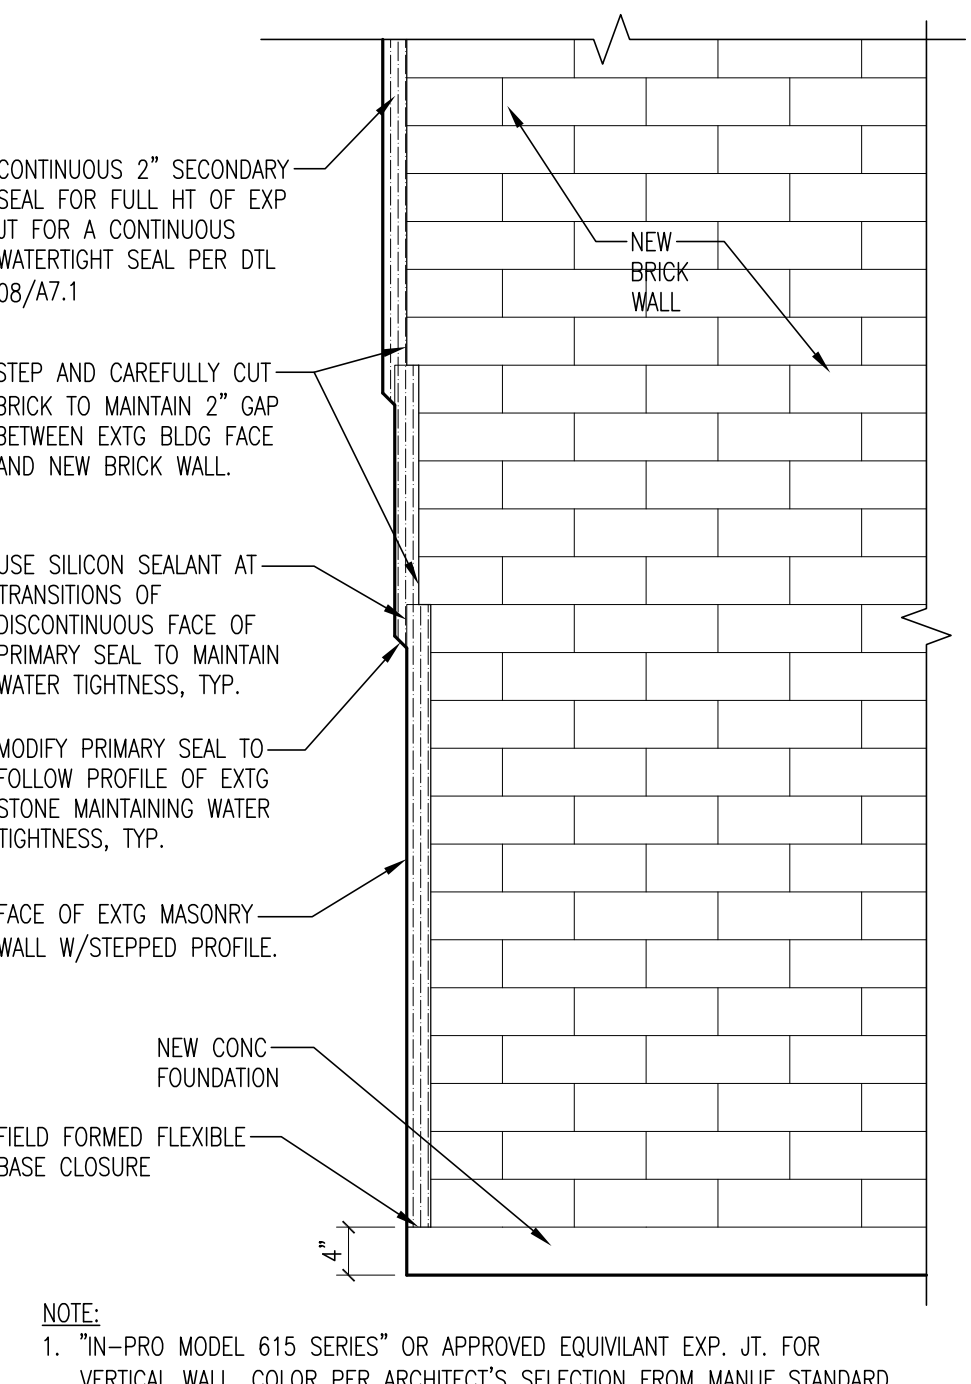


07 EXT WALL EXP. JOINT ELEV SCALE: 3/4" = 1'-0"

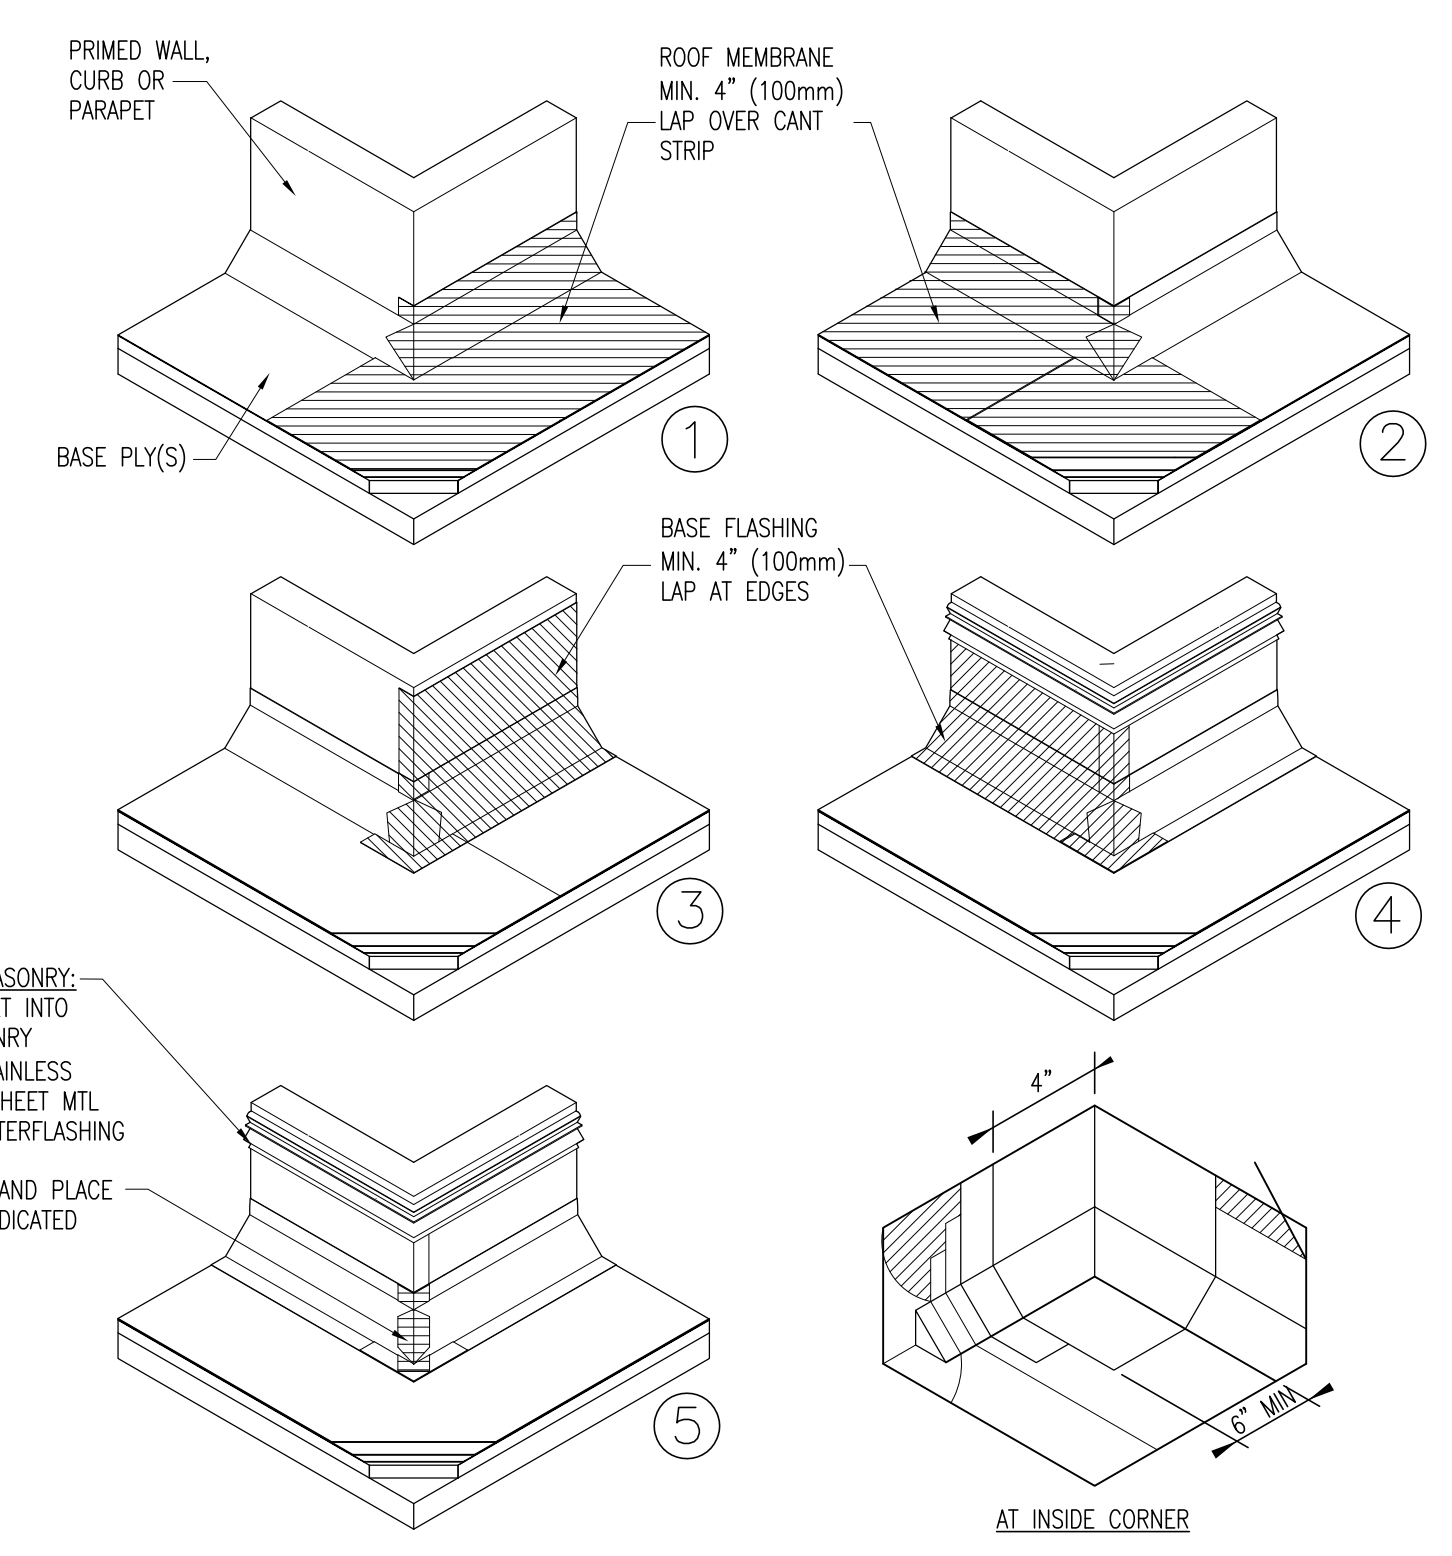


06 CORNER FLASHING SCALE: 1 1/2" = 1'-0"

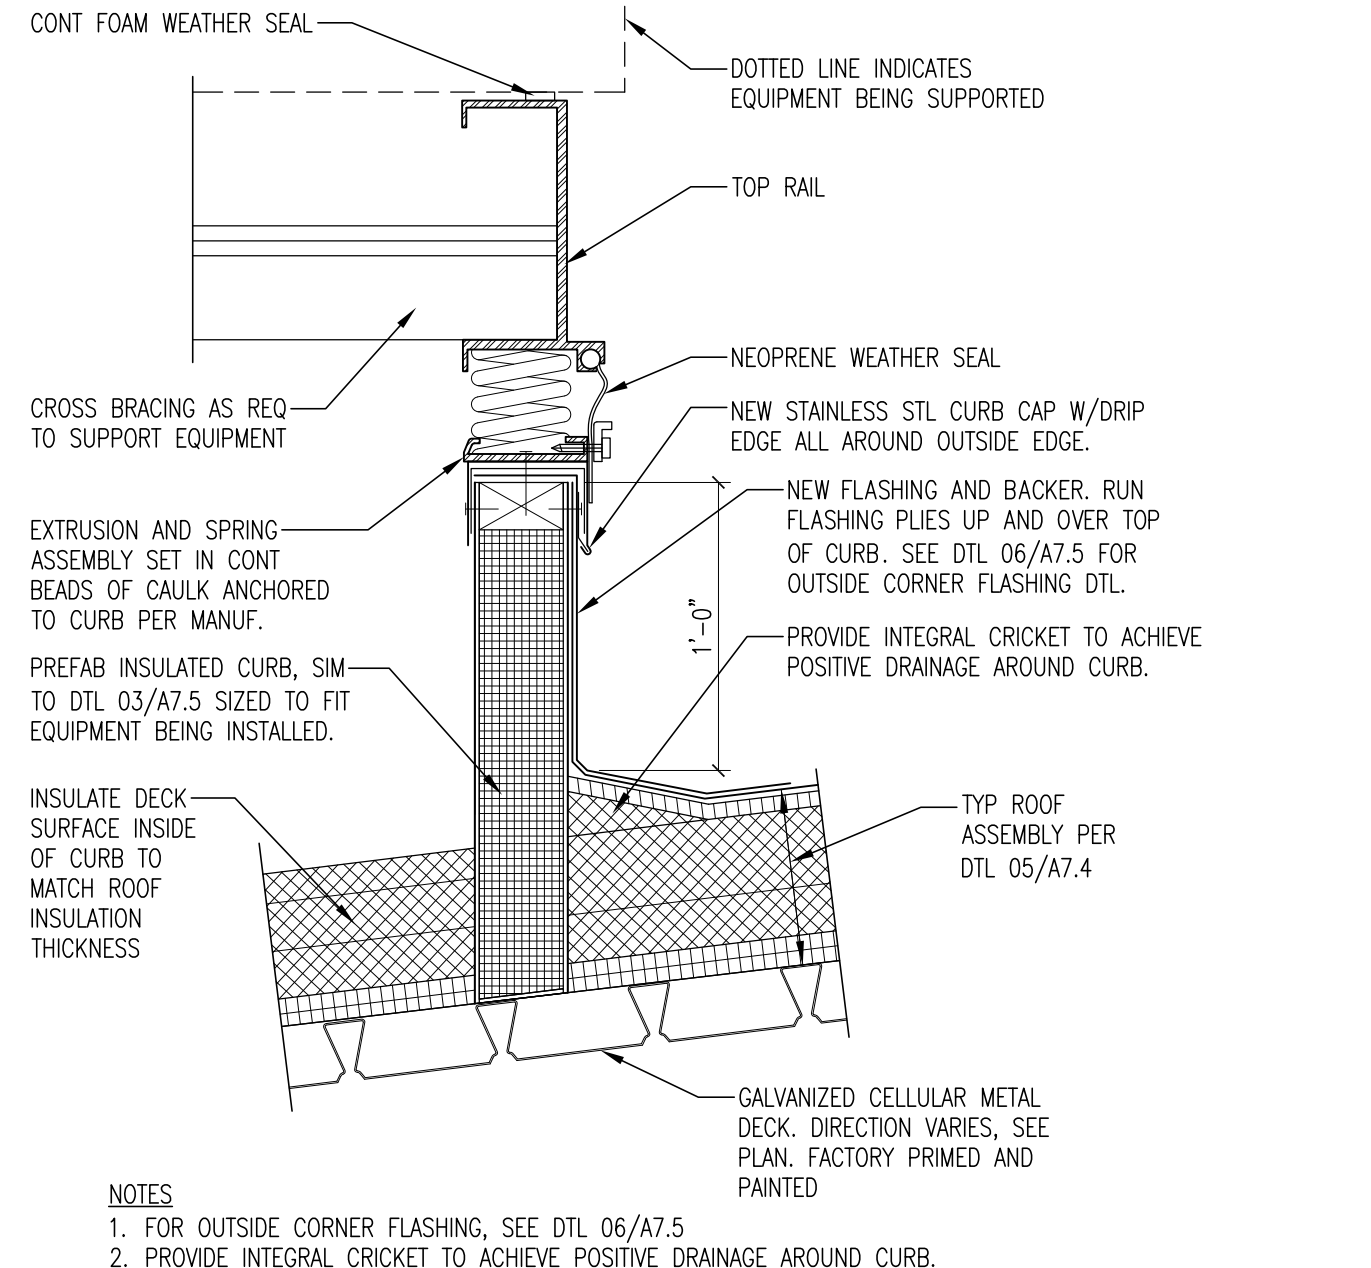


05 TYPICAL CURB SCALE: 1 1/2" = 1'-0"

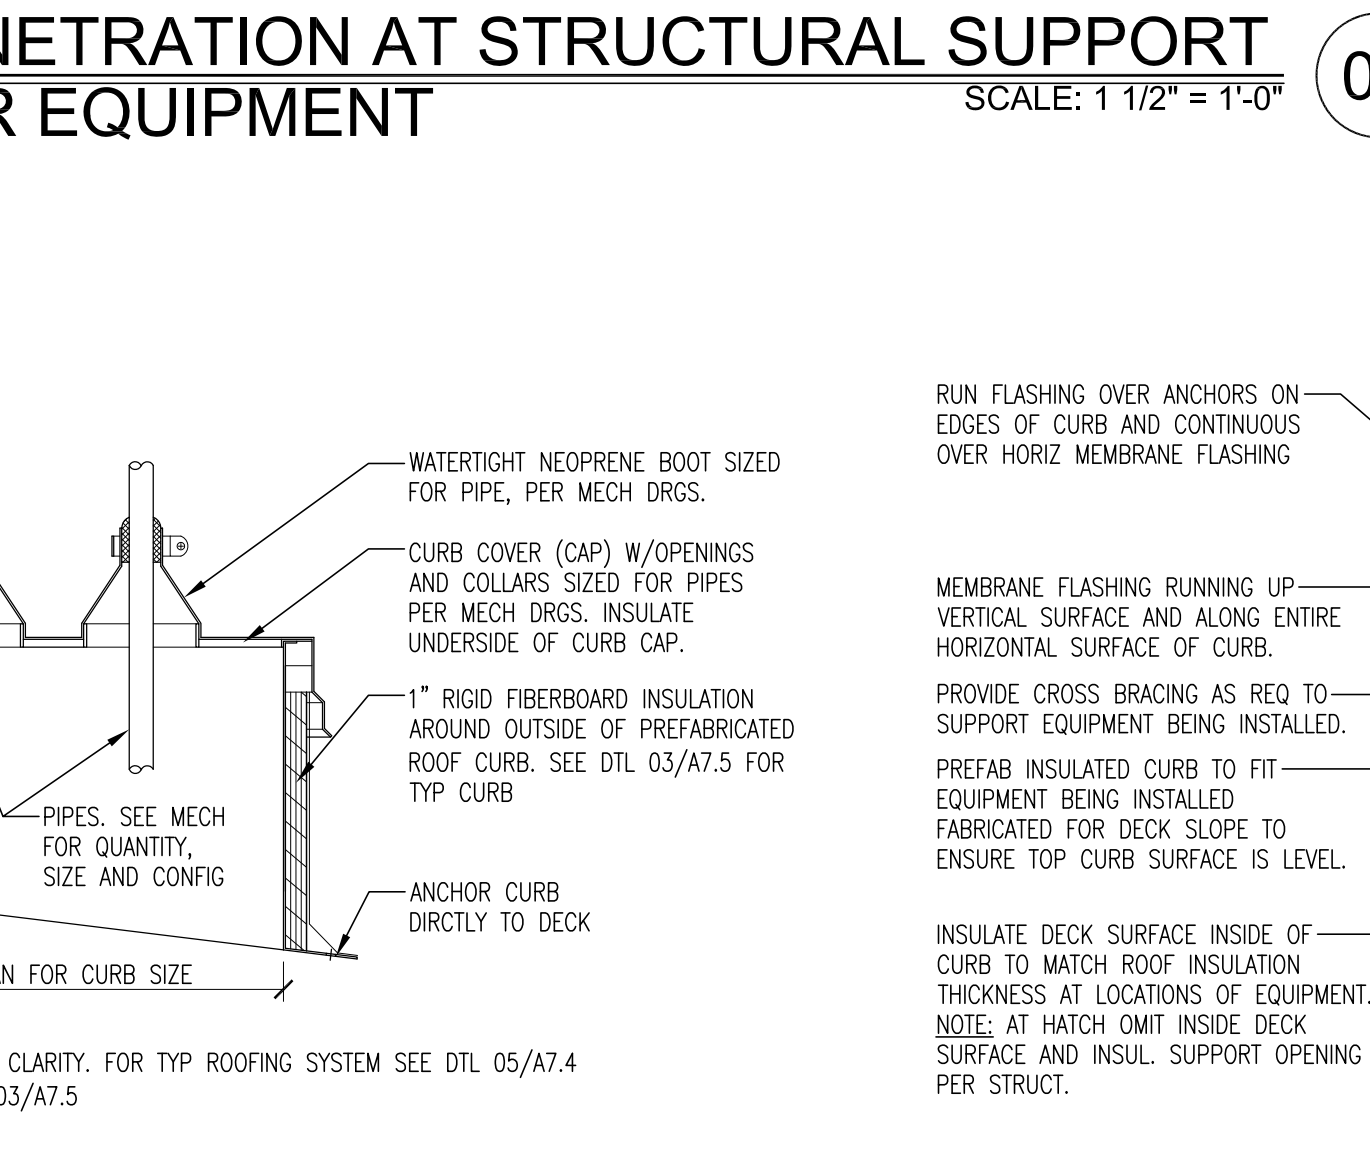


04 CURB AT PIPE PENETRATIONS SCALE: 1 1/2" = 1'-0"

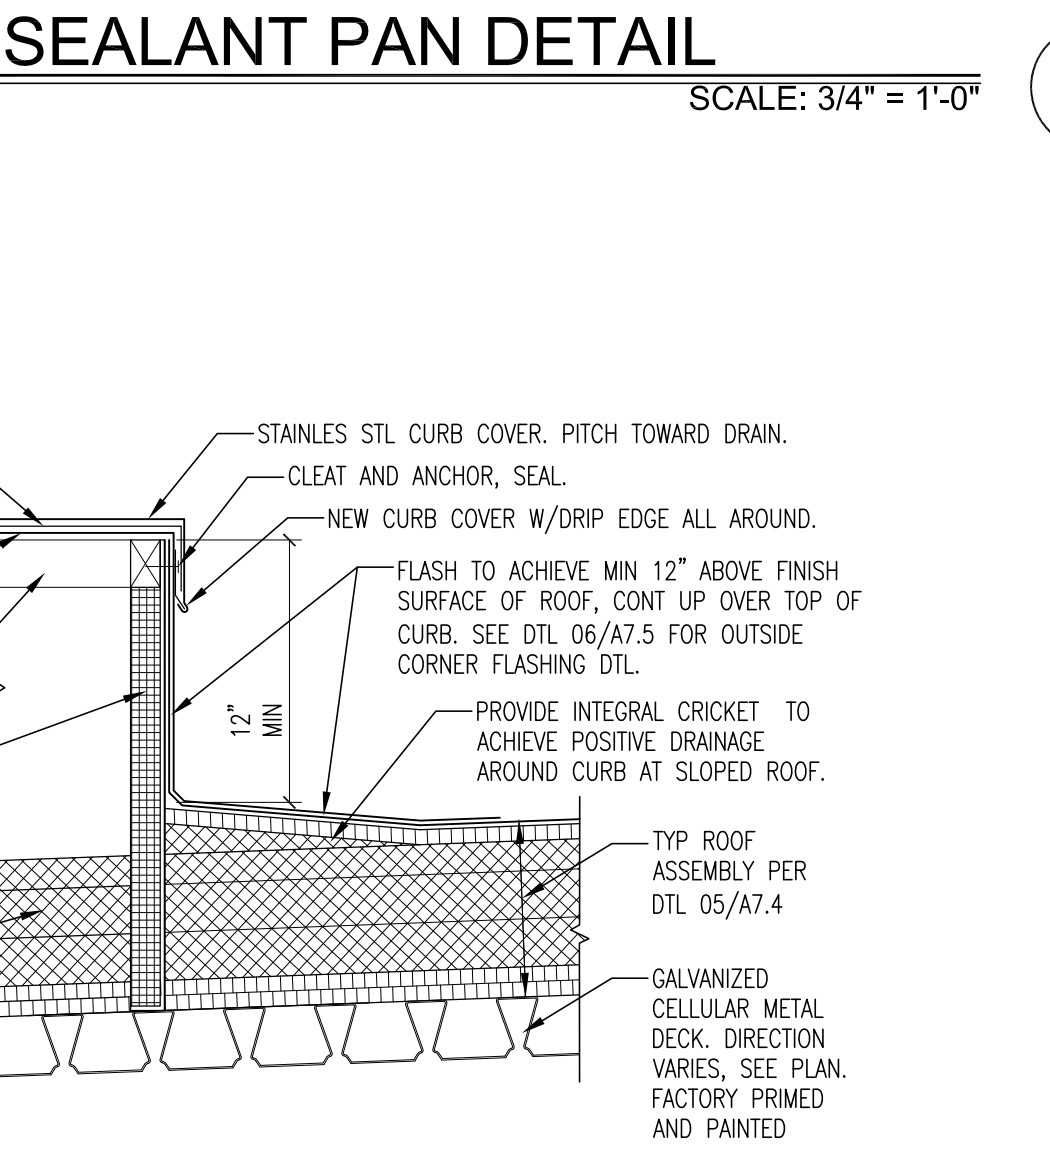

03 TYPICAL EQUIPMENT CURB SCALE: 1 1/2" = 1'-0"

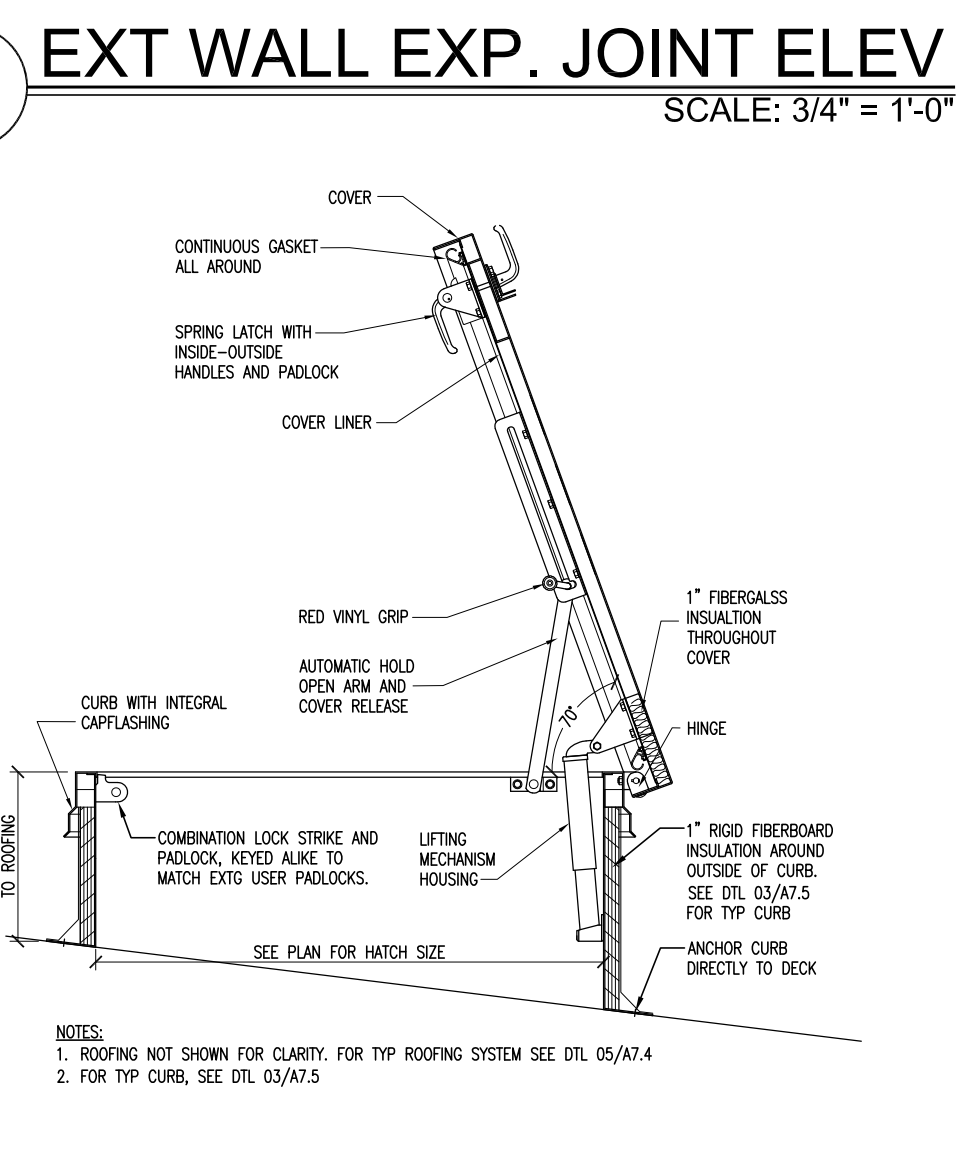

02 ROOF HATCH DETAIL SCALE: 1" = 1'-0"

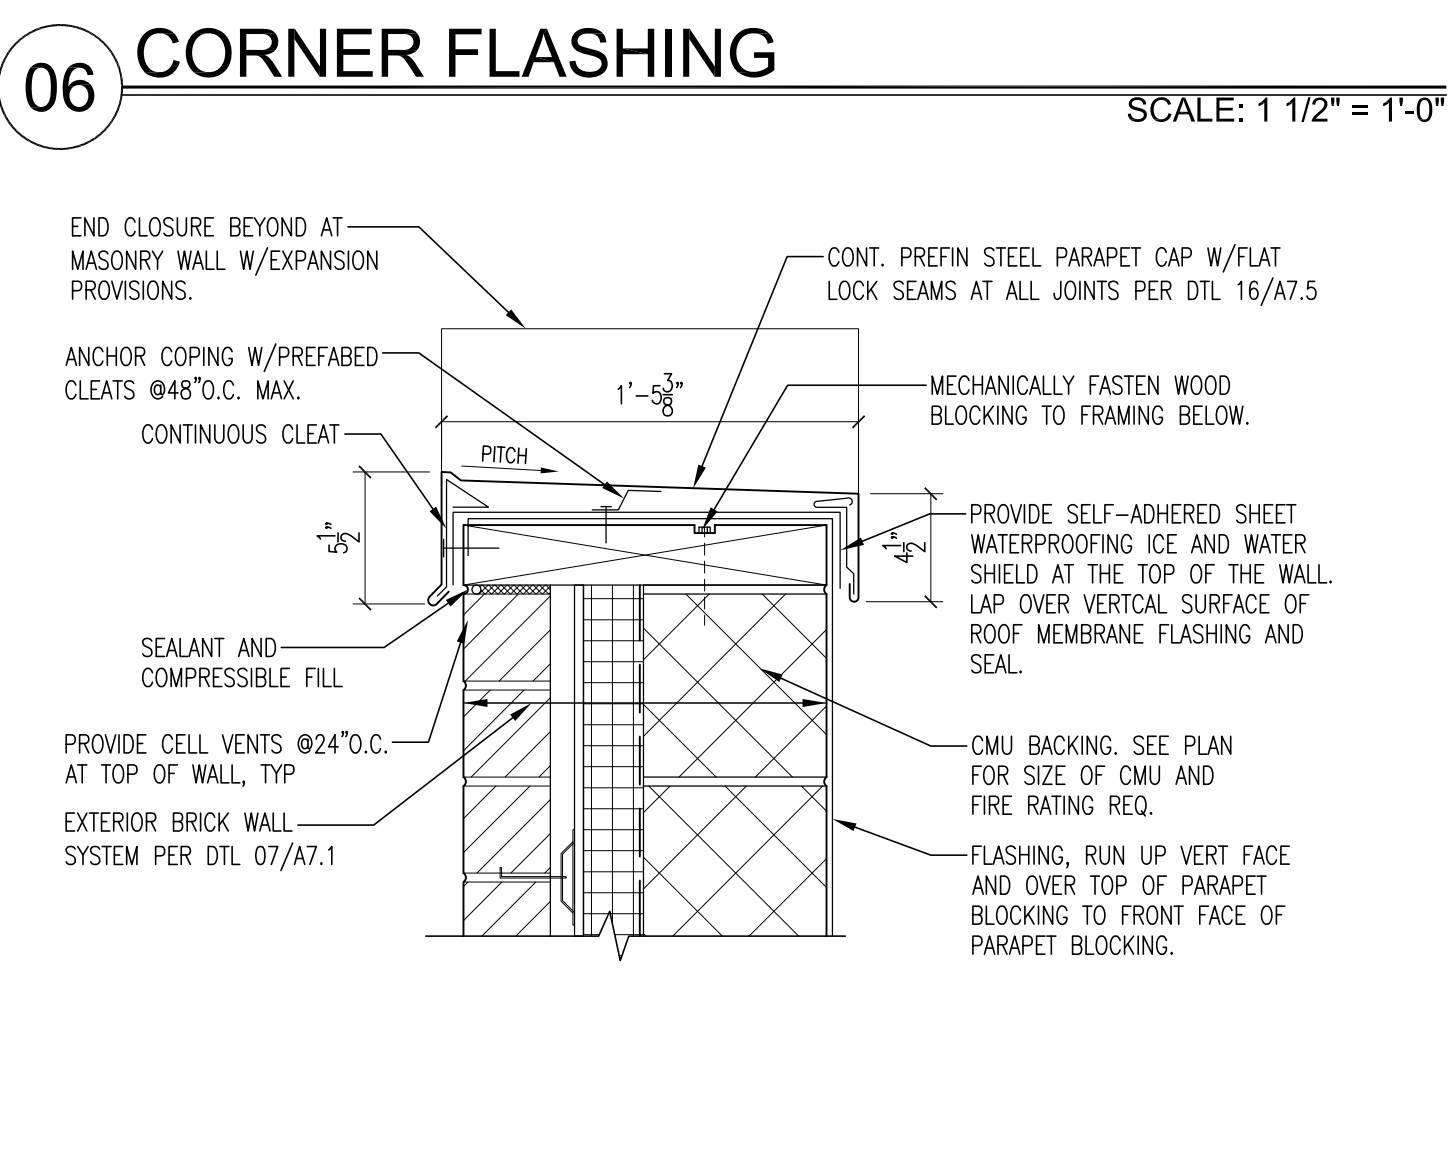

01 PARAPET DETAIL SCALE: 1 1/2" = 1'-0"



EDISON PARK ELEMENTARY SCHOOL ANNEX
6220 N. OLCOTT AVE
CHICAGO, IL 60631
CHICAGO PUBLIC SCHOOLS
CITY OF CHICAGO, MAYOR RAHM IMMANUEL

THESE DRAWINGS HAVE BEEN PREPARED AT AND/OR UNDER MY SUPERVISION AND TO THE BEST OF MY KNOWLEDGE AND BELIEF CONFORM AND COMPLY WITH THE REQUIREMENTS OF THE CHICAGO DEPARTMENT OF BUILDING.

ILLINOIS
KATHLEEN O'DONNELL
REGISTERED ARCHITECT
001-016351
EXPIRATION DATE: NOVEMBER 30, 2014

TRIPARTITE, INC
Architecture Restoration Design
4720 N. Virginia Ave.
Chicago, Illinois 60625
P: 773-541-4094
www.tripartiteinc.com

MATRIX ENGINEERING CORPORATION
531 N. JACKSON BLVD., 4TH FLOOR / CHICAGO, IL 60654
STRUCTURAL ENGINEERING

SITE DESIGN GROUP, LTD.
1815 N. WASHINGTON AVE., SUITE 1000 / CHICAGO, IL 60610
LANDSCAPE DESIGN

TERRA ENGINEERING, LTD.
225 W. OHIO STREET, 4TH FLOOR / CHICAGO, IL 60604
CIVIL ENGINEERING

CALOR DESIGN GROUP, LTD.
2017 N. WESTERN AVE. / CHICAGO, IL 60617
MECHANICAL, PLUMBING, FIRE PROTECTION

TECHNOW ENGINEERING, LLC
1116 KOSTER AVE., SUITE 1100 / CHICAGO, IL 60642
QUALITY CONTROL, LOW VOLTAGE, SECURITY, FIRE ALARM

HJ KESSLER ASSOCIATES
1860 LAKE SHORE DRIVE, SUITE 501 / CHICAGO, IL 60613
ACoustics CONSULTANT

EDGE ASSOCIATES, INC
200 S. LAKE STREET, SUITE 303 / ADDISON, IL 60101
FLOOR SERVICES

DOOR SECURITY SOLUTIONS
1114 KOSTER AVE., WENDELLVILLE, IL 60180
HARDWARE CONSULTANT

PIN DROP ACOUSTICS
201 W. LAKE STREET, #150 / CHICAGO, IL 60606
ACOUSTICS CONSULTANT


ISSUANCE

MARK	DESCRIPTION	DATE
1	ISSUE FOR BID	12-18-2012
2	ADDENDUM 1	01-17-2013
3		
4		
5		
6		
7		
8		

SCALE: AS NOTED
PLOT DATE: 11/7/2013
PROJECT: WME EDISON PARK ELEMENTARY SCHOOL ANNEX
PBC CONTRACT NO.: ...
PROJECT NO.: 05650


ASBESTOS-CONTAINING BUILDING MATERIALS ARE OR MAY BE PRESENT IN THIS BUILDING. AN ASBESTOS MANAGEMENT PLAN IS AVAILABLE IN THE SCHOOL. FOR REVIEW UPON REQUEST. NO UNLINED MATERIALS ARE TO BE USED IN THIS PROJECT UNLESS THAT PERSON IS A LICENSED ASBESTOS WORKER OR CONTRACTOR. ALL WORK SHALL BE DONE IN ACCORDANCE WITH SPECIFICATIONS CONTAINED IN THE PROJECT DOCUMENTS AND ALL APPLICABLE FEDERAL, STATE AND LOCAL HEALTH, SAFETY AND REGULATIONS.

TITLE: CONSTRUCTION DETAILS
SHEET: A7.5

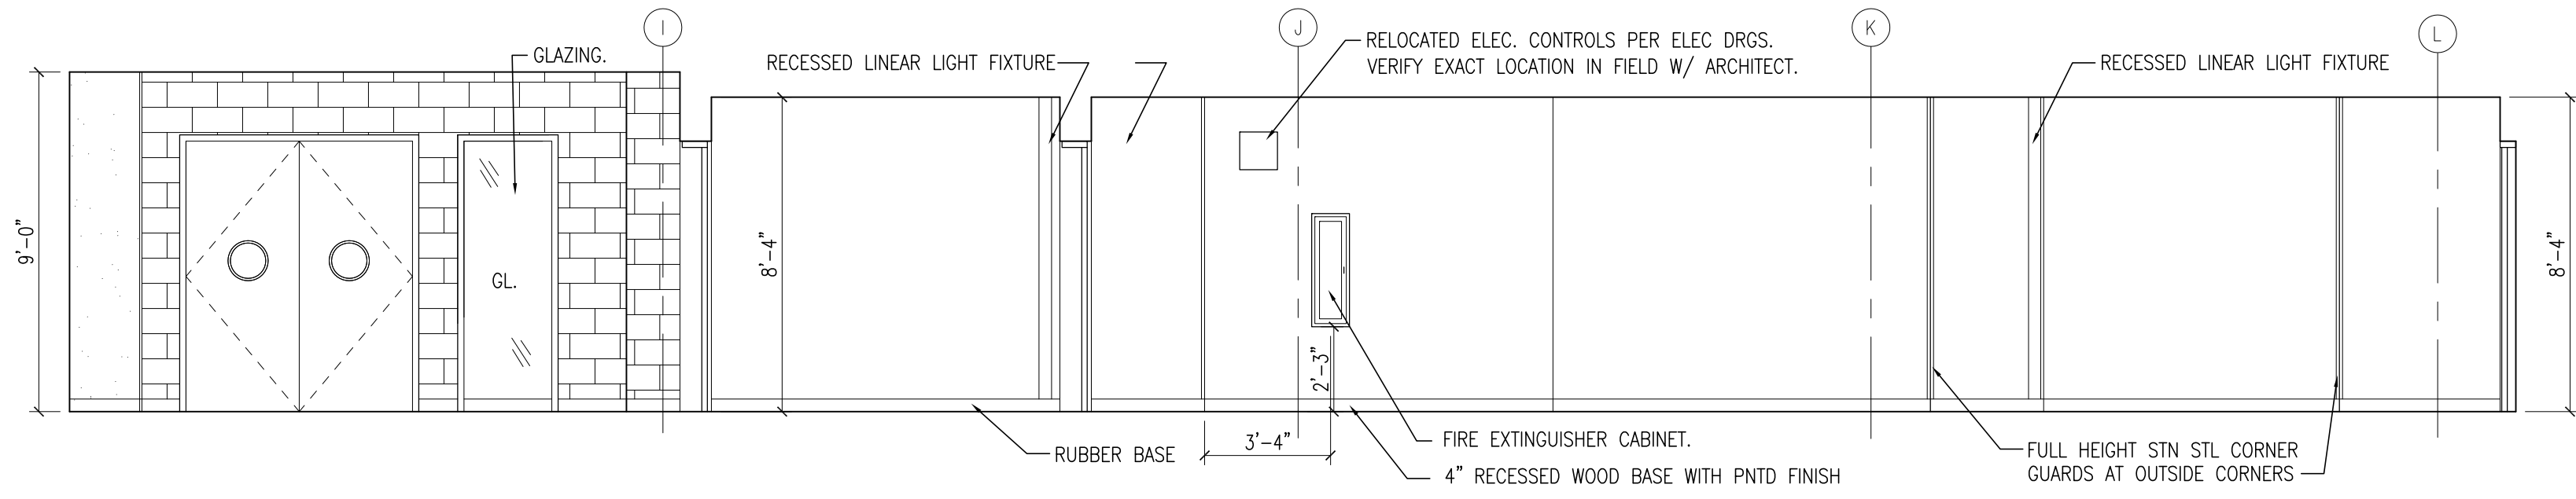


12 VESTIBULE 219B, CORRIDOR 218-NORTH ELEVATION

SCALE: 1/4" = 1'-0"

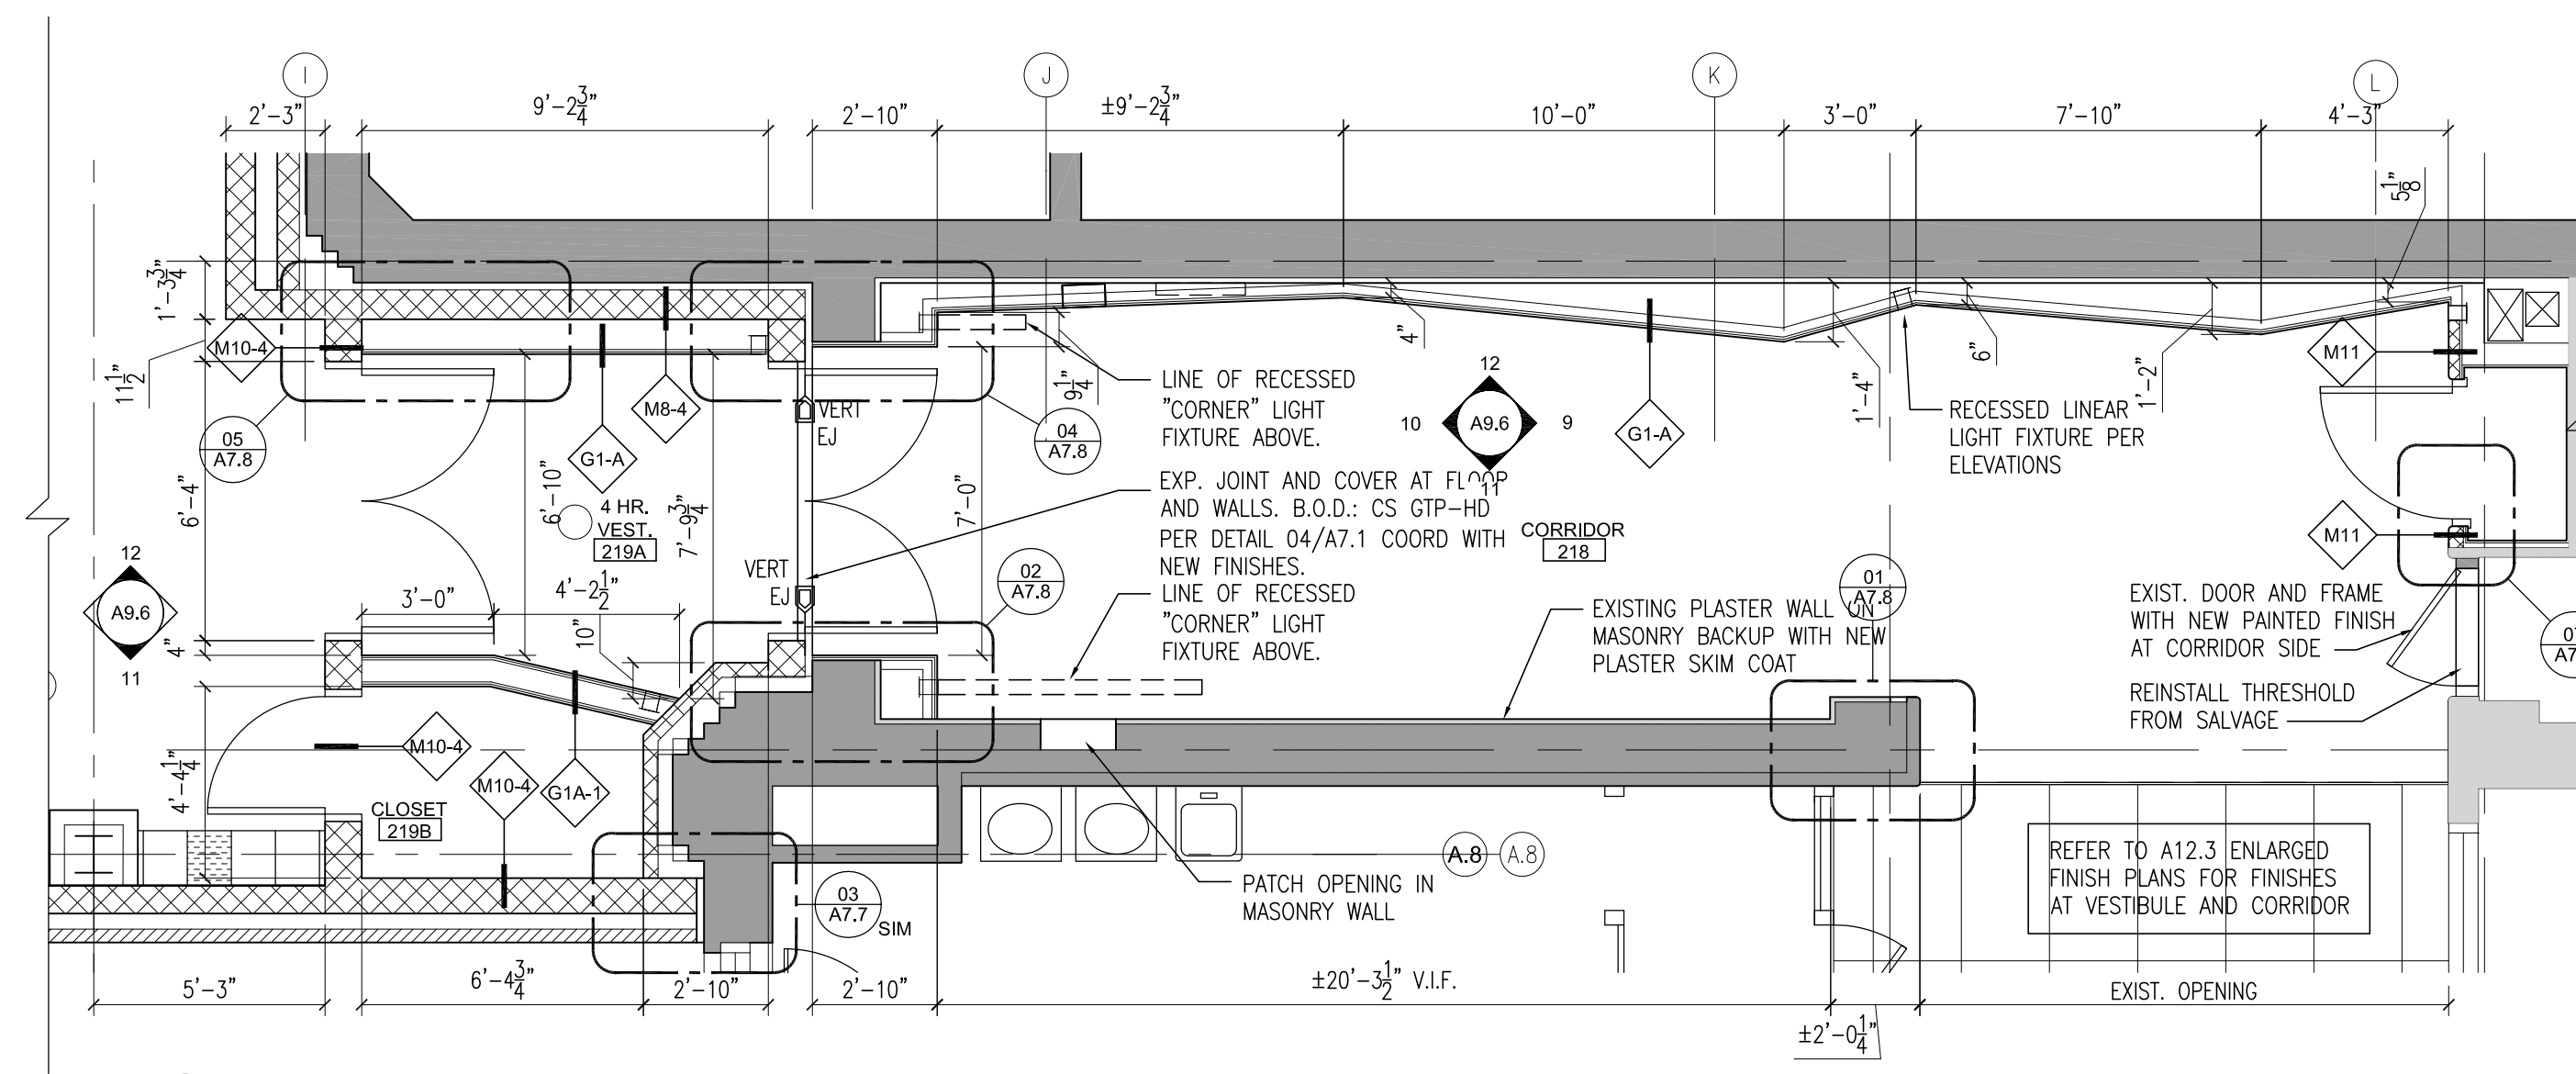


13 ENLARGED PLAN AT VESTIBULE 219A, CORRIDOR 218

SCALE: 1/4" = 1'-0"

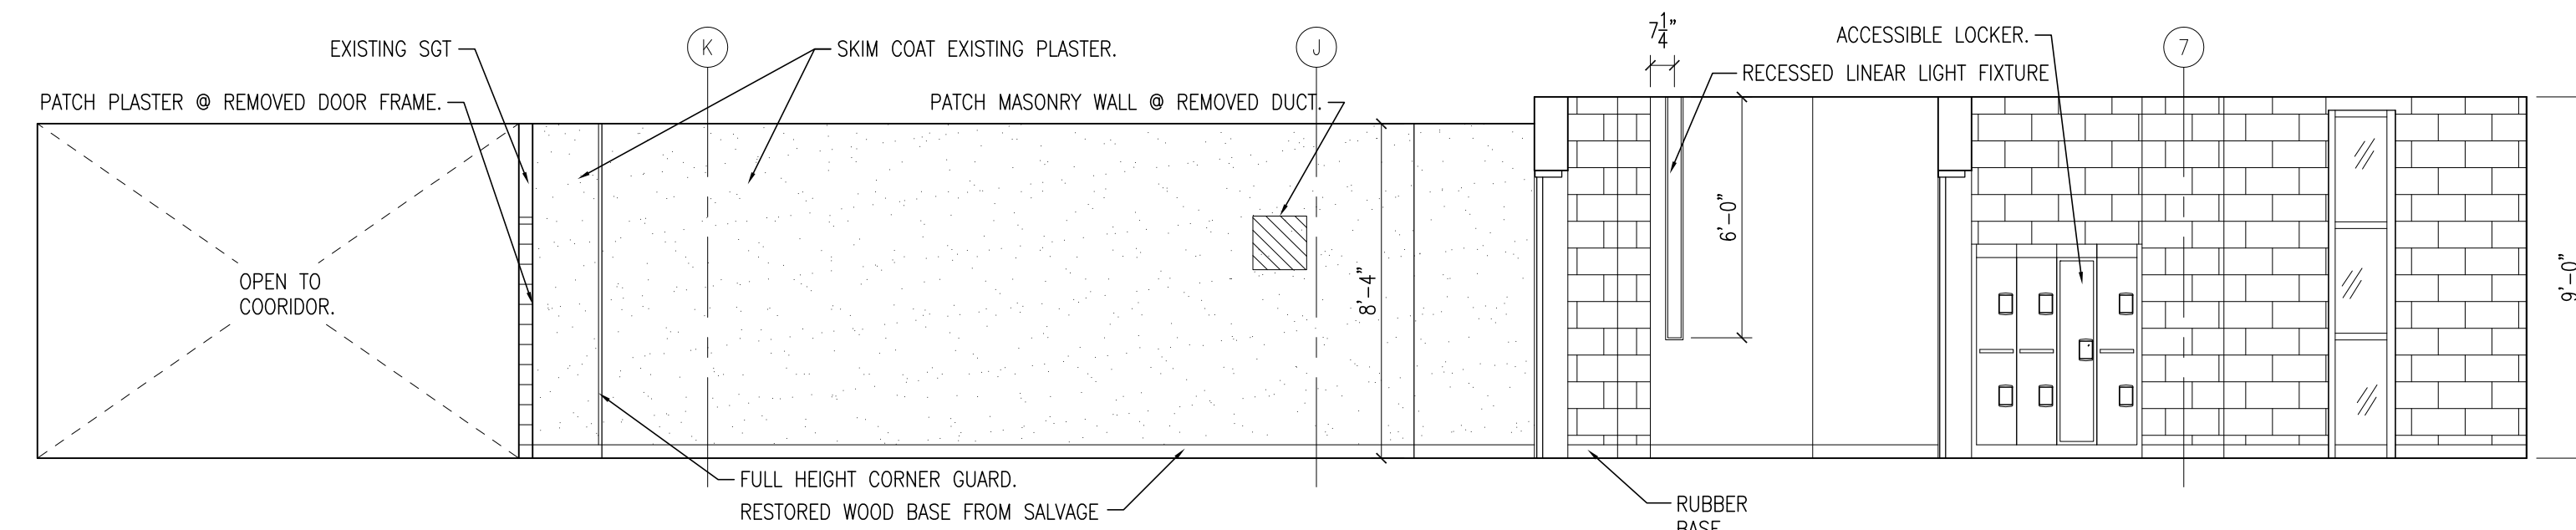


11 VESTIBULE 219B, CORRIDOR 218-SOUTH ELEVATION

SCALE: 1/4" = 1'-0"

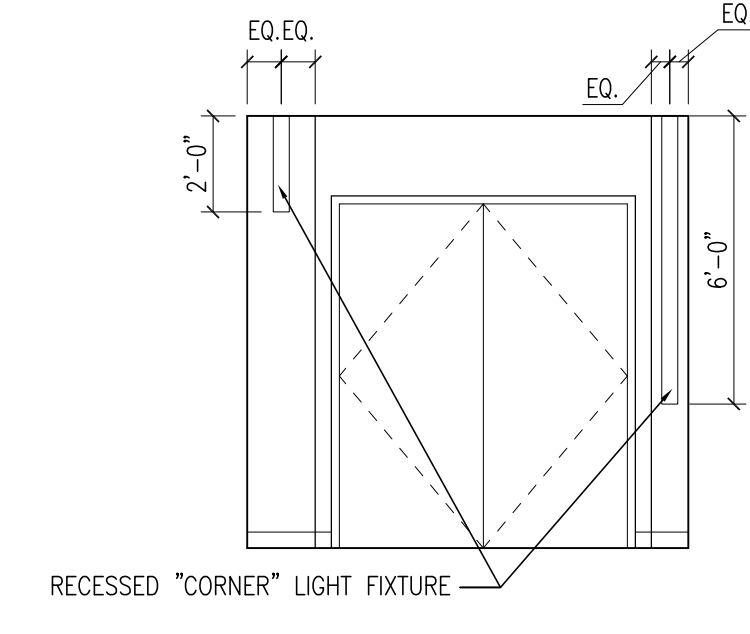


10 CORRIDOR 218-WEST

SCALE: 1/4" = 1'-0"

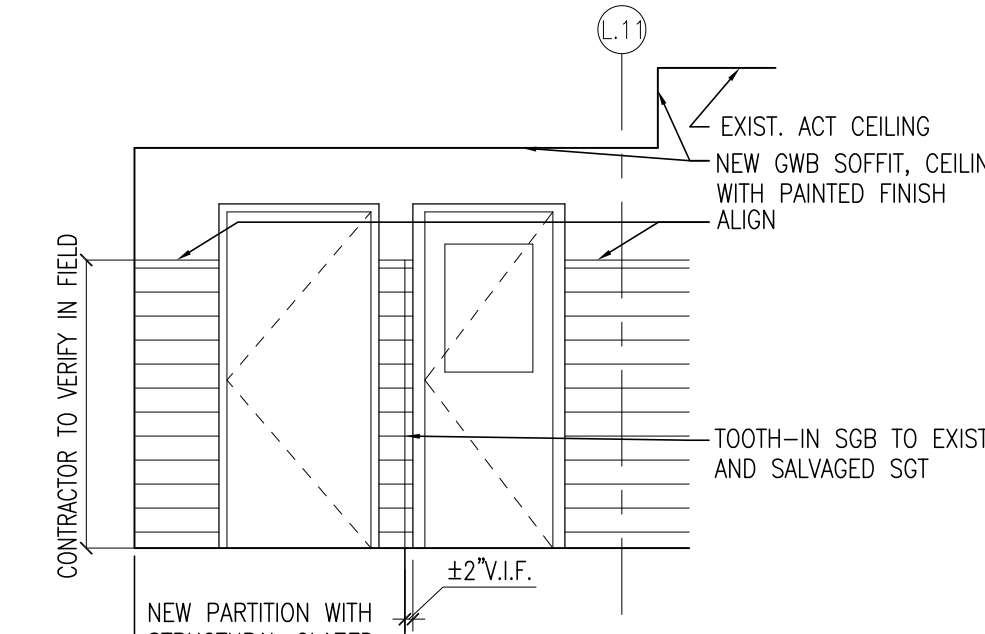


09 CORRIDOR 218-EAST

SCALE: 1/4" = 1'-0"

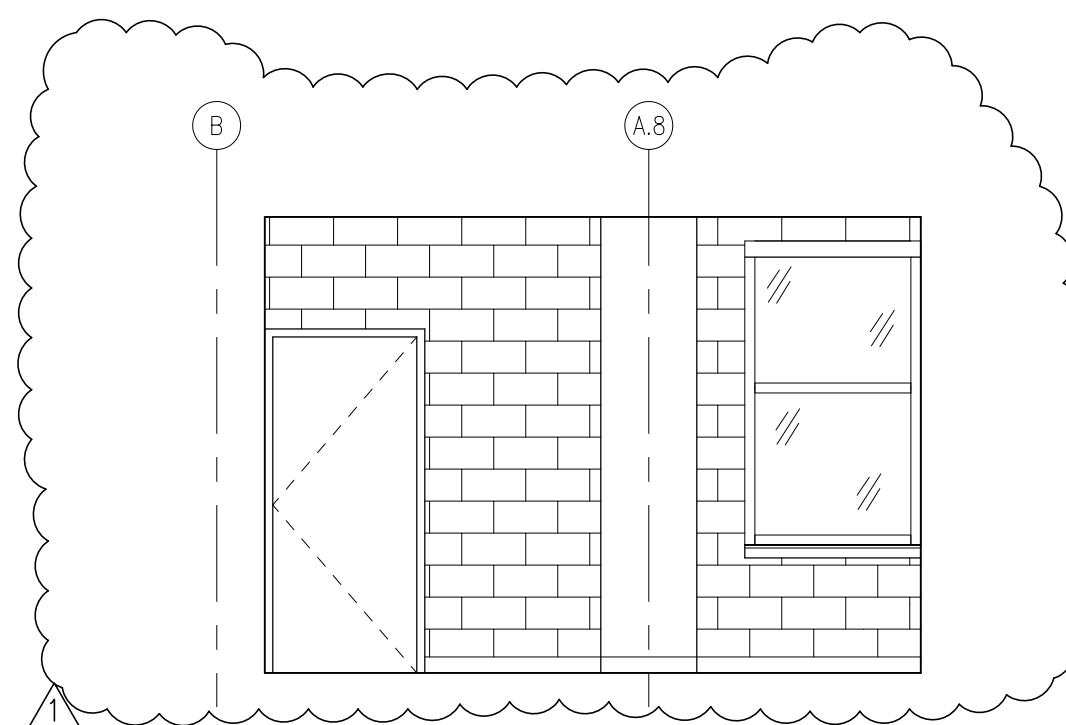


08 OFFICE 231-EAST ELEV

SCALE: 1/4" = 1'-0"

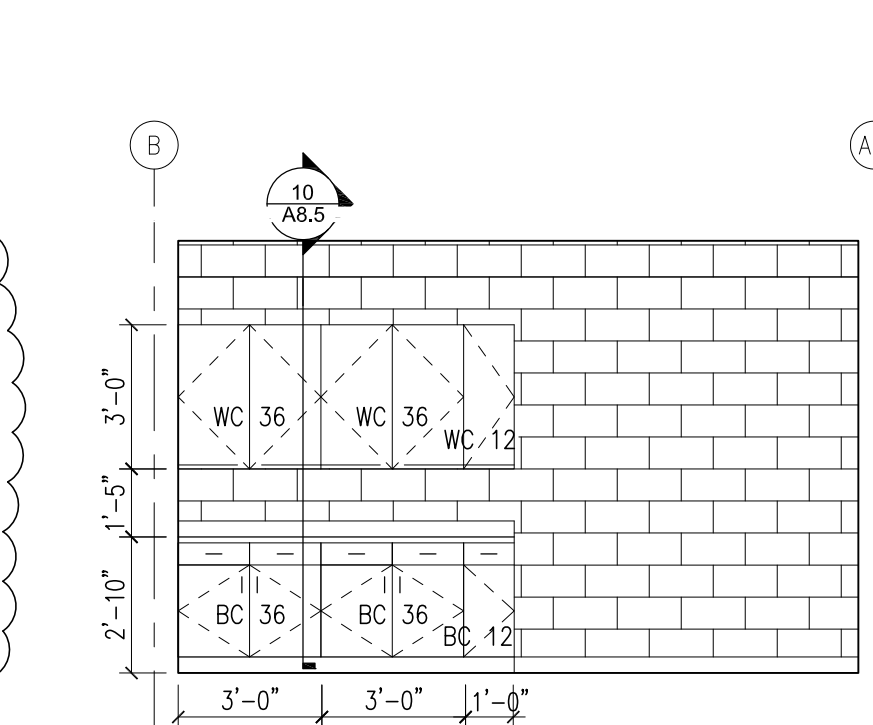


07 SCIENCE STORAGE-EAST ELEV

SCALE: 1/4" = 1'-0"

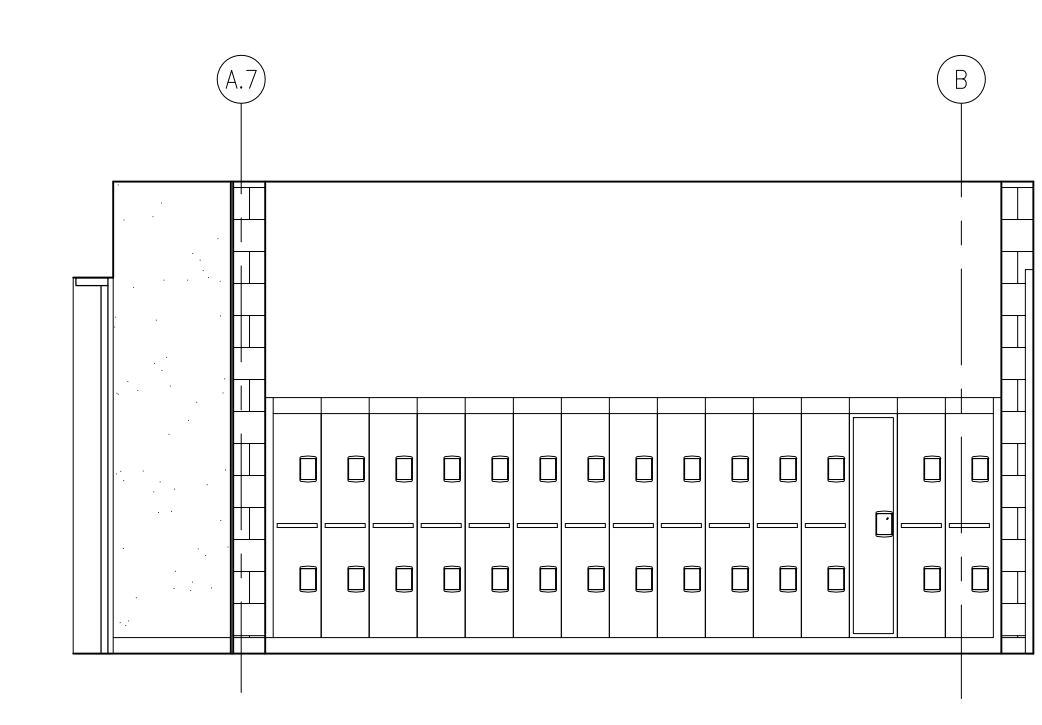


06 CORRIDOR 230-WEST ELEV

SCALE: 1/4" = 1'-0"

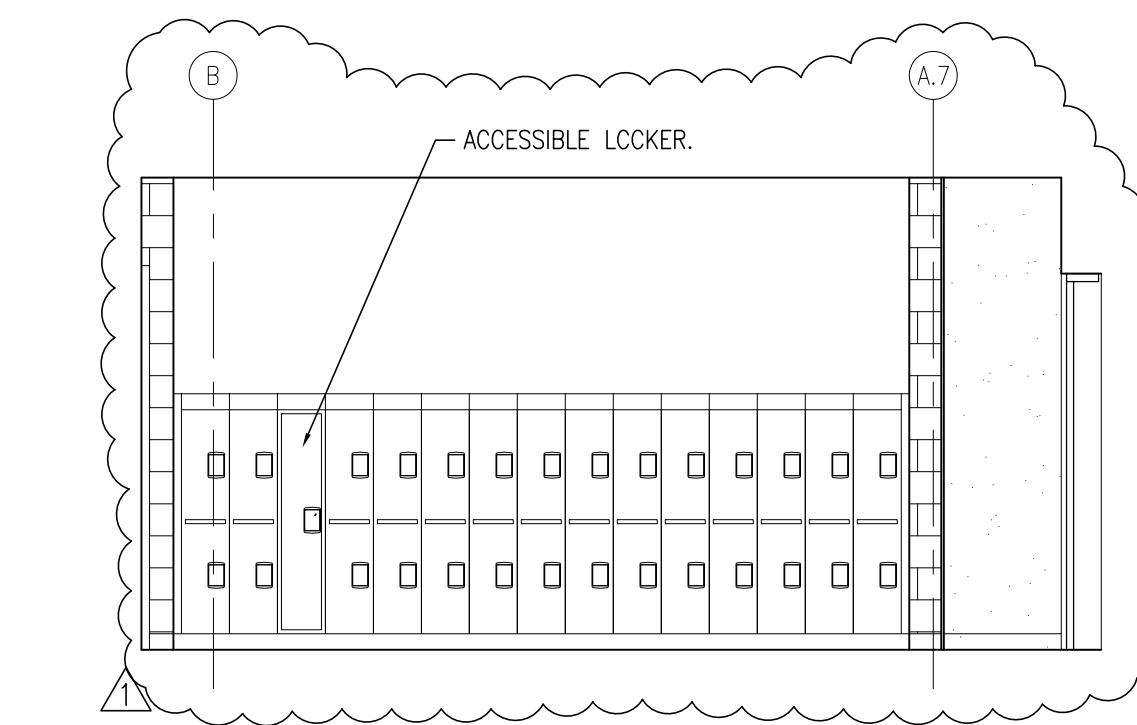


05 CORRIDOR 230-EAST ELEV

SCALE: 1/4" = 1'-0"

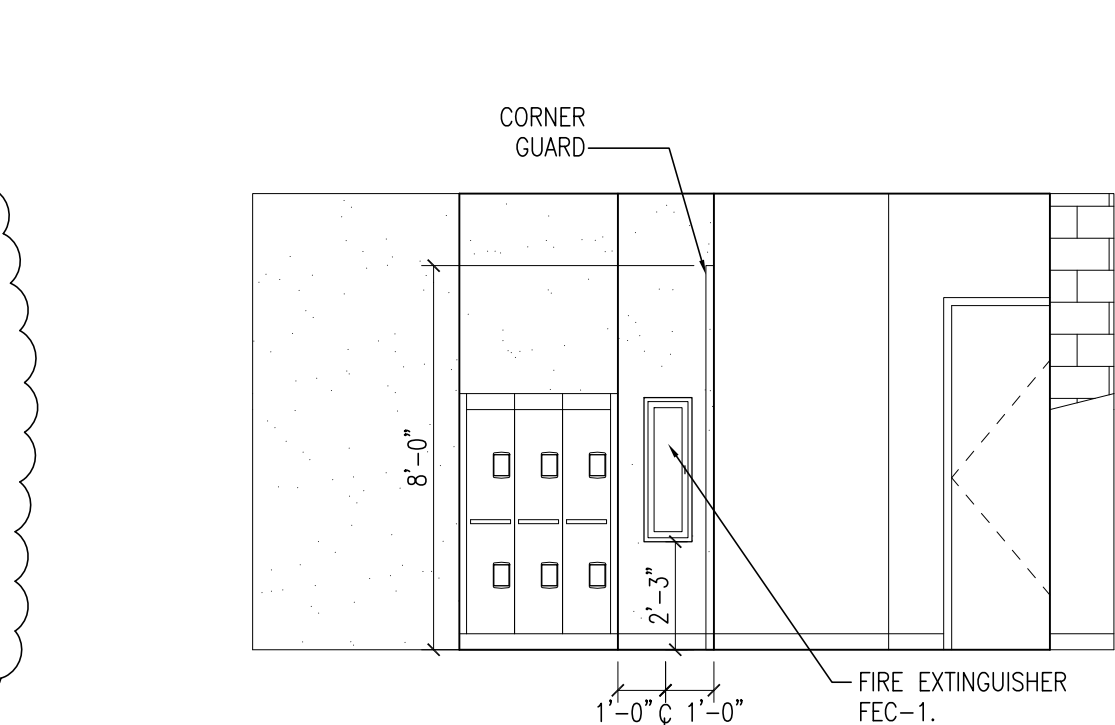


04 CORRIDOR 230-EAST ELEVATION

SCALE: 1/4" = 1'-0"

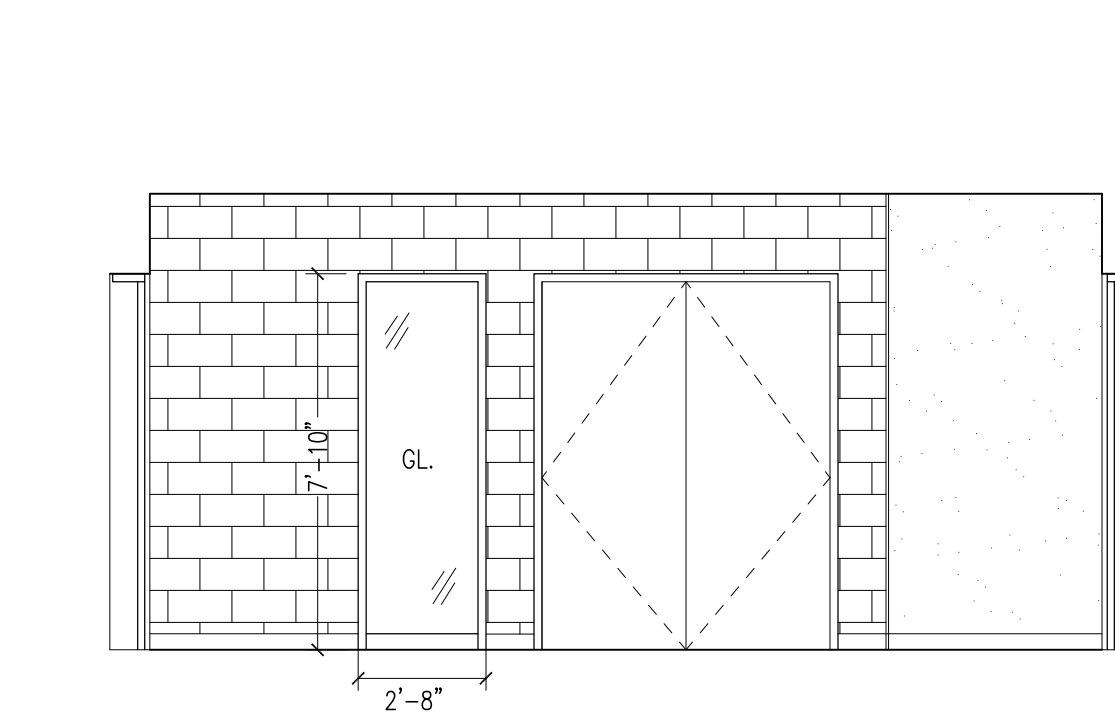


03 CORRIDOR 230-WEST ELEVATION

SCALE: 1/4" = 1'-0"

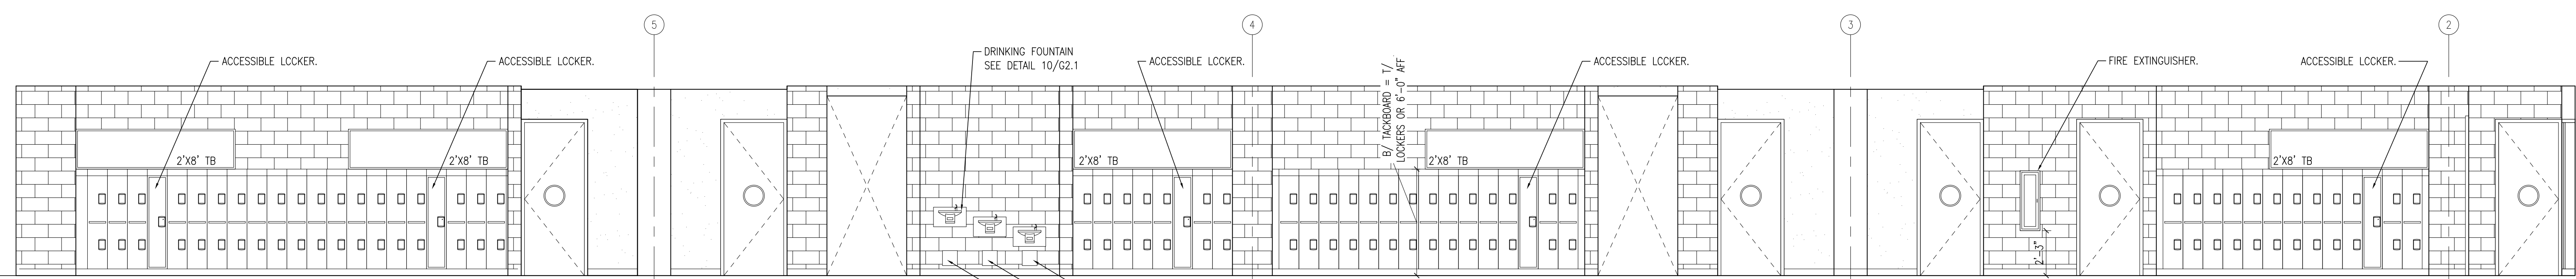

02 CORRIDOR 230-SOUTH ELEVATION

SCALE: 1/4" = 1'-0"

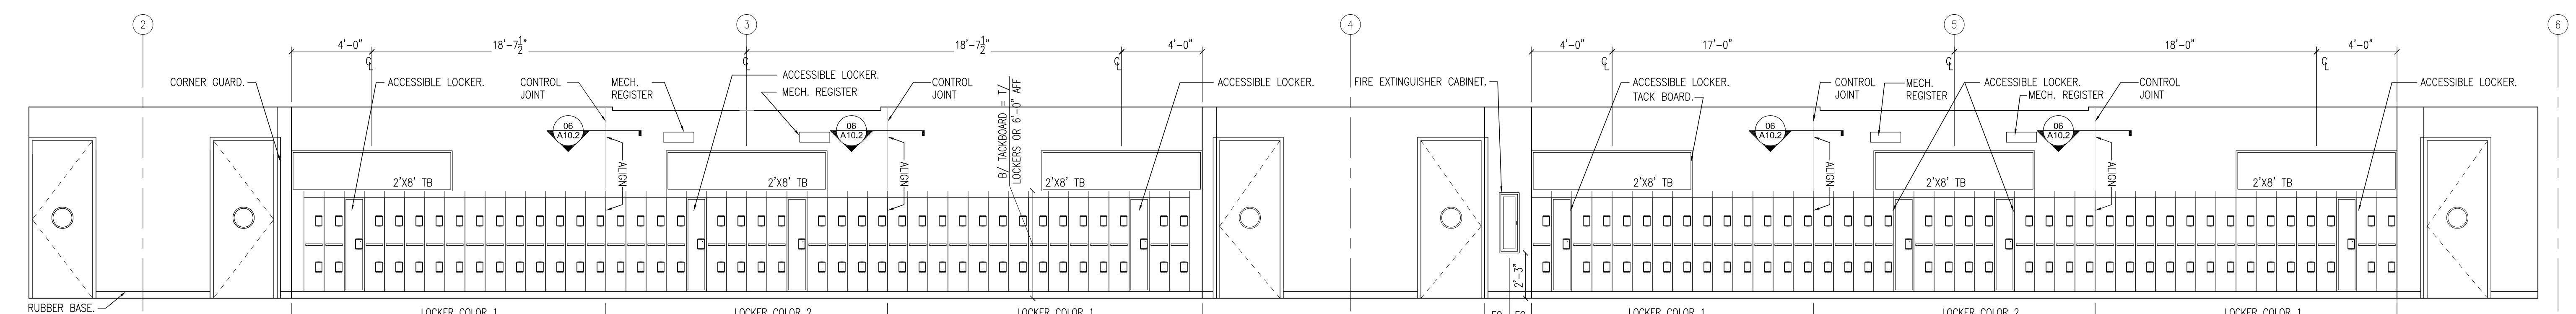

01 CORRIDOR 230-NORTH ELEVATION

SCALE: 1/4" = 1'-0"

ENVIRONMENTAL NOTE:
WARNING: LEAD-BASED PAINT MAY BE PRESENT WITHIN THE BUILDING. IT IS THE RESPONSIBILITY OF THE CONTRACTOR TO TAKE APPROPRIATE SAFETY MEASURES IN ACCORDANCE WITH APPLICABLE FEDERAL, STATE, AND LOCAL RULES AND REGULATIONS INCLUDING OSHA (1926.62) COMPLIANCE, WASTE CHARACTERIZATION AND WASTE DISPOSAL. ALL WORK WITH SURFACES CONTAINING LEAD-BASED PAINT SHALL BE DONE IN ACCORDANCE WITH SECTION 02 83 19.13.
GENERAL NOTE:
PLANS & ELEVATIONS. SEE ROOM FINISH SCHEDULE FOR EXTENT OF FINISH WORK @ EXISTING BLDG. CORRIDORS



EDISON PARK ELEMENTARY SCHOOL ANNEX

6220 N. OLCOTT AVE
CHICAGO, IL 60631
CHICAGO PUBLIC SCHOOLS
CPS
CITY OF CHICAGO, MAYOR RAHM EMANUEL

THESE DRAWINGS HAVE BEEN PREPARED AT AND FOR UNDER MY SUPERVISION AND TO THE BEST OF MY KNOWLEDGE AND BELIEF CONFORM AND COMPLY WITH THE REQUIREMENTS OF THE CHICAGO DEPARTMENT OF BUILDING.

ILLINOIS
KATHLEEN O'DONNELL
REGISTERED ARCHITECT
001-016351
EXPIRATION DATE: NOVEMBER 30, 2014

TRIPARTITE, INC
Architecture Restoration Design
4720 N. Virginia Ave.
Chicago, Illinois 60625
P: 773-581-0894
www.tripartiteinc.com

MATRIX ENGINEERING CORPORATION
3318 JACKSON BLVD., 4TH FLOOR / CHICAGO, IL 60654
STRUCTURAL ENGINEERING

SITE DESIGN GROUP, LTD.
1818 WICKHAM AVE., SUITE 1001 / CHICAGO, IL 60605
LANDSCAPE DESIGN

TERRA ENGINEERING, LTD.
235 W. OHIO STREET, 4TH FLOOR / CHICAGO, IL 60654
CIVIL ENGINEERING

CALOR DESIGN GROUP, LTD.
2017 N. WESTERN AVE. / CHICAGO, IL 60647
MECHANICAL, PLUMBING, FIRE PROTECTION

TECHKNOW ENGINEERING, LLC
1516 KENNESAW AVE., SUITE 1100 / CHICAGO, IL 60605
QUALITY CONTROL, LOW VOLTAGE, SECURITY, FIRE ALARM

HJ KESSLER ASSOCIATES
1880 N. LAKE SHORE DRIVE, SUITE 501 / CHICAGO, IL 60613
LEED CONSULTANT

EDGE ASSOCIATES, INC
205 E. LAKE STREET, SUITE 303 / AUBURN, IL 60011
FOOD SERVICES

DOOR SECURITY SOLUTIONS
1114 KOSTER AVE., BENSenville, IL 60018
HARDWARE CONSULTANT

PIN DROP ACOUSTICS
2017 W. LAKE STREET, #100 / CHICAGO, IL 60608
ACOUSTIC CONSULTANT

ISSUANCE

MARK	DESCRIPTION	DATE
1	ISSUE FOR BID	12-18-2012
2	ADDENDUM 1	01-17-2013
3	----	----
4	----	----
5	----	----
6	----	----
7	----	----
8	----	----

SCALE: AS NOTED
PLOT DATE: 1/17/2013
PBC PROJECT W/ EDISON PARK ELEMENTARY SCHOOL ANNEX
PBC CONTRACT NO.: --
PROJECT NO.: 09560

WARNING:
ASBESTOS-CONTAINING BUILDING MATERIALS ARE OR MAY BE PRESENT IN THIS BUILDING. AN ASBESTOS MANAGEMENT PLAN IS AVAILABLE IN THE SCHOOL. FOR REVIEW UPON REQUEST. NO PERSON SHALL REMOVE OR DESTROY ASBESTOS-CONTAINING MATERIALS UNLESS THAT PERSON IS A LICENSED ASBESTOS WORKER OR CONDUCTS SUCH WORK IN ACCORDANCE WITH THE SPECIFICATIONS CONTAINED IN THE PROJECT DOCUMENTS AND IN COMPLIANCE WITH ILLINOIS DEPARTMENT OF HEALTH RULES AND REGULATIONS.

TITLE:
ENLARGED PLANS
AND ELEVATIONS AT
SECOND FLOOR

SHEET

A9.6

EDISON PARK ELEMENTARY SCHOOL ANNEX

6220 N. OLCOTT AVE
CHICAGO, IL 60631
CHICAGO PUBLIC SCHOOLS
CITY OF CHICAGO, MAYOR RAHM EMANUEL

THESE DRAWINGS HAVE BEEN PREPARED AT AND / OR UNDER MY SUPERVISION AND TO THE BEST OF MY KNOWLEDGE AND BELIEF CONFORM AND COMPLY WITH THE REQUIREMENTS OF THE CHICAGO DEPARTMENT OF BUILDINGS.

ILLINOIS
KATHLEEN O'DONNELL
REGISTERED ARCHITECT
001-016351
EXPIRATION DATE: NOVEMBER 30, 2014

TRIPARTITE, INC
Architecture Restoration Design

4720 N. Virginia Ave.
Chicago, Illinois 60625
P: 773-681-0894
www.tripartiteinc.com

MATRIX ENGINEERING CORPORATION
28 W. JACKSON BLDG. 4TH FLOOR CHICAGO, IL 60604
STRUCTURAL ENGINEERING

SITE DESIGN GROUP, LTD.
881 S. MICHIGAN AVE. SUITE 1000 CHICAGO, IL 60605
LANDSCAPE DESIGN

TERRA ENGINEERING, LTD.
225 W. GRAND STREET 4TH FLOOR CHICAGO, IL 60604
CIVIL ENGINEERING

CALOR DESIGN GROUP, LTD.
221 W. WASHINGTON AVE. CHICAGO, IL 60601
MECHANICAL, PLUMBING, FIRE PROTECTION

TECHKNOW ENGINEERING LLC
30 E. ADAMS ST. SUITE 1100 CHICAGO, IL 60603
QUALITY CONTROL, LOW VOLTAGE SECURITY, FIRE ALARM

H. KESSLER ASSOCIATES
3600 LAKE SHORE DRIVE, SUITE 801 CHICAGO, IL 60633
LEED CONSULTING

EDGE ASSOCIATES, INC
220 E. LAKE STREET, SUITE 303 ADDISON, IL 60101
FOOD SERVICE

DOOR SECURITY SOLUTIONS
718 FOSTER AVE. BENSenville, IL 60106
HANDYMAN CONSULTANT

PN DROP ACOUSTICS
251 W. LAKE STREET 4TH FLOOR CHICAGO, IL 60606
ACOUSTIC CONSULTANT

ISSUANCE

MARK	DESCRIPTION	DATE
1	ISSUE FOR PERMIT	12-18-12
2	ISSUE FOR ADDENDUM 1	1-17-13
3		
4		
5		
6		
7		
8		

SCALE: AS NOTED

PLOT DATE: 12/14/2012

PBC PROJECT: EDISON PARK ELEMENTARY SCHOOL ANNEX

PBC CONTRACT NO.: C1547


PROJECT NO.: 05650

WARNING:
ASBESTOS-CONTAINING BUILDING MATERIALS ARE OR MAY BE PRESENT IN THIS BUILDING. AN ASBESTOS MANAGEMENT PLAN IS AVAILABLE IN THE PROJECT MANUAL. FOR MORE INFORMATION, CONTACT THE PROJECT MANAGER. NO PERSON SHALL DISTURB ASBESTOS-CONTAINING MATERIALS UNLESS THAT PERSON IS A LICENSED ASBESTOS WORKER OR CONDUCTS SUCH WORK IN ACCORDANCE WITH SPECIFIC PROCEDURES CONTAINED IN THE PROJECT DOCUMENTS AND IN COMPLIANCE WITH ILLINOIS DEPARTMENT OF HEALTH RULES AND REGULATIONS.

TITLE:
BASEMENT/FDN.
PLAN

SHEET

S1.0

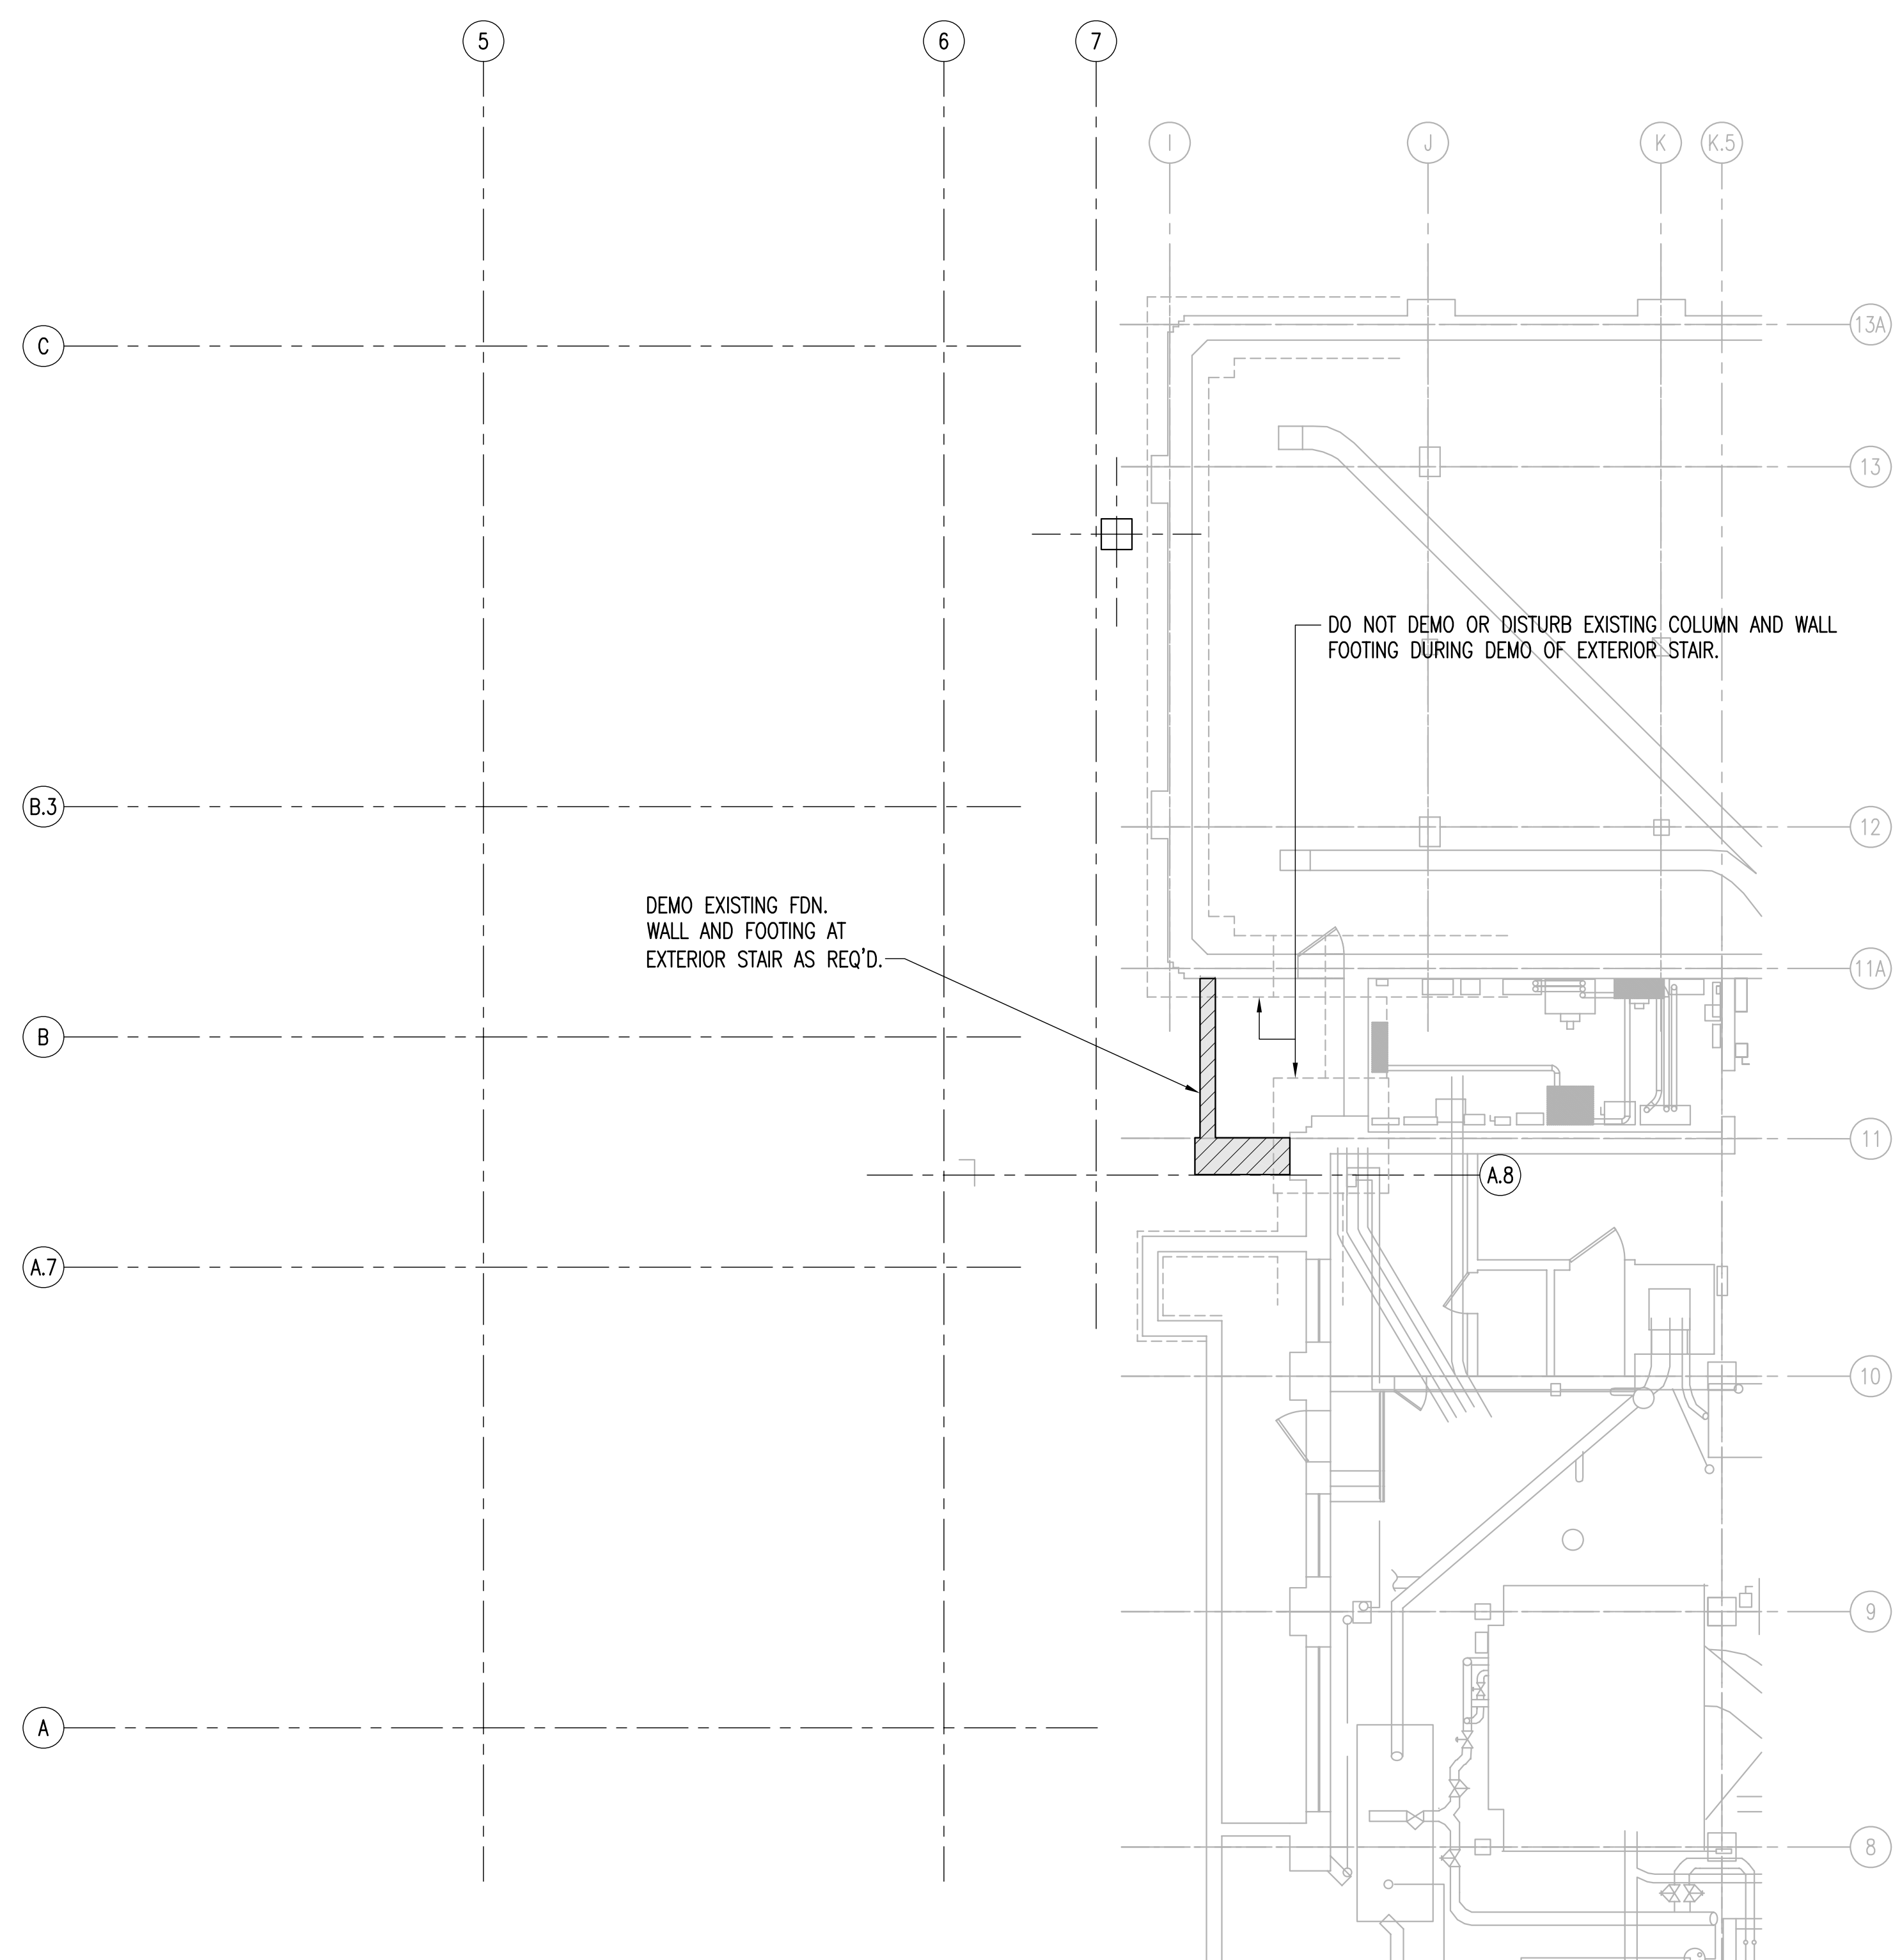

EXISTING BASEMENT/FOUNDATION DEMO PLAN (STRUCTURAL SCOPE ONLY)

1/8"=1'-0"


NOTES:

1. VERIFY ALL DIMENSIONS AND ELEVATIONS WITH ARCHITECTURAL DRAWINGS PRIOR TO CONSTRUCTION.
2. SEE S0.1 & S0.2 FOR GENERAL STRUCTURAL NOTES.

STEEL COLUMN SCHEDULE									
MARK	C1	C2	C3	C3A	C4	C4A	C5	C6	C7
T/ACOUSTICAL BARRIER EL. SEE ARCH.								HSS6x6x7/8	
T/ROOF EL. SEE PLAN									
T/2ND FLOOR EL. SEE PLAN	W10x33	W10x49	W10x60	W10x60	W10x68	W10x88	W10x100	SEE NOTE 4	
T/1ST FLOOR EL. SEE PLAN	W10x33	W10x49	W10x60	W10x60	W10x68	W10x88	W10x100	HSS6x6x0.375	
BASE PLATE	W	17"	17"	17"	17"	17"	17"	17"	10"
	L	17"	17"	17"	17"	17"	17"	17"	12"
	t	1"	1 1/2"	1 3/4"	1 3/4"	2"	2"	2"	3/4"
ANCHOR BOLTS	#-8	(4) 3/4"	(4) 3/4"	(4) 1 1/2"	(4) 1 1/2"	(4) 1 1/2"	(4) 1 1/2"	(4) 1 1/2"	(4) 3/4"
EMBED.	1'-0"	1'-0"	1'-6"	1'-6"	1'-6"	1'-6"	1'-6"	1'-6"	
REMARKS	SEE DETAIL 2/S4.0 FOR BASE PLATES AT COLUMNS WITH BRACE CONNECTIONS.							SEE DTL. 6/S3.4	

NOTES:

1. SEE TYPICAL BASE PLATE DETAIL 14/S2.0 FOR MORE INFORMATION.
2. ALL COLUMNS SHALL BE ERECTED AS ONE MEMBER; IT IS NOT ACCEPTABLE TO INSTALL A FIELD SPLICE.
3. SEE ARCHITECTURAL DRAWINGS FOR INFORMATION ON CEILING AND BASE CLOSURE PLATES.
4. STEEL-JACKET, CONCRETE-ENCASED FIRE-RATED COLUMN OCCUR AT 1ST FLOOR: B/3 & B/5, AND 2ND FLOOR: B/4 & B/6. SEE ARCH. DWGS, FOR SIZE & EXTENT OF ENCASEMENT.

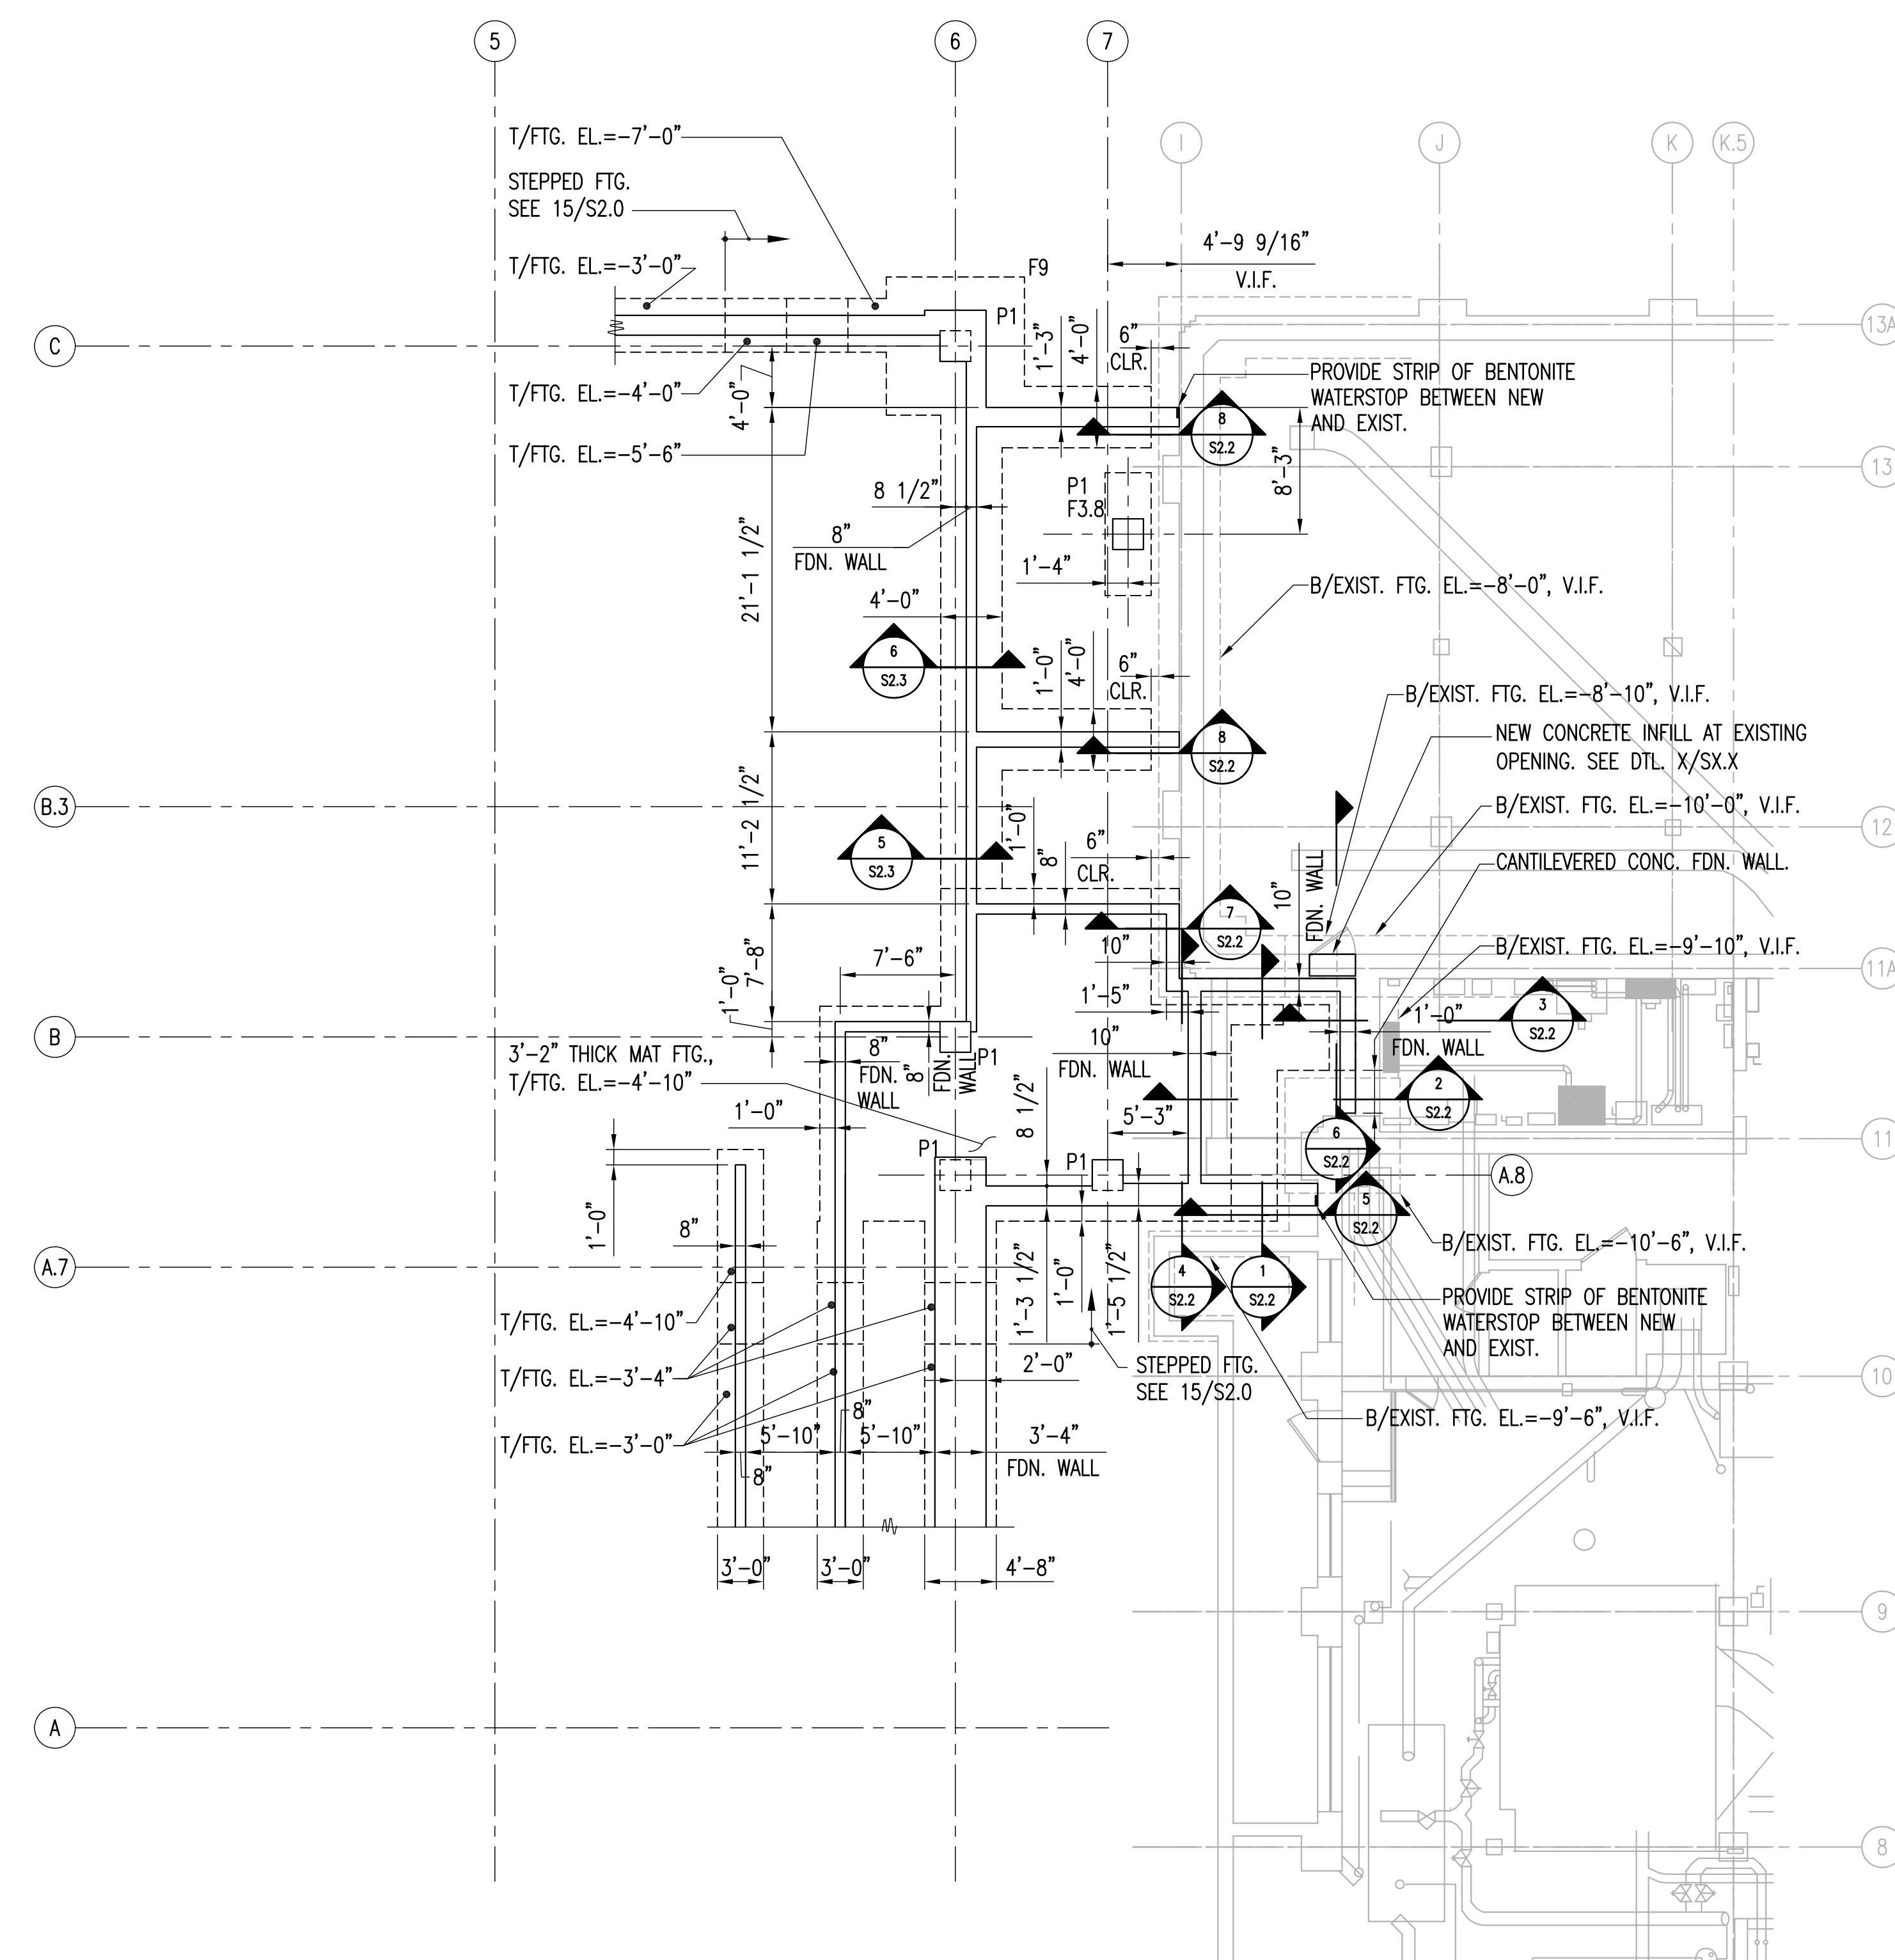

BASEMENT/FOUNDATION PLAN

1/8"=1'-0"

NOTES:

1. VERIFY ALL DIMENSIONS AND ELEVATIONS WITH ARCH. DWGS. PRIOR TO CONSTRUCTION.
2. SEE S0.1 & S0.2 FOR GENERAL STRUCTURAL NOTES.
3. SEE DETAILS 4/S2.0 AND 5/S2.0 FOR TYPICAL CONCRETE WALL REINF. DETAILING INFORMATION.
4. THICKEN SLAB-ON-GRADE AS INDICATED IN DETAIL 2/S2.1 OR 4/S2.1 AT ALL NON-LOAD BEARING MASONRY WALLS (U.N.O.). REFER TO ARCHITECTURAL FOR SCOPE AND EXTENTS. SEE DETAILS 2/S3.2, 3/S3.2 OR 4/S3.2 FOR TYPICAL BRACING AT TOP OF MASONRY WALLS.
5. PROVIDE 2-#4 x 4'-0" TOP AND BOTTOM OF CONCRETE SLAB-ON-GRADE AT ALL RE-ENTRANT CORNER LOCATIONS (TYP.).
6. SEE ARCH. AND MEP DRAWINGS FOR CURBS AND MECHANICAL EQUIPMENT PADS. SEE DETAIL 6/S2.0 AND 7/S2.0 FOR INFORMATION. FINAL LOCATIONS & SIZES SHALL BE COORDINATED W/MEP EQUIPMENT MANUFACTURER. VERIFY SIZE AND LOCATION OF SLAB DEPRESSIONS WITH THE ARCHITECTURAL DRAWINGS.
7. "FX" INDICATES CONCRETE FOOTING. SEE SCHEDULE ON SHT. S1.0.
8. "PX" INDICATES CONCRETE PIER. SEE SCHEDULE ON SHEET S1.0.

CONCRETE FOOTING SCHEDULE						
MARK	SIZE			REINFORCEMENT		REMARKS
	L	S	D	LONG WAY	SHORT WAY	
F3.8	8'-0"	3'-0"	1'-0"	(3)-#5	(8)-#5	NOTE 2
F9, F9A	9'-0"	9'-0"	1'-6"	(9)-#7	(9)-#7	
F10, F10A	10'-0"	10'-0"	1'-6"	(10)-#7	(10)-#7	
F11, F11A	11'-0"	11'-0"	2'-0"	(11)-#7	(11)-#7	
F12, F12A	12'-0"	12'-0"	2'-0"	(12)-#7	(12)-#7	
F13	13'-0"	13'-0"	2'-0"	(13)-#9	(13)-#9	
F14, F14A	14'-0"	14'-0"	2'-6"	(14)-#9	(14)-#9	
F15	15'-0"	15'-0"	2'-6"	(15)-#9	(15)-#9	


NOTES:

1. REINFORCEMENT INDICATED IS AT BOTTOM LAYER ONLY U.N.O. "FX.XA" INDICATES FOOTING WITH EQUAL REINFORCEMENT AT TOP & BOTTOM LAYER. ADHERE TO MINIMUM REINF. COVER REQUIREMENTS SPECIFIED IN THE GENERAL STRUCTURAL NOTES ON SHEET S0.1.
2. PROVIDE STANDARD 90° HOOK AT EACH END OF REINFORCEMENT.

CONCRETE PIER SCHEDULE					
PIER MARK	SIZE W x L	REINFORCEMENT		T/PIER EL.	REMARKS
		VERTICAL	TIES		
P1	24"x24"	(8)-#8	#4 AT 12"	-1'-0" (U.N.O. ON PLAN)	
P2	36"x36"	(16)-#8	#4 AT 12"	-1'-0" (U.N.O. ON PLAN)	
P3	48"x48"	(24)-#9	#4 AT 12"	-1'-0" (U.N.O. ON PLAN)	
P4	16"x16"	(4)-#7	#3 AT 12"	COORD. W/ GATE MFR.	

NOTES:

1. SEE FOUNDATION WALL SECTIONS FOR WALL REINFORCEMENT.
2. DASHED LINE ON PIER DETAILS INDICATES LIMITS OF DEPRESSED AREA OF COLUMN BASE. FILL ALL POCKETS WITH CONCRETE AFTER STEEL FRAME IS ERECTED AND PLUMB.
3. FOR TYPICAL INTERIOR CONCRETE PIER AT FOOTING SEE SECTION 13/S3.1 SEE 8/S3.2 AND 10/S3.2 FOR TYPICAL EXTERIOR CONCRETE PIER AT FOOTING.

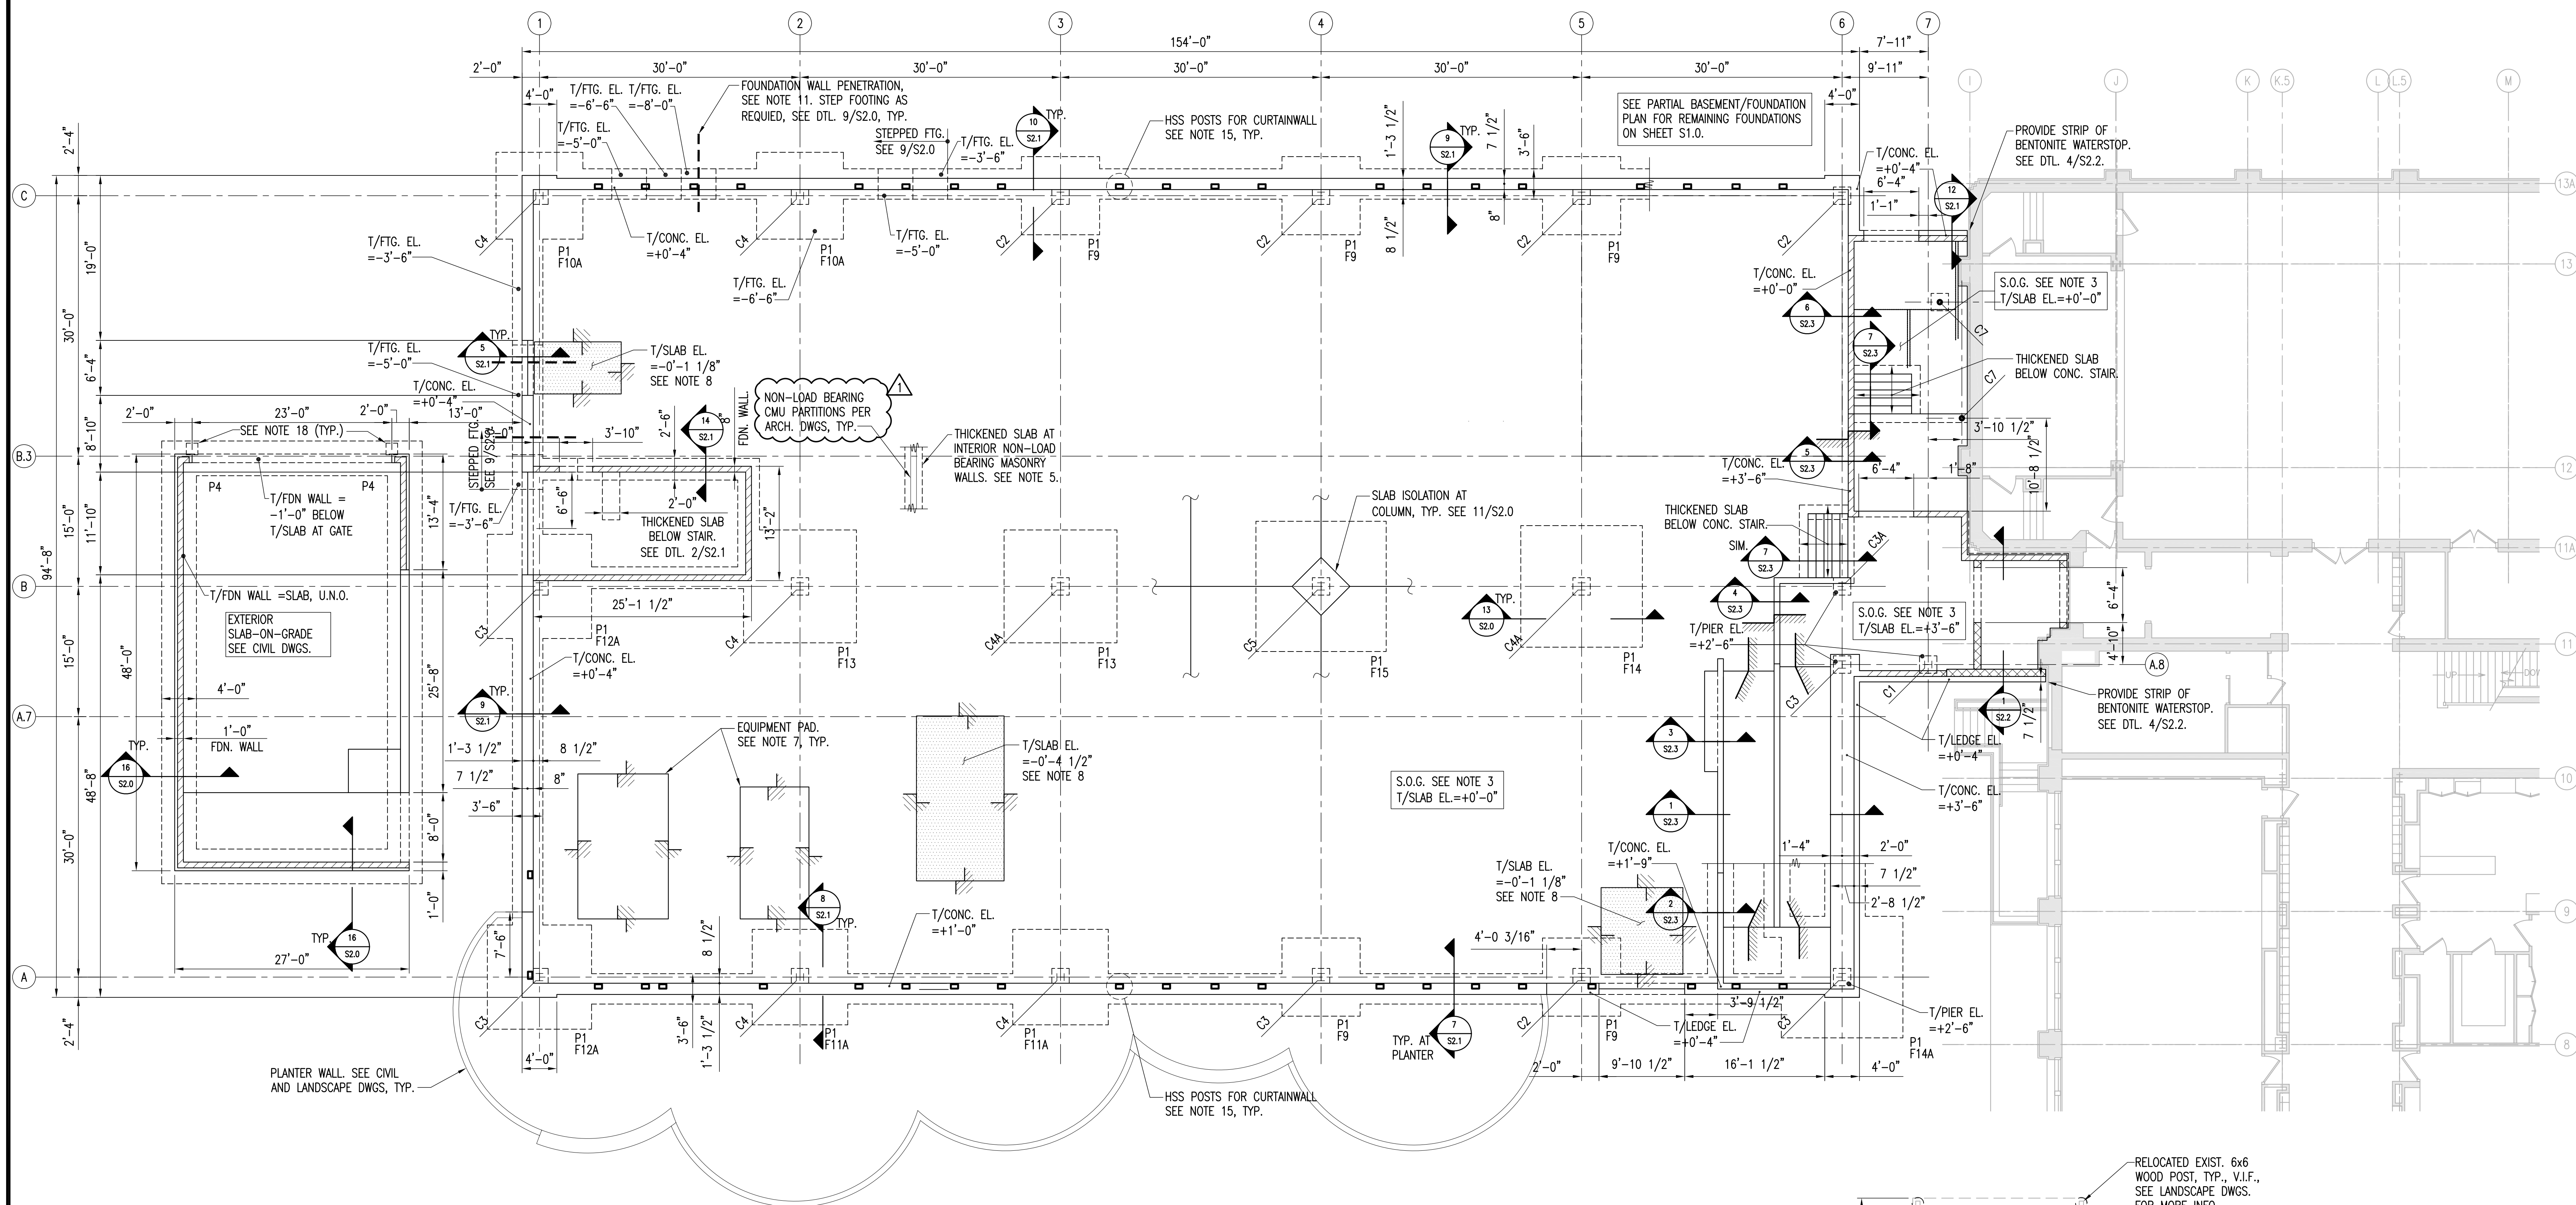

FIRST FLOOR/FOUNDATION PLAN

1/8"=1'-0"



- NOTES:**
1. VERIFY ALL DIMENSIONS AND ELEVATIONS WITH ARCH. DWGS. PRIOR TO CONSTRUCTION.
 2. SEE S0.1 & S0.2 FOR GENERAL STRUCTURAL NOTES.
 3. S.O.G. INDICATES 5" CONCRETE SLAB-ON-GRADE W/4x4-W4.0xW4.0 WMF OVER VAPOR BARRIER OVER 6" GRANULAR FILL OVER ENGINEERED FILL AS REQUIRED IN SOIL REPORT. (TYP.) SEE TYPICAL DETAILS 1/S2.0, 2/S2.0 AND 3/S2.0. PROVIDE CONSTRUCTION/CONTROL JOINTS AT 15'-0" MAXIMUM IN EA. DIRECTION (TYP.). SUBMIT JOINT LAYOUT FOR REVIEW PRIOR TO PLACING SLAB-ON-GRADE. COORDINATE JOINT LOCATIONS WITH ARCH. DWGS. T/SLAB EL. +0'-0" U.N.O.
 4. SEE DETAILS 4/S2.0 AND 5/S2.0 FOR TYPICAL CONCRETE WALL REINF. DETAILING INFORMATION.
 5. THICKEN SLAB-ON-GRADE AS INDICATED IN DETAIL 2/S2.1, 3/S2.1 OR 4/S2.1 AT ALL NON-LOAD BEARING MASONRY WALLS (U.N.O.). REFER TO ARCHITECTURAL FOR SCOPE AND EXTENTS. SEE DETAILS 2/S2.2, 3/S3.2 AND 4/S3.2 FOR TYPICAL BRACING AT TOP OF MASONRY WALLS.
 6. PROVIDE 2-#4 x 4'-0" TOP AND BOTTOM OF CONCRETE SLAB-ON-GRADE AT ALL RE-ENTRANT CORNER LOCATIONS (TYP.).
 7. SEE ARCH. AND MEP DRAWINGS FOR CURBS AND MECHANICAL EQUIPMENT PADS. SEE DETAIL 6/S2.0 AND 7/S2.0 FOR INFORMATION. FINAL LOCATIONS & SIZES SHALL BE COORDINATED W/MEP EQUIPMENT MANUFACTURER. VERIFY SIZE AND LOCATION OF SLAB DEPRESSIONS WITH THE ARCHITECTURAL DRAWINGS.
 8. [Symbol] INDICATES DEPRESSED SLAB. SEE 8/S2.0 FOR DETAIL. COORD. W/ARCH. DWG. FOR LOCATIONS. GENERAL CONTRACTOR TO COORDINATE WITH EQUIPMENT PROVIDERS FOR FINAL PLAN DIMENSIONS AND DEPTH OF DEPRESSIONS.
 9. [Symbol] INDICATES 8" CMU WALL W/#5 AT 24" O.C. VERTICAL BARS. SEE SHEET S5.0 FOR DETAILS, TYP.
 10. [Symbol] INDICATES 10" CMU WALL W/#5 AT 24" O.C. VERTICAL BARS. SEE SHEET S5.0 FOR DETAILS, TYP.
 11. SEE MEP DRAWINGS FOR LOCATIONS AND ELEVATIONS OF FOUNDATION WALL PENETRATIONS. SEE DETAIL 9/S2.0 AND 10/S2.0 FOR ADD'L REINF. REQUIREMENT.
 12. "Cx" INDICATES STEEL COLUMN. SEE S1.0 FOR COLUMN SCHEDULE. SEE ARCH. DWGS. FOR SIZE AND EXTENT OF FIRE-RETARDANT COLUMN ENCASEMENT.
 13. VERTICAL & HORIZONTAL REBAR ALONG THE EXTERIOR FACE OF THE FOUNDATION WALL EXPOSED TO WEATHER SHALL BE EPOXY COAT.
 14. T/FDN. WALL EL. = +2'-8" (TYP. U.N.O.); T/FDN. WALL EL. @ DOOR = -1'-0" (U.N.O.); T/FTG. EL. = -3'-0" (TYP. U.N.O.)
 15. SEE SHEET S6.0 FOR WINDOW/WINDOW WALL SUPPORT FRAMING ELEVATIONS AND INFORMATION. SEE DETAIL 11/S2.1 FOR HSS POST CONNECTION TO FDN. WALL.
 16. "Px" INDICATES CONCRETE PIER. SEE PIER SCHEDULE ON SHEET S1.0. T/PIER EL. -1'-0" (TYP. U.N.O.)
 17. "Fx" INDICATES CONCRETE FOOTING. SEE FOOTING SCHEDULE ON SHEET S1.0. T/FTG. EL. -3'-0" (TYP. U.N.O.)
 18. POSTS, PIER SIZES, AND FOOTINGS SHOWN ON PLAN FOR GATE POSTS ARE FOR BID PURPOSES ONLY. CONTRACTOR SHALL COORDINATE FINAL SIZES WITH GATE POST PROVIDER AND POUR CONCRETE PIERS FOR THE GATE POST INTEGRALLY WITH THE FOUNDATION WALL/FTG. SEE 1/S2.1 FOR ADD'L INFORMATION.

PERGOLA FOUNDATION PLAN

1/8"=1'-0"



- NOTES:**
1. VERIFY ALL DIMENSIONS AND ELEVATIONS WITH ARCH. DWGS. PRIOR TO CONSTRUCTION.
 2. SEE S0.1 & S0.2 FOR GENERAL STRUCTURAL NOTES.
 3. "ST1" INDICATES 1'-4" x 7'-0" DEEP SONOTUBE WITH (6)#6 VERT. REINF. AND #4 TIES AT 12" O.C.



EDISON PARK ELEMENTARY SCHOOL ANNEX
 6220 N. OLCOTT AVE
 CHICAGO, IL 60631
 CHICAGO PUBLIC SCHOOLS
 CITY OF CHICAGO, MAYOR RAHM EMANUEL

THESE DRAWINGS HAVE BEEN PREPARED AT AND / OR UNDER MY SUPERVISION AND TO THE BEST OF MY KNOWLEDGE AND BELIEF CONFORM AND COMPLY WITH THE REQUIREMENTS OF THE CHICAGO DEPARTMENT OF BUILDINGS.

ILLINOIS
 KATHLEEN O'DONNELL
 REGISTERED ARCHITECT
 001-016651
 EXPIRATION DATE: NOVEMBER 30, 2014

TRIPARTITE, INC.
 Architecture Restoration Design
 4720 N. Virginia Ave.
 Chicago, Illinois 60625
 P: 773-681-0894
 www.tripartiteinc.com

MATRIX ENGINEERING CORPORATION
 31 W. JACKSON BLDG. 4TH FLOOR CHICAGO, IL 60604
 STRUCTURAL ENGINEERING

SITE DESIGN GROUP, LTD.
 888 S. MICHIGAN AVE. SUITE 1000 CHICAGO, IL 60605
 LANDSCAPE DESIGN

TERRA ENGINEERING, LTD.
 221 W. MADISON STREET 4TH FLOOR CHICAGO, IL 60604
 CIVIL ENGINEERING

CALOR DESIGN GROUP, LTD.
 221 W. MADISON AVE. CHICAGO, IL 60604
 MECHANICAL, PLUMBING, FIRE PROTECTION

TECHNOW ENGINEERING, LLC
 30 E. ADAMS ST. SUITE 1100 CHICAGO, IL 60603
 QUALITY CONTROL, LOW VOLTAGE, SECURITY, FIRE ALARM

H. KESSLER ASSOCIATES
 3615 LAKE SHORE DRIVE, SUITE 811 CHICAGO, IL 60613
 LEED CONSULTING

EDGE ASSOCIATES, INC.
 220 E. LAKE STREET, SUITE 303 ADDISON, IL 60101
 FOOD SERVICES

DOOR SECURITY SOLUTIONS
 718 FOSTER AVE. BENSenville, IL 60156
 HARDWARE CONSULTING

PN DROP ACOUSTICS
 251 W. LAKE STREET 4TH FLOOR CHICAGO, IL 60606
 ACOUSTIC CONSULTANT

ISSUANCE

MARK	DESCRIPTION	DATE
1	ISSUE FOR PERMIT	12-18-12
2	ISSUE FOR ADDENDUM 1	1-17-13
3		
4		
5		
6		
7		
8		

SCALE: AS NOTED

PLOT DATE: 12/14/2012

PBC PROJECT: EDISON PARK ELEMENTARY SCHOOL ANNEX


PBC CONTRACT NO.: C1547

PROJECT NO.: 05650

WARNING: ASBESTOS-CONTAINING BUILDING MATERIALS ARE OR MAY BE PRESENT IN THIS BUILDING. AN ASBESTOS MANAGEMENT PLAN IS AVAILABLE IN THE PROJECT INFORMATION REQUEST. NO PERSON MAY DISTURB ASBESTOS-CONTAINING MATERIALS UNLESS THAT PERSON IS A LICENSED ASBESTOS WORKER OR CONDUCTS SUCH WORK IN ACCORDANCE WITH SPECIFIC REGULATIONS CONTAINED IN THE PROJECT DOCUMENTS AND IN COMPLIANCE WITH ILLINOIS DEPARTMENT OF HEALTH RULES AND REGULATIONS.



TITLE:
FIRST FLOOR/FDN. PLAN

SHEET
S1.1

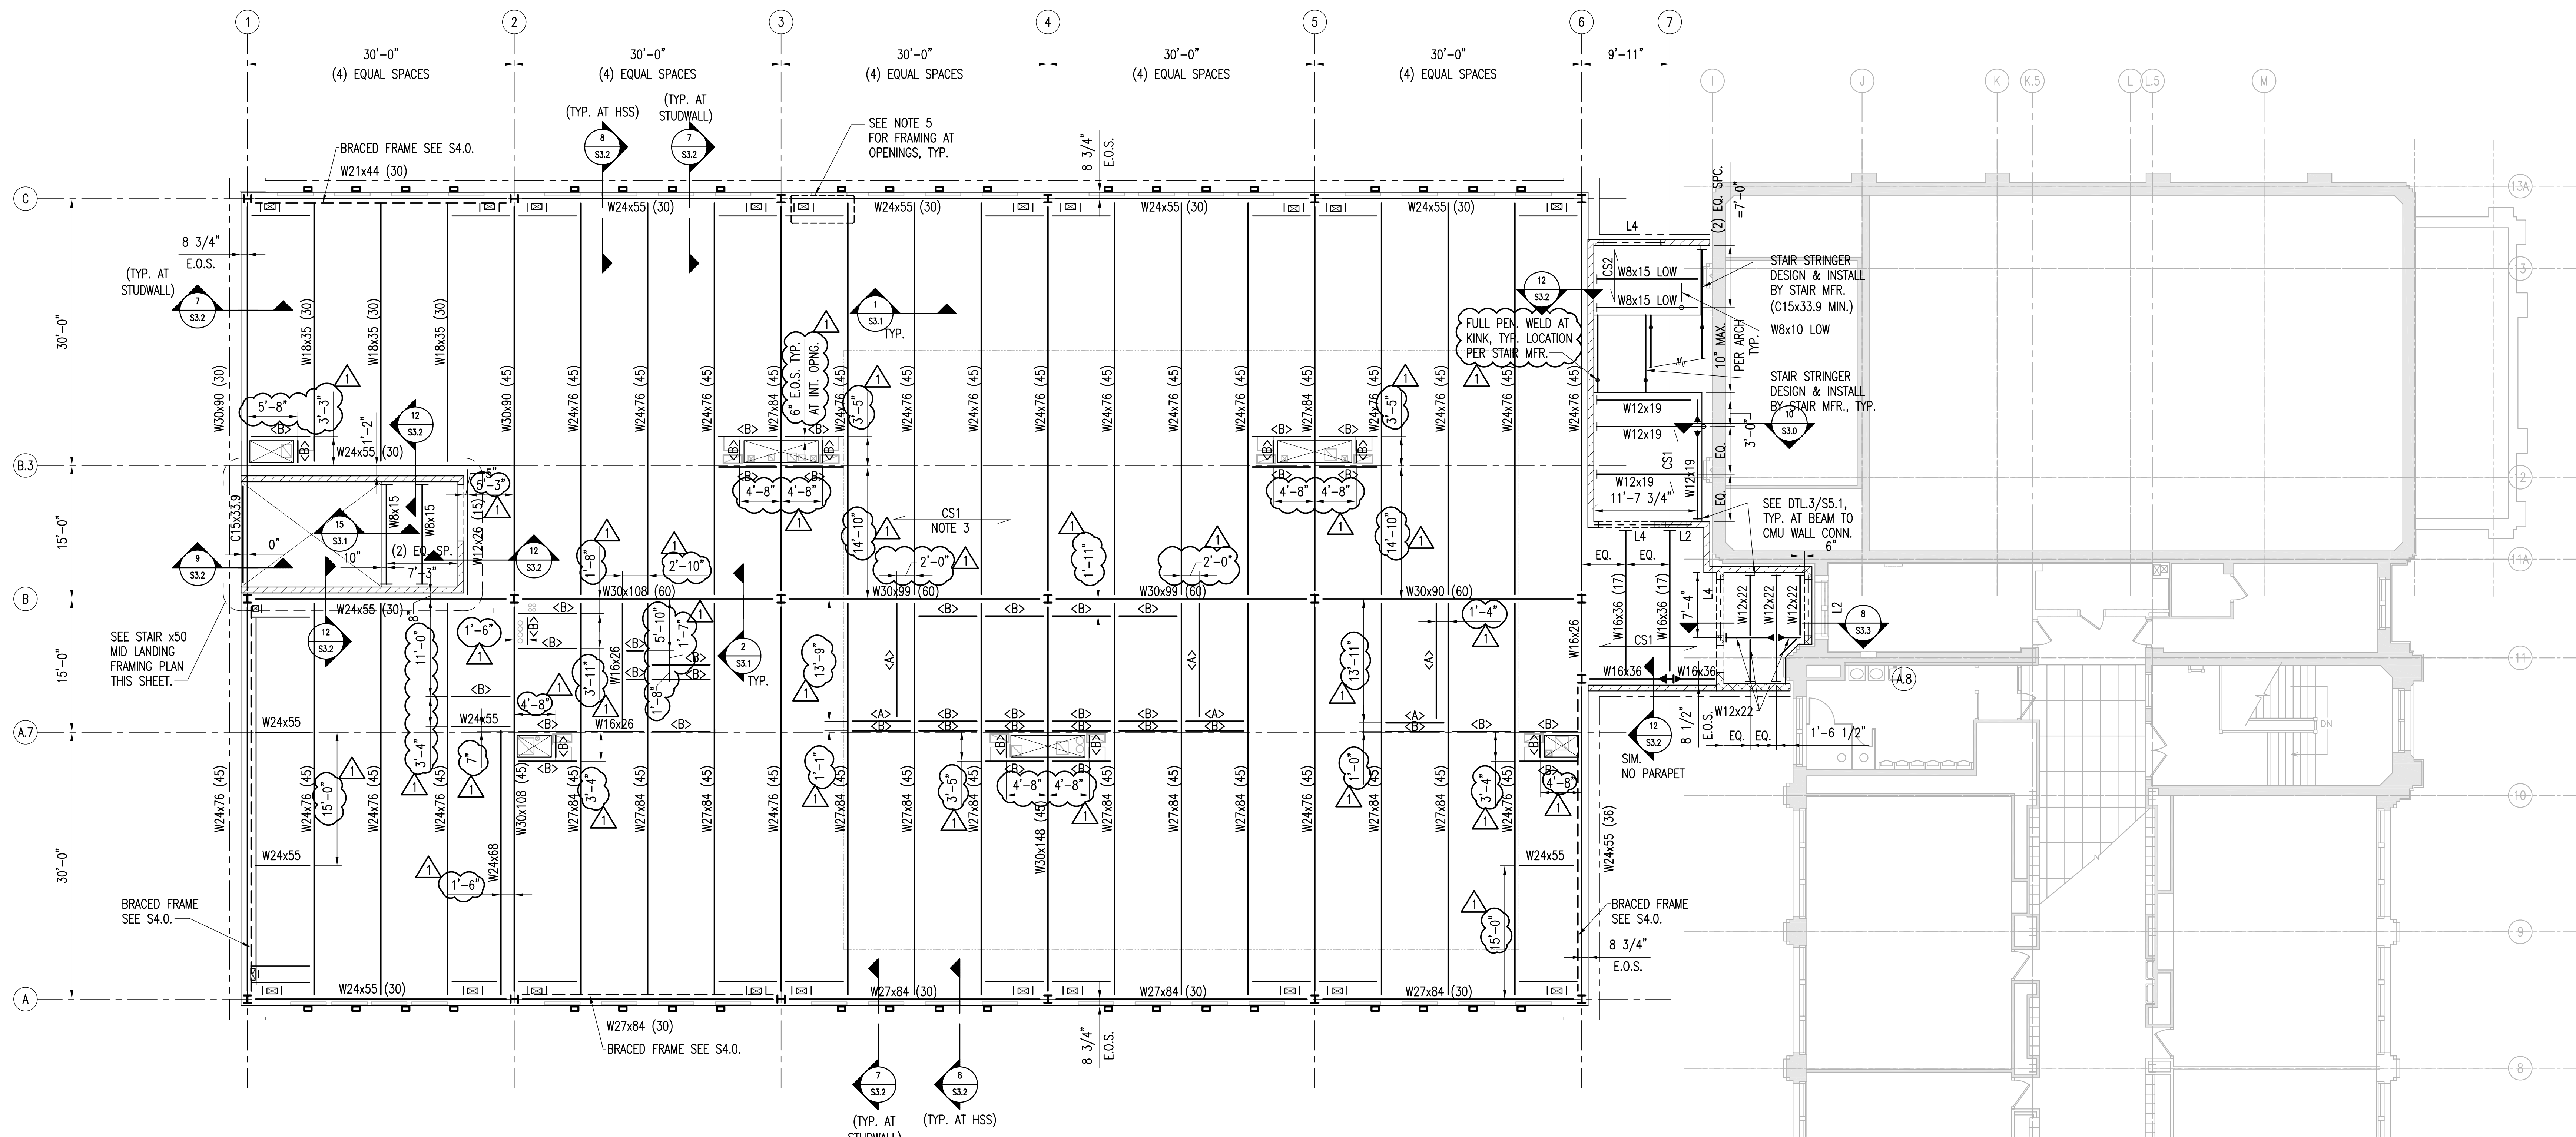

SECOND FLOOR FRAMING PLAN
1/8"=1'-0"

- NOTES:
- VERIFY ALL DIMENSIONS AND ELEVATIONS WITH ARCH. DWGS. PRIOR TO CONSTRUCTION. COORDINATE SIZE AND LOCATION OF ALL OPENINGS/PENETRATIONS WITH ARCHITECTURAL AND MECHANICAL DRAWINGS. TYPICAL SLAB EDGES AT SLAB OPENINGS/PENETRATIONS SHALL BE 6" OFF THE CENTERLINE OF STEEL FRAMES, U.N.O.
 - SEE S.O.1 & S.O.2 FOR GENERAL STRUCTURAL NOTES. FOR TYPICAL STEEL CONNECTIONS AND TYPICAL SLAB ON DECK CONSTRUCTION, SEE SHEETS S3.0 AND S3.1.
 - CS1 INDICATES 2"x18GA. GALV. COMPOSITE FLOOR DECK W/3 1/4" LIGHT WEIGHT CONCRETE (5 1/4" TOTAL THICKNESS) W/6x6 W1.4xW1.4 WWF.
 - T/SLAB EL.=+17'-0" U.N.O.
 - T/STEEL EL.=+16'-6 3/4" U.N.O.
 - SEE DETAILS 12/S3.1, 13/S3.1 AND 14/S3.1 FOR TYPICAL FRAMING AT OPENINGS. COORDINATE SIZE AND LOCATION OF ALL OPENINGS/PENETRATIONS WITH ARCHITECTURAL AND MECHANICAL DRAWINGS.
 - INDICATES 8" CMU WALL W/#5 AT 24" O.C. VERTICAL BARS. SEE SHEET S5.0 FOR DETAILS, TYP.
 - INDICATES 10" CMU WALL W/#5 AT 24" O.C. VERTICAL BARS. SEE SHEET S5.0 FOR DETAILS, TYP.
 - <A> INDICATES W14x22 STEEL BEAM WITH SHEAR STUDS @ 1'-0" O.C. SEE DETAIL 1/S3.2 FOR ADDITIONAL INFORMATION AT NON-LOAD BEARING MASONRY WALLS ON DECK.
 - INDICATES W8x10 STEEL BEAM WITH SHEAR STUDS (WHERE APPLICABLE) @ 1'-0" AT NON-LOAD BEARING MASONRY WALLS ON DECK. SEE DETAIL 1/S3.2 FOR ADDITIONAL INFORMATION AT NON-LOADING BEARING MASONRY WALLS ON DECK.
 - COORDINATE EDGE OF CONCRETE SLAB AT STAIR SHAFT OPENING WITH STAIR MANUFACTURER TO ACCOMMODATE CLEARANCES AS INDICATED ON ARCH. DWGS. PLACE CONCRETE FILL IN THIS AREA AFTER STAIR ERECTION. CONNECT STAIR SUPPORT TO STEEL BEAM AS PIN CONNECTION (BY STAIR MANUFACTURER). SEE DETAIL 15/S3.1 FOR MORE INFORMATION.
 - SEE ARCH. AND MEP DRAWINGS FOR CURBS AND MECHANICAL EQUIPMENT PADS. SEE DETAIL 6/S2.0 AND 7/S2.0 FOR INFORMATION. FINAL LOCATIONS & SIZES SHALL BE COORDINATED W/MEP EQUIPMENT MANUFACTURER.
 - SEE SHEET S6.0 FOR WINDOW/WINDOW WALL SUPPORT FRAMING ELEVATIONS AND INFORMATION.
 - SEE DETAILS 2 THROUGH 6 ON SHEET S3.2 FOR TYPICAL CMU PARTITION WALL BRACING DETAILS.
 - "LX" INDICATES STEEL LINTEL BELOW. SEE SCHEDULE ON SHEET S5.0, AND EXTERIOR ELEVATIONS ON SHEET S6.0.
 - CS2 INDICATES 2"x18GA. GALV. COMPOSITE FLOOR DECK W/2 1/2" LIGHT WEIGHT CONCRETE (4 1/2" TOTAL THICKNESS) W/6x6-W1.4xW1.4 WWF. T/SLAB EL. VARIES PER ARCH. DWGS.

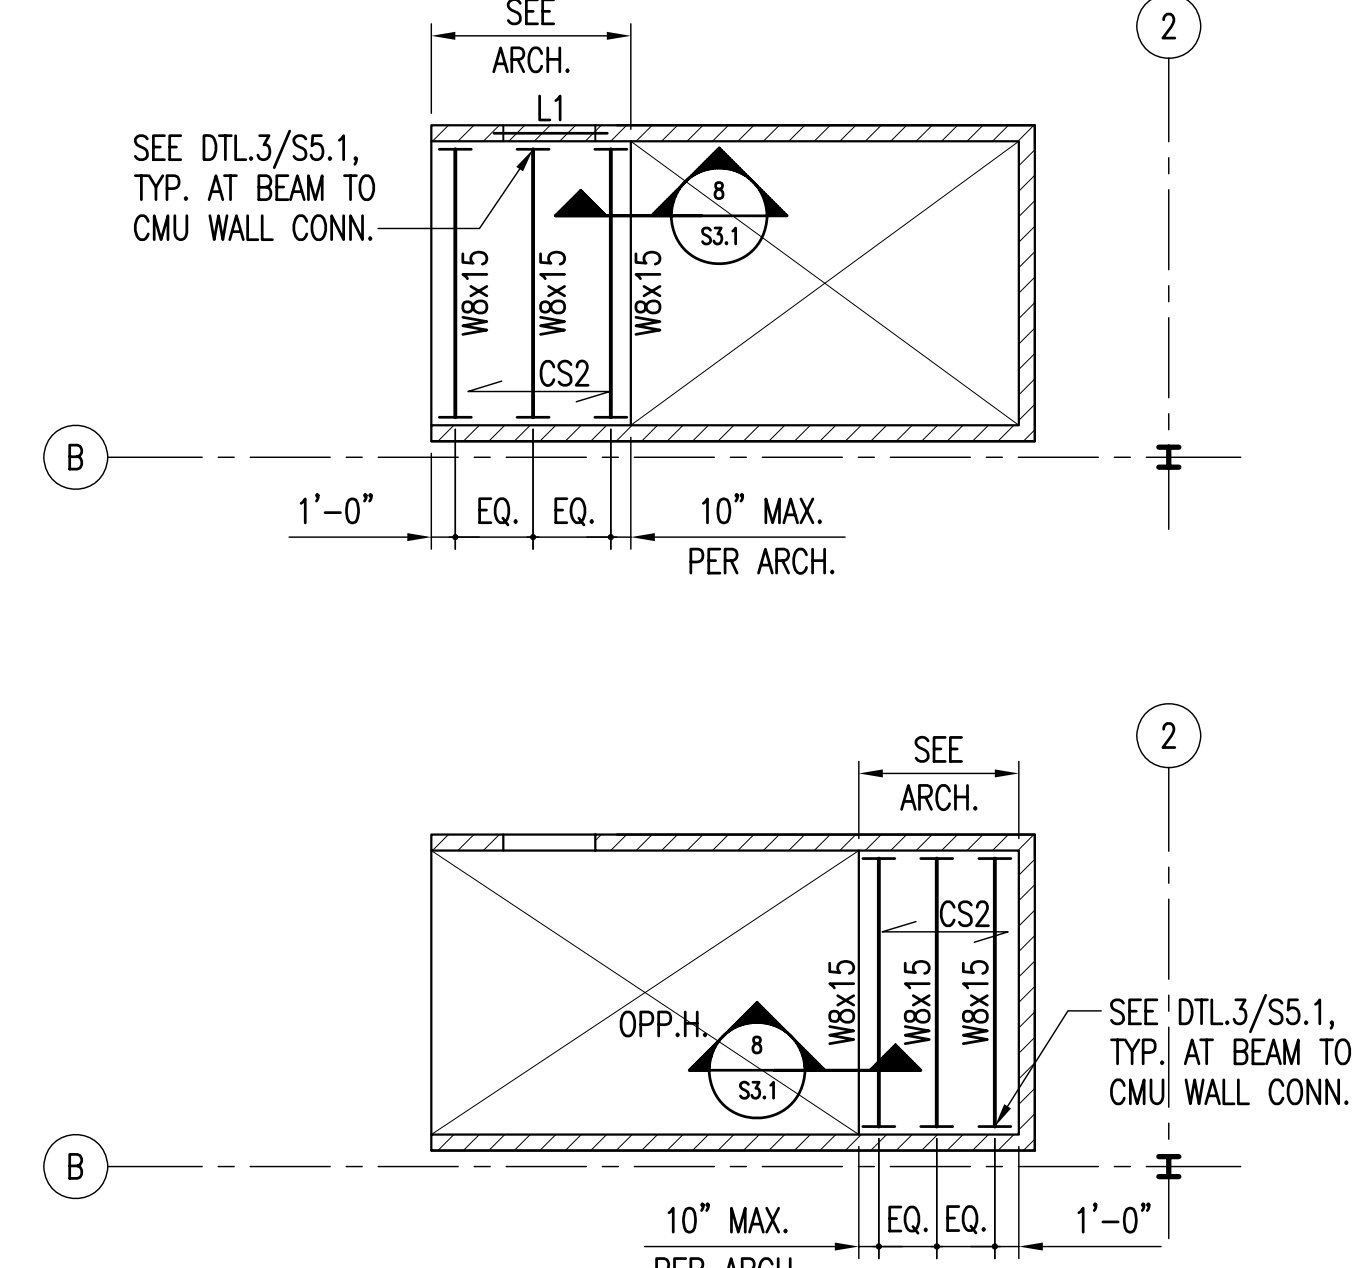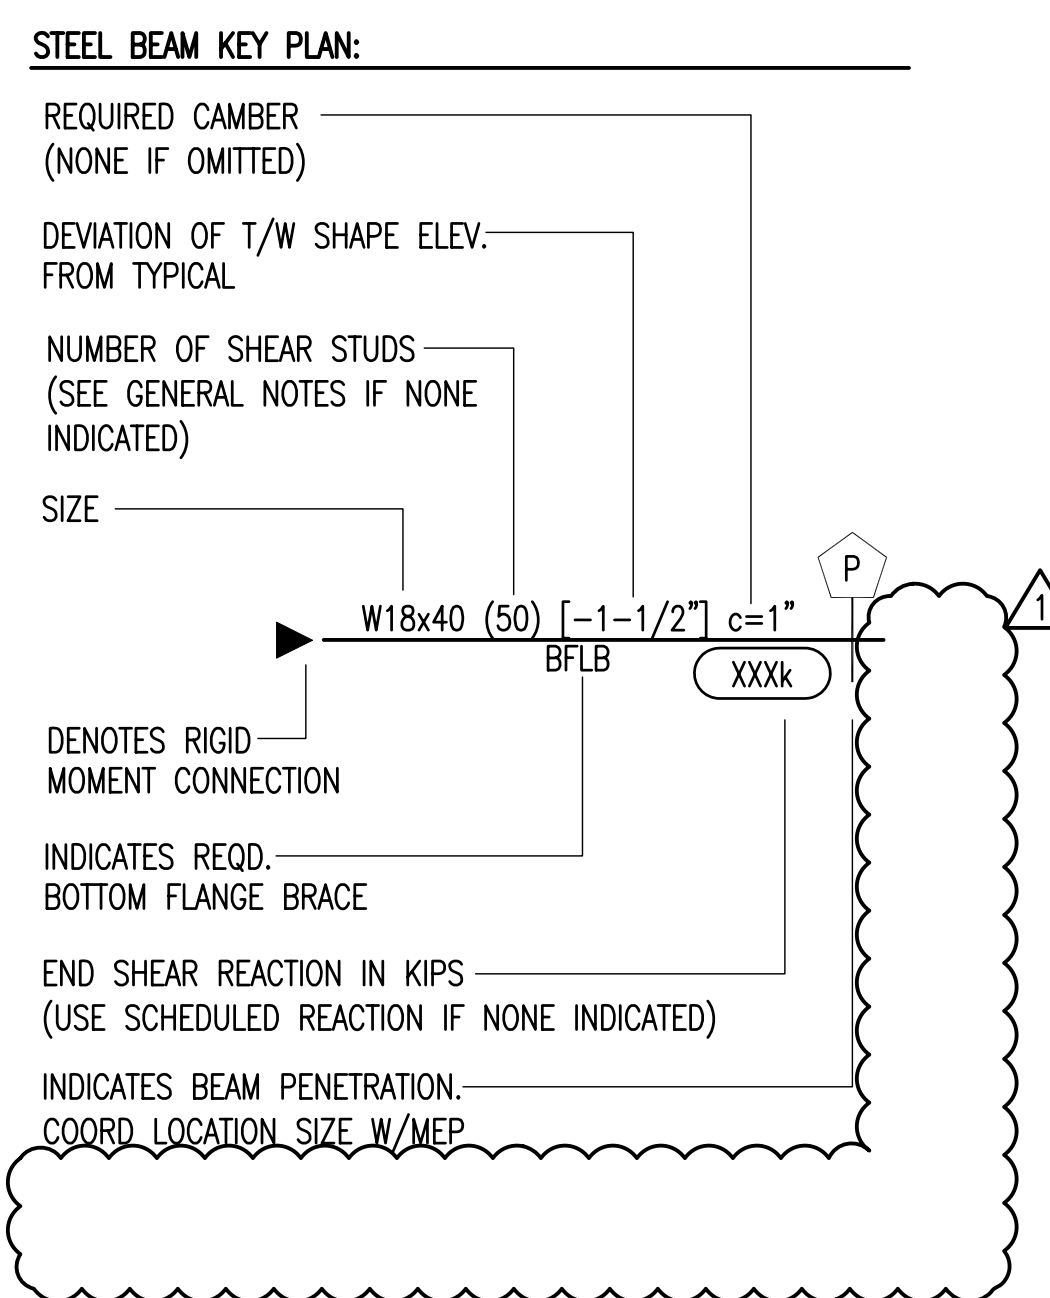

STAIR x50 MID LANDING FRAMING PLAN
1/8"=1'-0"

- NOTES:
- VERIFY ALL DIMENSIONS AND ELEVATIONS WITH ARCH. DWGS. PRIOR TO CONSTRUCTION. COORDINATE SIZE AND LOCATION OF ALL OPENINGS/PENETRATIONS WITH ARCHITECTURAL AND MECHANICAL DRAWINGS. TYPICAL SLAB EDGES AT SLAB OPENINGS/PENETRATIONS SHALL BE 6" OFF THE CENTERLINE OF STEEL FRAMES, U.N.O.
 - SEE S.O.1 & S.O.2 FOR GENERAL STRUCTURAL NOTES. FOR TYPICAL STEEL CONNECTIONS AND TYPICAL SLAB ON DECK CONSTRUCTION, SEE SHEETS S3.0 AND S3.1.
 - CS2 INDICATES 2"x18GA. GALV. COMPOSITE FLOOR DECK W/2 1/2" LIGHT WEIGHT CONCRETE (4 1/2" TOTAL THICKNESS) W/6x6-W1.4xW1.4 WWF. T/SLAB EL. VARIES PER ARCH. DWGS.
 - "LX" INDICATES STEEL LINTEL BELOW. SEE SCHEDULE ON SHEET S5.0.



EDISON PARK ELEMENTARY SCHOOL ANNEX
6220 N. OLCOTT AVE
CHICAGO, IL 60631
CHICAGO PUBLIC SCHOOLS
CITY OF CHICAGO, MAYOR RAHM EMANUEL

THESE DRAWINGS HAVE BEEN PREPARED AT AND / OR UNDER MY SUPERVISION AND TO THE BEST OF MY KNOWLEDGE AND BELIEF CONFORM AND COMPLY WITH THE REQUIREMENTS OF THE CHICAGO DEPARTMENT OF BUILDING.

ILLINOIS
KATHLEEN O'DONNELL
REGISTERED ARCHITECT
001-016351
EXPIRATION DATE: NOVEMBER 30, 2014

TRIPARTITE, INC
Architecture Restoration Design
4720 N. Virginia Ave.
Chicago, Illinois 60625
P: 773-681-0894
www.tripartiteinc.com

MATRIX ENGINEERING CORPORATION
28 W. JACKSON BLDG. 15TH FLOOR / CHICAGO, IL 60604
STRUCTURAL ENGINEERING

SITE DESIGN GROUP, LTD.
881 S. MICHIGAN AVE. SUITE 1000 / CHICAGO, IL 60605
LANDSCAPE DESIGN

TERRA ENGINEERING, LTD.
225 W. GRAND STREET 4TH FLOOR / CHICAGO, IL 60604
CIVIL ENGINEERING

CALOR DESIGN GROUP, LTD.
2617 N. WEBSTER AVE. / CHICAGO, IL 60647
MECHANICAL, PLUMBING, FIRE PROTECTION

TECHNOW ENGINEERING, LLC
30 E. ADAMS ST. SUITE 1100 / CHICAGO, IL 60603
QUALITY CONTROL, LOW VOLTAGE SECURITY, FIRE ALARM

HJ KESSLER ASSOCIATES
360 N. LAKE STREET, DRIVE, SUITE 801 / CHICAGO, IL 60613
LEED CONSULTING

EDGE ASSOCIATES, INC
220 E. LAKE STREET, SUITE 303 / ADDISON, IL 60101
FOOD SERVICE

DOOR SECURITY SOLUTIONS
718 FOSTER AVE. / BENSenville, IL 60156
HANDICAP CONSULTING

PN DROP ACOUSTICS
251 W. LAKE STREET, 4TH FLOOR / CHICAGO, IL 60606
ACOUSTIC CONSULTANT

ISSUANCE


MARK	DESCRIPTION	DATE
1	ISSUE FOR PERMIT	12-18-12
2	ISSUE FOR ADDENDUM 1	1-17-13
3		
4		
5		
6		
7		
8		

SCALE: AS NOTED
PLOT DATE: 12/14/2012
PBC PROJECT: EDISON PARK ELEMENTARY SCHOOL ANNEX
PBC CONTRACT NO.: C1547
PROJECT NO.: 06650

WARNING: ASBESTOS-CONTAINING BUILDING MATERIALS ARE OR MAY BE PRESENT IN THIS BUILDING. AN ASBESTOS MANAGEMENT PLAN IS AVAILABLE FOR REVIEW AT THE PROJECT OFFICE. THE PERSON MAY DISTURB ASBESTOS-CONTAINING MATERIALS UNLESS THAT PERSON IS A LICENSED ASBESTOS WORKER OR CONDUCTS SUCH WORK IN ACCORDANCE WITH SPECIFICATIONS CONTAINED IN THE PROJECT DOCUMENTS AND IN COMPLIANCE WITH ILLINOIS DEPARTMENT OF HEALTH RULES AND REGULATIONS.


TITLE:
SECOND FLOOR FRAMING PLAN

SHEET
S1.2

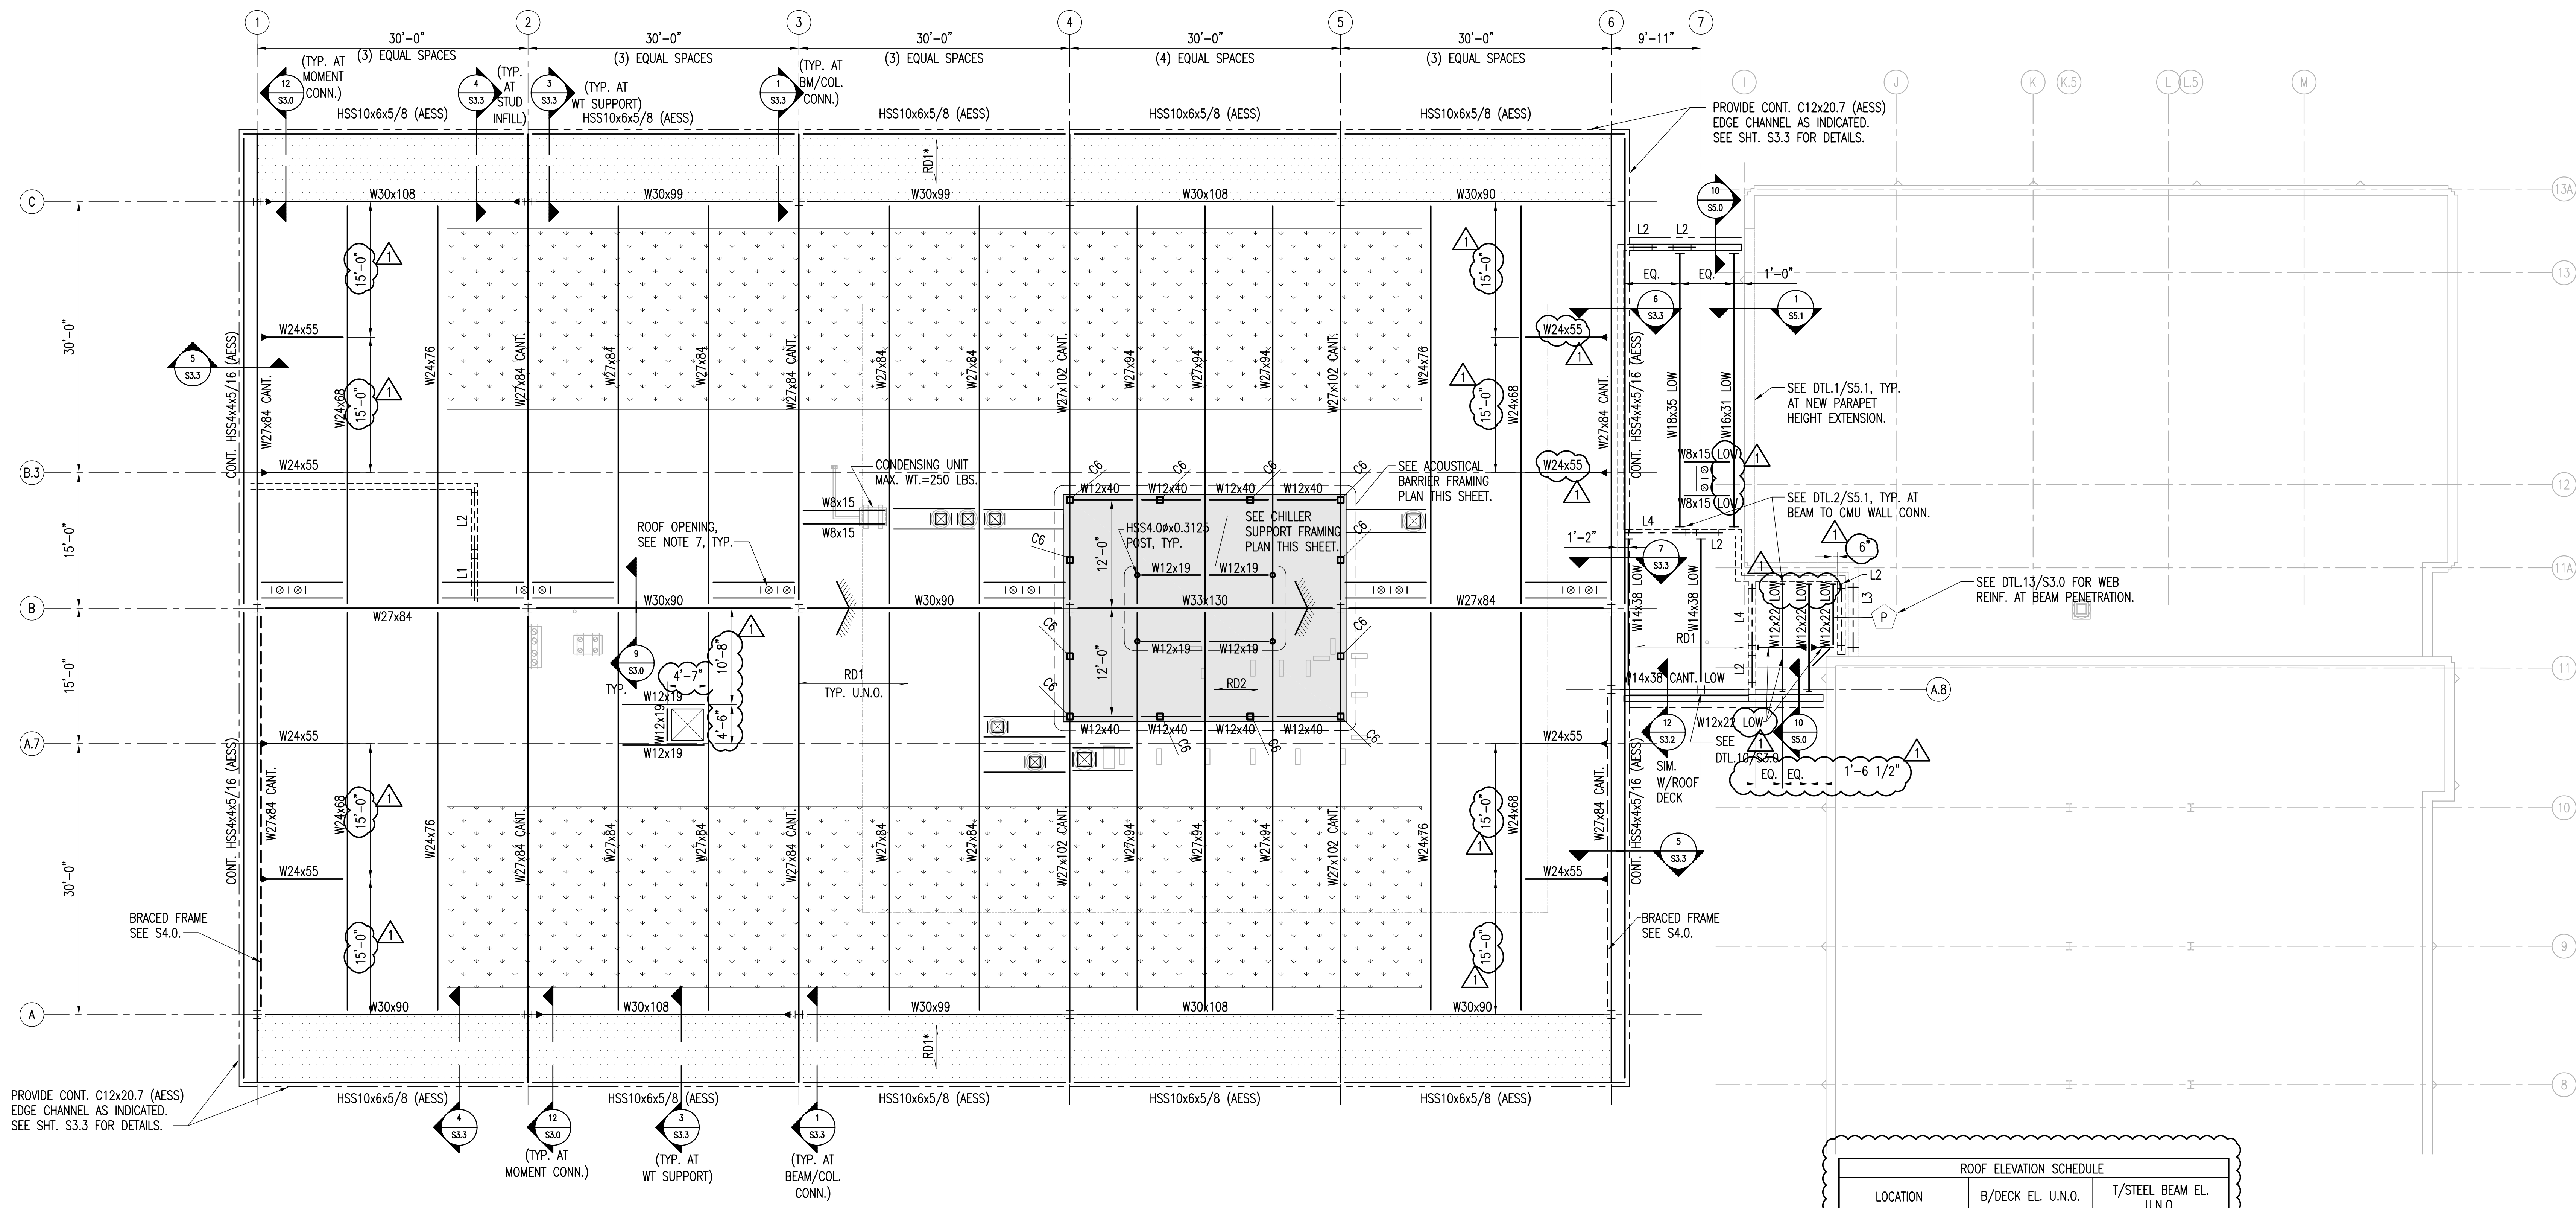


ROOF FRAMING PLAN
1/8"=1'-0"

- NOTES:
1. VERIFY ALL DIMENSIONS AND ELEVATIONS WITH ARCH. DWGS. PRIOR TO CONSTRUCTION. COORDINATE SIZE AND LOCATION OF ALL OPENINGS/PENETRATIONS WITH ARCHITECTURAL AND MECHANICAL DWGS. TYPICAL SLAB EDGES AT SLAB OPENINGS/PENETRATIONS SHALL BE 6" OFF THE CENTERLINES OF THE STEEL FRAMES, U.N.O.
 2. SEE S0.1 & S0.2 FOR GENERAL STRUCTURAL NOTES. FOR TYPICAL STEEL CONNECTIONS AND TYPICAL SLAB ON DECK CONSTRUCTION, SEE SHTS. S3.0 AND S3.1.
 3. RD1 INDICATES PERFORATED "EPIC TORIS A" ACOUSTIC ROOF DECK (18GA.) SEE ARCH. DRAWING FOR EXTENTS OF DECK. CONTINUOUSLY ATTACH TO ALL SUPPORTING MEMBERS W/ 3/4" PUDDLE WELDS AT 12" O.C. (8" O.C. AT PERIMETER) AND #10 TEK SCREW SIDELAP FASTENERS AT 24" O.C. MAX.
 4. RD1* INDICATES NON-PERFORATED "EPIC TORIS" ROOF DECK (18GA.); TYP. AT ROOF OVERHANGS. SEE ARCH. DRAWING FOR EXTENTS OF THIS TYPE OF DECK. CONTINUOUSLY ATTACH ROOF DECK TO ALL SUPPORTING MEMBERS W/ 3/4" PUDDLE WELDS AT 12" O.C. (8" O.C. AT PERIMETER) AND #10 TEK SCREW SIDELAP FASTENERS AT 24" O.C. MAX.
 5. RD2 INDICATES NON-PERFORATED "EPIC TORIS CA" ACOUSTIC COMPOSITE ROOF DECK (18GA.) W/4" LIGHT WEIGHT CONCRETE (6 1/2" TOTAL THICKNESS) W/6x6 W2.9x2.9 WWF. SEE DETAIL 1/S3.1 THRU 7/S3.1 FOR ADD'L REINF. INFO. SEE RD1 FOR DECK CONNECTION.
 6. "CX" INDICATES EXTENSIVE GREEN ROOF SYSTEM (30 psf MAX.). CONTRACTOR SHALL SUBMIT FOR APPROVAL PRIOR TO INSTALLATION. COORD. W/ARCH. DWG.
 7. SEE DETAILS 12/S3.1, 13/S3.1 AND 14/S3.1 FOR TYPICAL FRAMING AT OPENINGS. COORDINATE SIZE AND LOCATION OF ALL OPENINGS/PENETRATIONS WITH ARCHITECTURAL AND MECHANICAL DRAWINGS.
 8. SEE ARCH. AND MEP DRAWINGS FOR CURBS AND MECHANICAL EQUIPMENT PADS. SEE DETAIL 6/S2.0 AND 7/S2.0 FOR INFORMATION. FINAL LOCATIONS & SIZES SHALL BE COORDINATED W/MEP MANUFACTURER.
 9. IN CASES WHERE MECHANICAL/ELECTRICAL EQUIPMENT LOADING LISTED ON THE MANUFACTURER'S PRODUCT DATA EXCEEDS DESIGN LOADS INDICATED ON THE DESIGN DRAWINGS, CONTRACTOR SHALL NOTIFY STRUCTURAL ENGINEER AND ARCHITECT PRIOR TO PROCEEDING WITH THE WORK.
 10. DO NOT HANG LOADS FROM DECK. HANG ALL DUCTWORK, PIPING ETC DIRECTLY FROM STEEL FRAMING OF SUPPLEMENTARY MEMBERS. ALL HANGING LOADS SHALL BE SUBMITTED FOR REVIEW.
 11. "LX" INDICATES STEEL LINTEL BELOW. SEE SCHEDULE ON SHEET S5.0, AND ELEVATIONS ON SHEET S6.0.

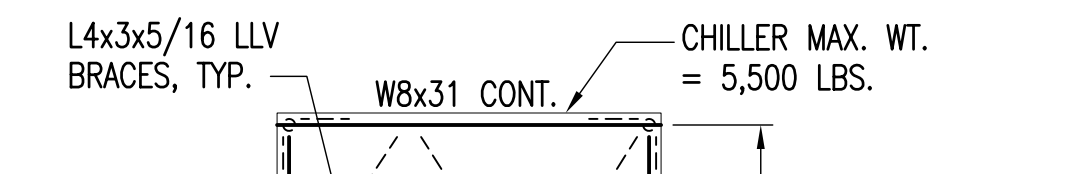

CHILLER SUPPORT FRAMING PLAN
1/8"=1'-0"


- NOTES:
1. VERIFY ALL DIMENSIONS AND ELEVATIONS WITH ARCH. DWGS. PRIOR TO CONSTRUCTION.
 2. SEE S0.1 & S0.2 FOR GENERAL STRUCTURAL NOTES.
 3. T/STEEL EL. PER ARCH. DWGS.
 4. ALL STEEL SHALL BE HOT DIPPED GALVANIZED.
 5. *X* INDICATES DIMENSION TO BE COORDINATED BY G.C. WITH MEP DWGS. AND CHILLER SUPPLIER PRIOR TO STEEL FABRICATION.

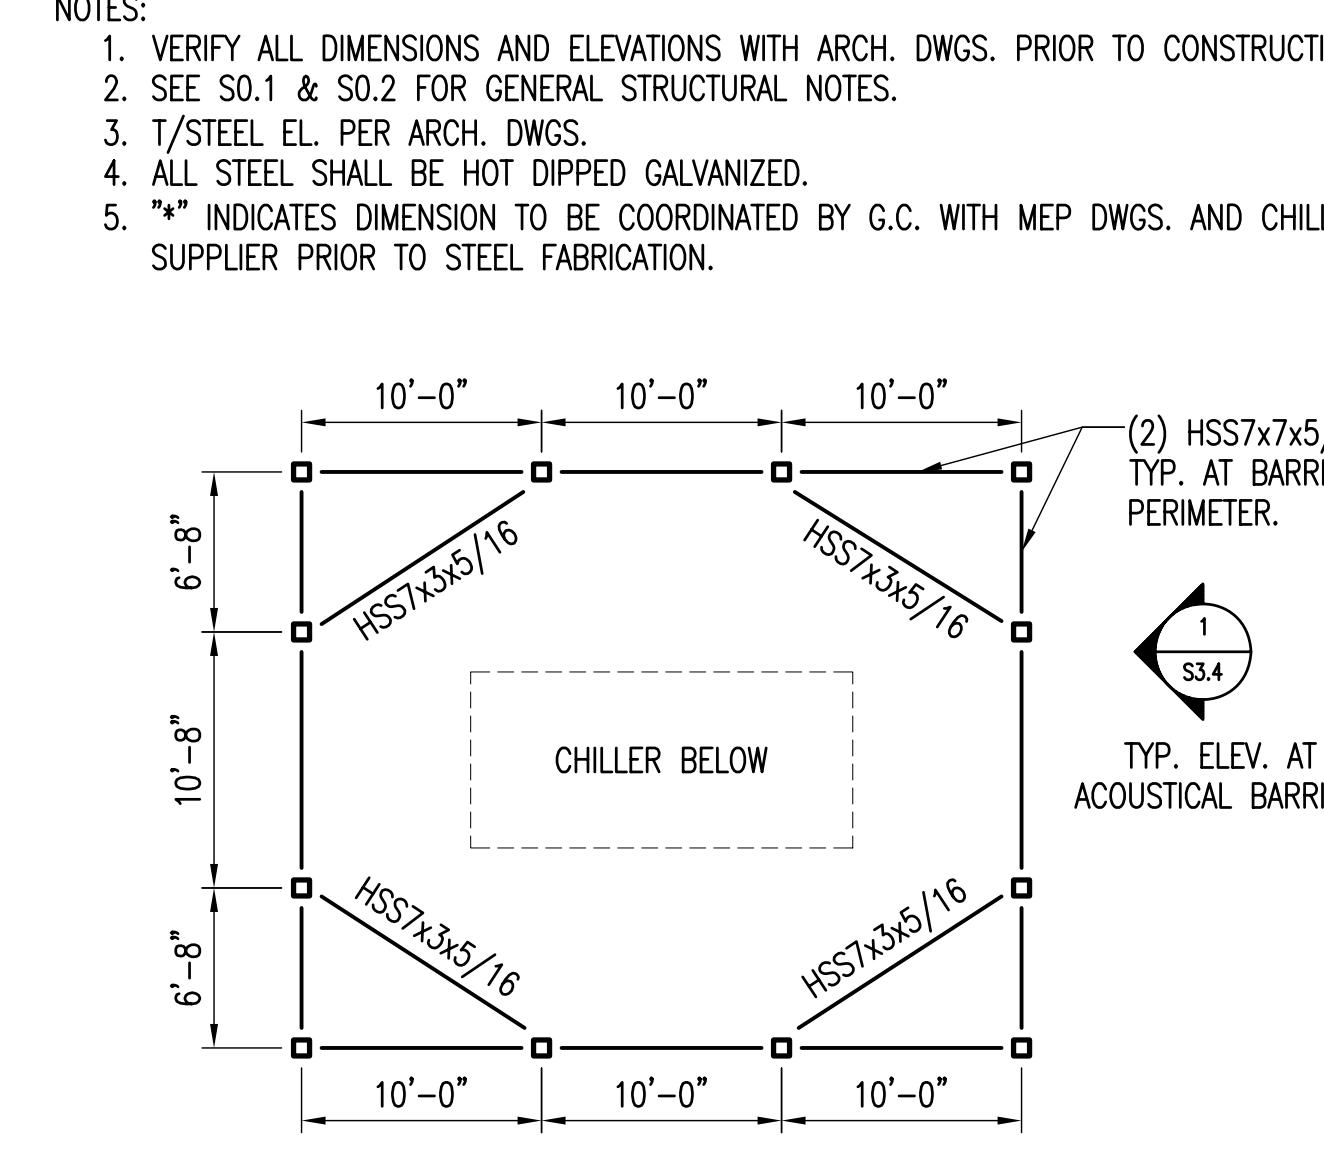

ACOUSTICAL BARRIER FRAMING PLAN
1/8"=1'-0"

- NOTES:
1. VERIFY ALL DIMENSIONS AND ELEVATIONS WITH ARCH. DWGS. PRIOR TO CONSTRUCTION.
 2. SEE S0.1 & S0.2 FOR GENERAL STRUCTURAL NOTES.
 3. T/STEEL EL. PER ARCH. DWGS.
 4. ALL STEEL SHALL BE HOT DIPPED GALVANIZED.

ROOF ELEVATION SCHEDULE		
LOCATION	B/DECK EL. U.N.O.	T/STEEL BEAM EL. U.N.O.
COLUMN LINE (A)	+35'-5 1/2"	+35'-4 1/2"
COLUMN LINE (B)	+29'-10"	+29'-10"
COLUMN LINE (C)	+35'-5 1/2"	+35'-4 1/2"
LOW ROOF AT EAST OF COLUMN LINE (6)	+27'-11"	+27'-11"

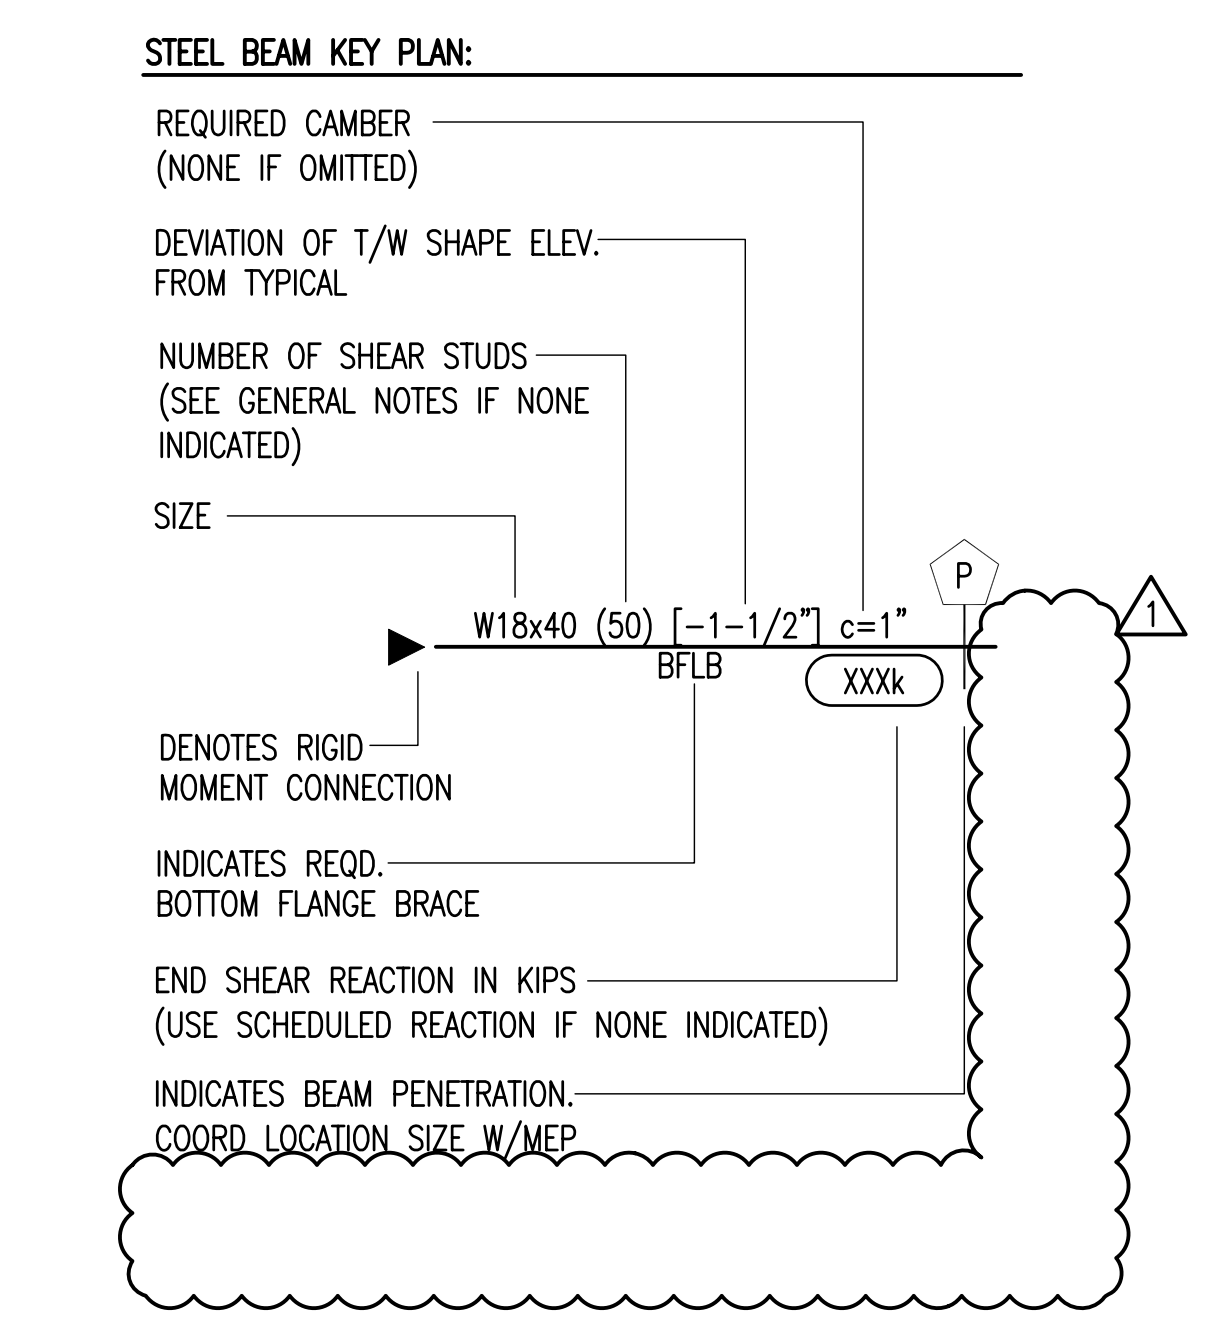

EDISON PARK ELEMENTARY SCHOOL ANNEX
6220 N. OLCOTT AVE
CHICAGO, IL 60631
CHICAGO PUBLIC SCHOOLS
CITY OF CHICAGO, MAYOR RAHM EMANUEL

THESE DRAWINGS HAVE BEEN PREPARED AT AND / OR UNDER MY SUPERVISION AND TO THE BEST OF MY KNOWLEDGE AND BELIEF CONFORM AND COMPLY WITH THE REQUIREMENTS OF THE CHICAGO DEPARTMENT OF BUILDING.

ILLINOIS
KATHLEEN O'DONNELL
REGISTERED ARCHITECT
001416851
EXPIRATION DATE: NOVEMBER 30, 2014

TRIPARTITE, INC
Architecture Restoration Design
4720 N. Virginia Ave.
Chicago, Illinois 60625
P: 773-681-0894
www.tripartiteinc.com

MATRIX ENGINEERING CORPORATION
28 W. JACKSON BLDG. 4TH FLOOR CHICAGO, IL 60604
STRUCTURAL ENGINEERING

SITE DESIGN GROUP, LTD.
881 S. MICHIGAN AVE. SUITE 1000 CHICAGO, IL 60605
LANDSCAPE DESIGN

TERRA ENGINEERING, LTD.
251 N. WABASH AVE. CHICAGO, IL 60601
MECHANICAL, PLUMBING, FIRE PROTECTION
CIVIL ENGINEERING

CALOR DESIGN GROUP, LTD.
251 N. WABASH AVE. CHICAGO, IL 60601
QUALITY CONTROL, LOW VOLTAGE SECURITY, FIRE ALARM

TECHNOW ENGINEERING, LLC
30 E. ADAMS ST. SUITE 1100 CHICAGO, IL 60603
LEED CONSULTANT

HJ KESSLER ASSOCIATES
360 N. LAKE STREET, SUITE 801 CHICAGO, IL 60613
LEED CONSULTANT

EDGE ASSOCIATES, INC
220 E. LAKE STREET, SUITE 303 ADDISON, IL 60101
FOOD SERVICES

DOOR SECURITY SOLUTIONS
718 FOSTER AVE. BENSenville, IL 60156
HANDYMAN CONSULTANT

PN DROP ACOUSTICS
251 W. LAKE STREET, 4TH FLOOR CHICAGO, IL 60606
ACOUSTIC CONSULTANT


MARK	DESCRIPTION	DATE
1	ISSUE FOR PERMIT	12-18-12
2	ISSUE FOR ADDENDUM 1	1-17-13
3		
4		
5		
6		
7		
8		

SCALE: AS NOTED
PLOT DATE: 12/14/2012
PBC PROJECT: EDISON PARK ELEMENTARY SCHOOL ANNEX
PBC CONTRACT NO.: C1547
PROJECT NO.: 06650

WARNING:
ASBESTOS-CONTAINING BUILDING MATERIALS ARE OR MAY BE PRESENT IN THIS BUILDING. AN ASBESTOS MANAGEMENT PLAN IS AVAILABLE IN THE ARCHITECT'S OFFICE. FOR INFORMATION, PERSONS MAY DISTURB ASBESTOS-CONTAINING MATERIALS UNLESS THAT PERSON IS A LICENSED ASBESTOS WORKER OR CONDUCTS SUCH WORK IN ACCORDANCE WITH SPECIFICATIONS CONTAINED IN THE PROJECT DOCUMENTS AND IN COMPLIANCE WITH ILLINOIS DEPARTMENT OF HEALTH RULES AND REGULATIONS.


TITLE:
ROOF FRAMING PLAN

SHEET
S1.3

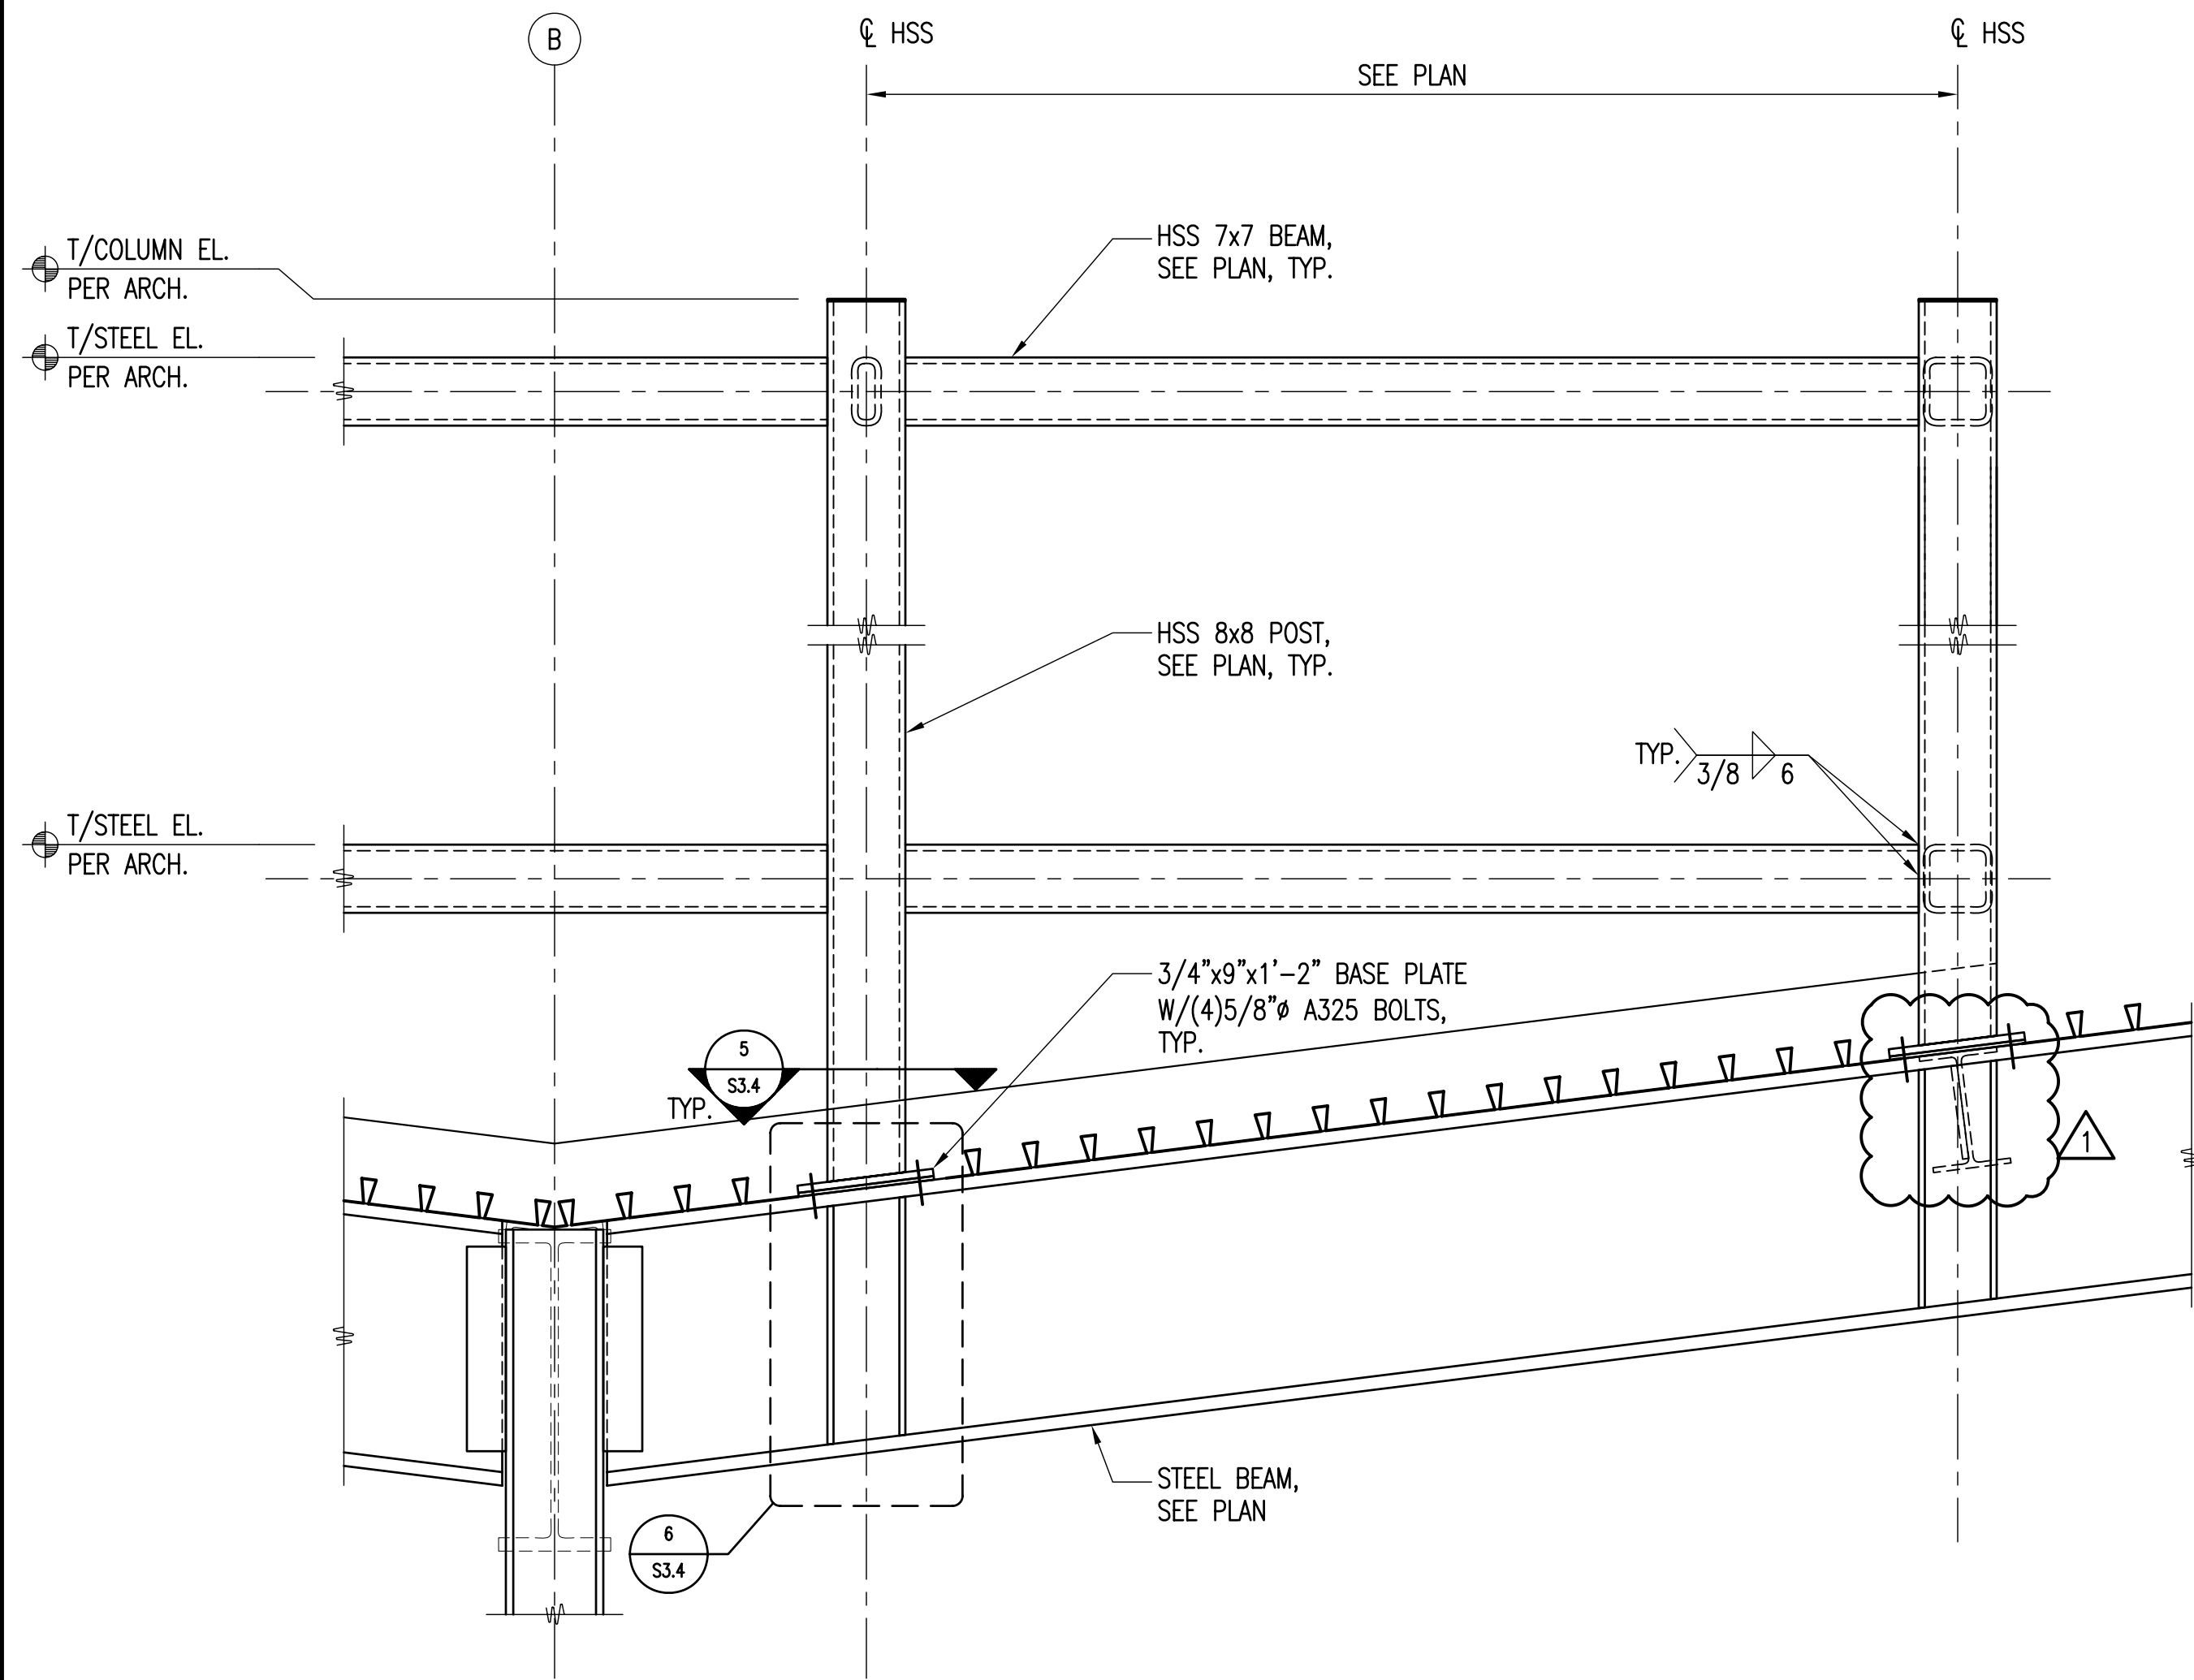


NOTES:
 1. ALL ROOF SCREEN SUPPORT STEEL TO BE HOT DIPPED GALVANIZED.
 2. ALL HSS TUBES AT ACOUSTICAL BARRIER SUPPORT FRAMING SHALL HAVE A 1/4" CAP PLATE AT ENDS.

1 TYP. ELEVATION AT ACOUSTICAL BARRIER SUPPORT FRAMING
 S3.4 NOT TO SCALE

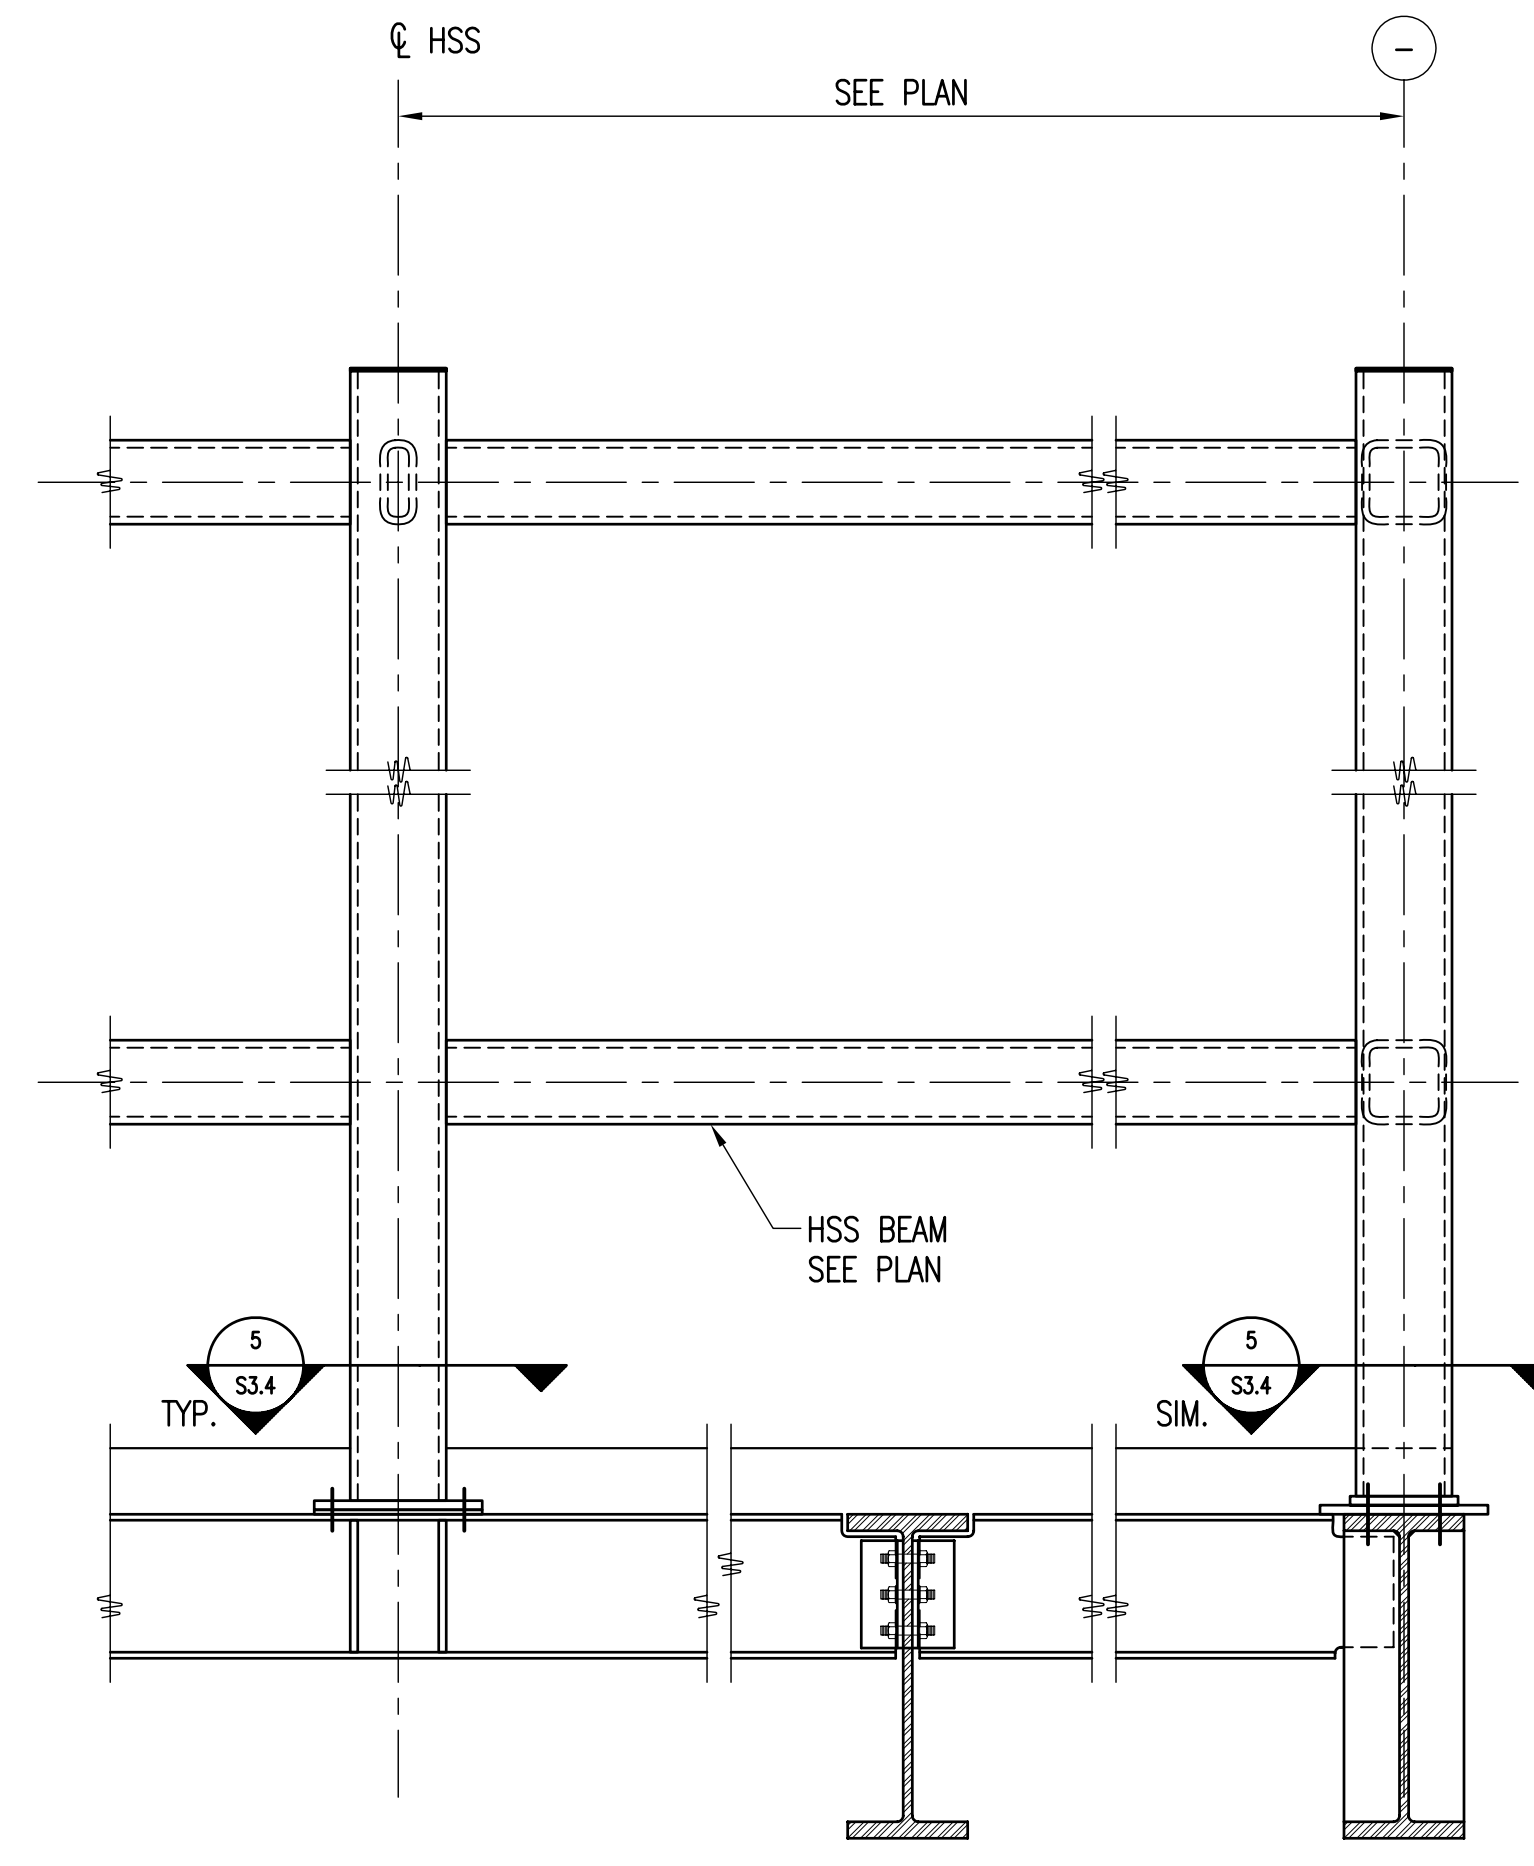


SEE DETAIL 1/S3.4 FOR INFO. NOT SHOWN

2 ELEVATION AT ACOUSTICAL BARRIER SUPPORT FRAMING
 S3.4 NOT TO SCALE

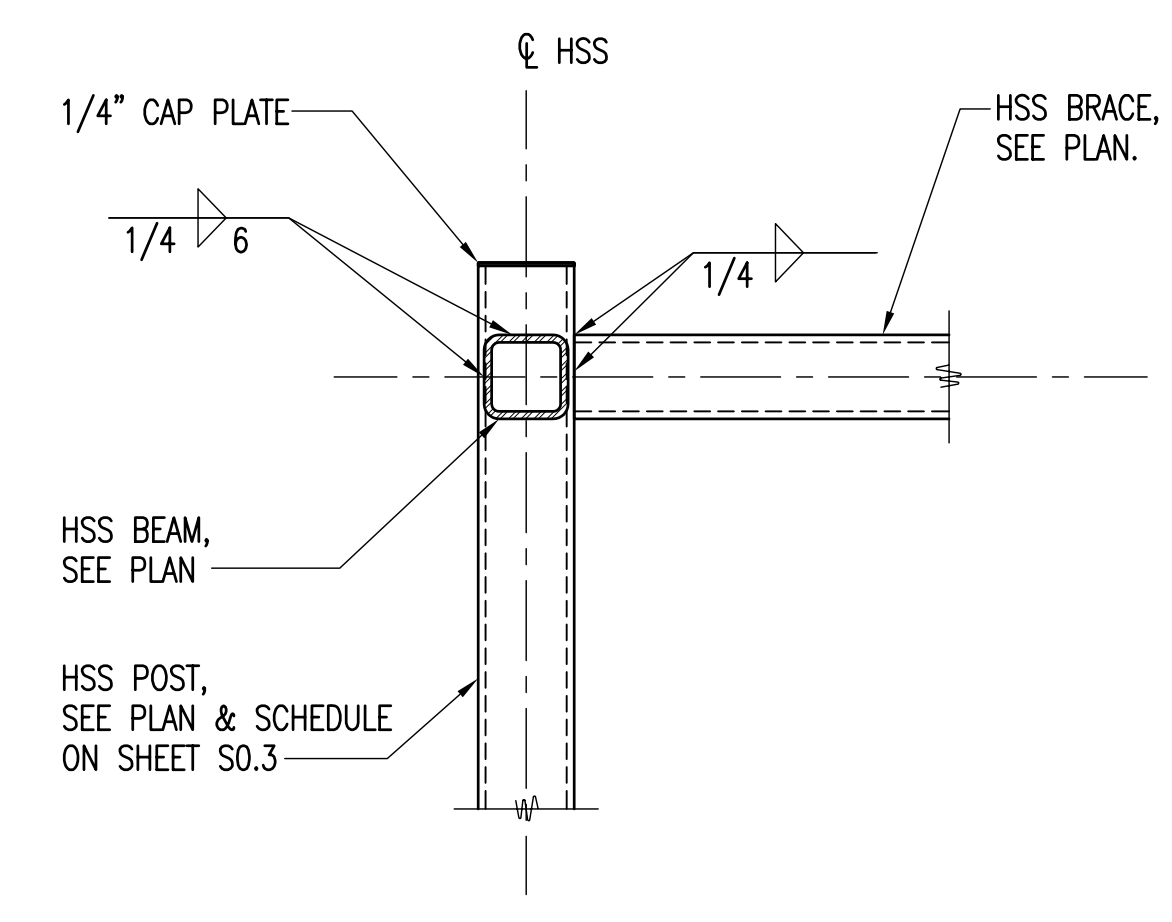


3 SECTION AT BEAM-TO-COL. & BRACE-TO-COL. CONN.
 S3.4 3/4"=1'-0"


4 NOT USED
 S3.4 3/4"=1'-0"

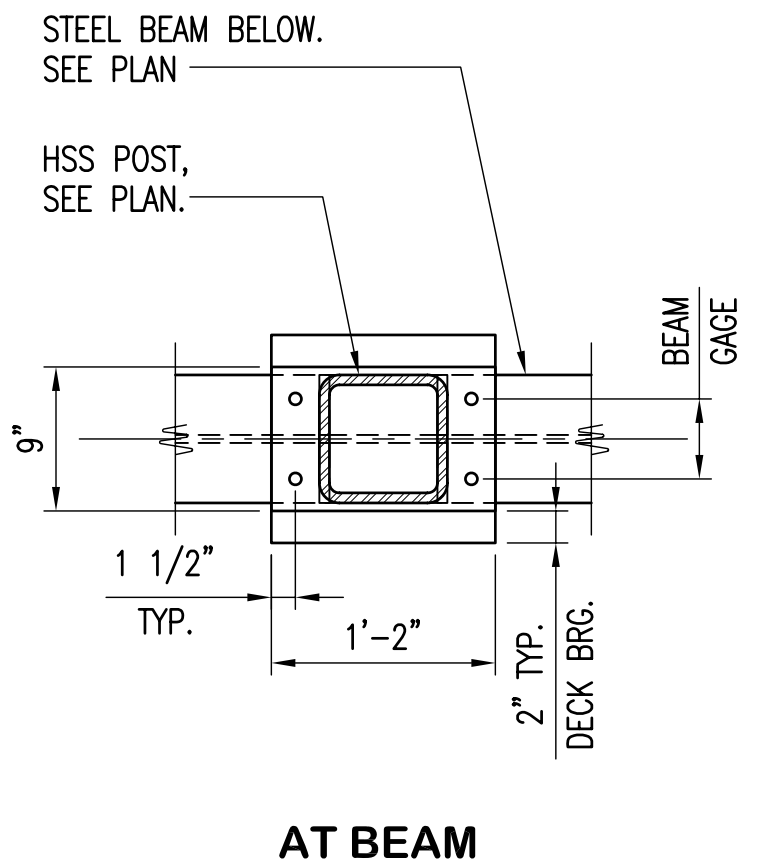

5 TYPICAL HSS POST BASE PLATE PLAN DETAIL
 S3.4 1"=1'-0"

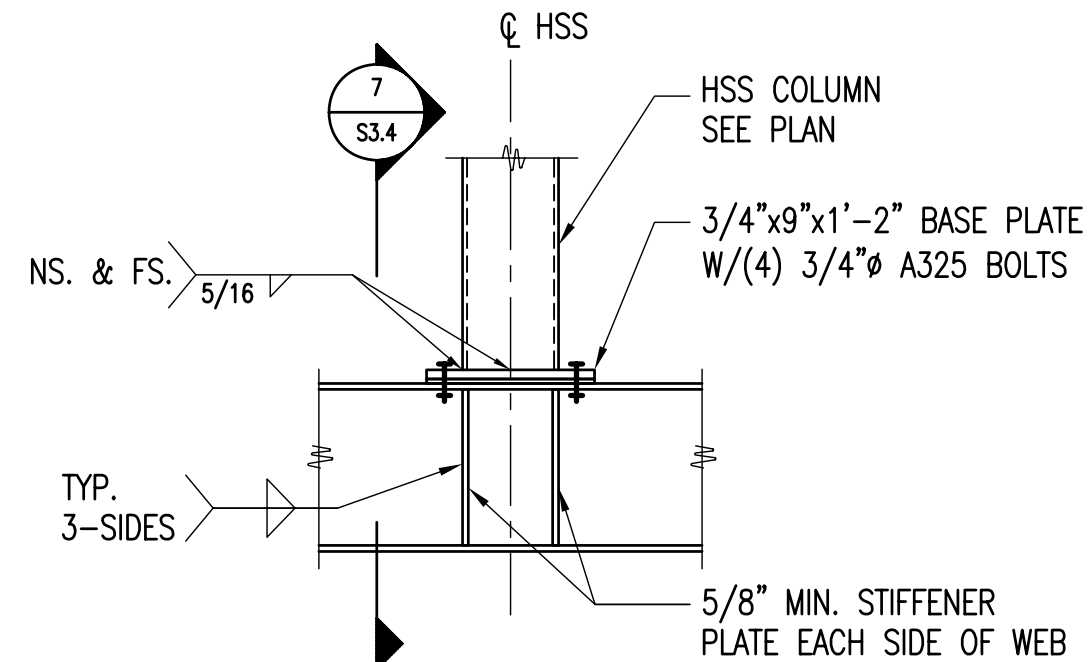


6 TYP. COLUMN TO BEAM CONN.
 S3.4 3/4"=1'-0"

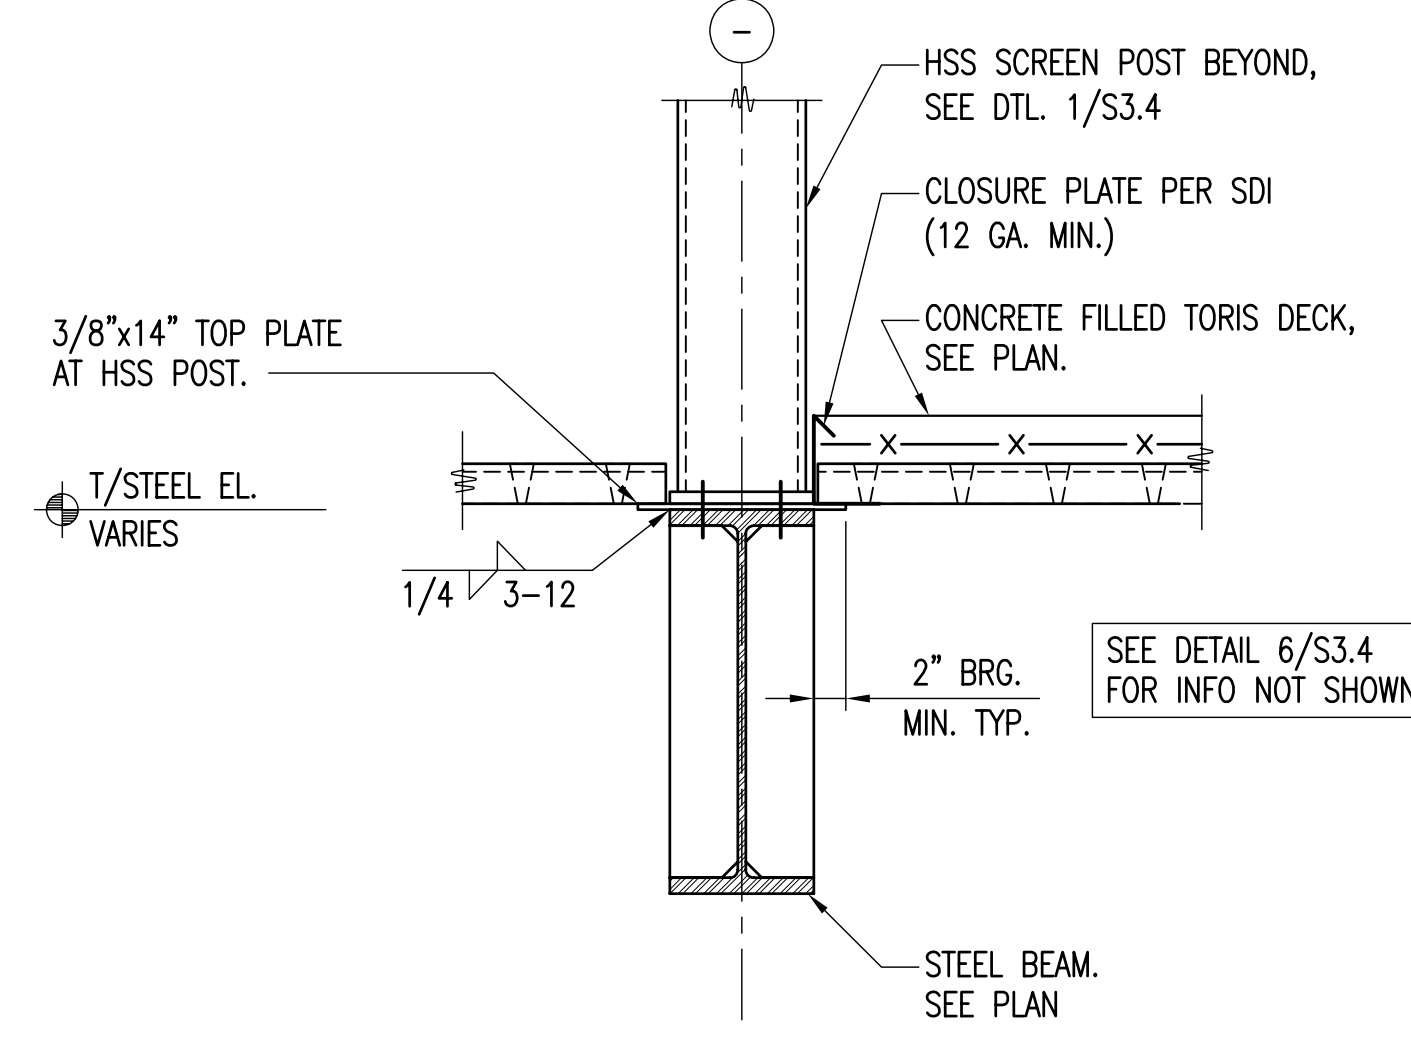

7 SEC AT HSS COLUMN TO BEAM CONN.
 S3.4 1"=1'-0"

8 NOT USED
 S3.4 3/4"=1'-0"

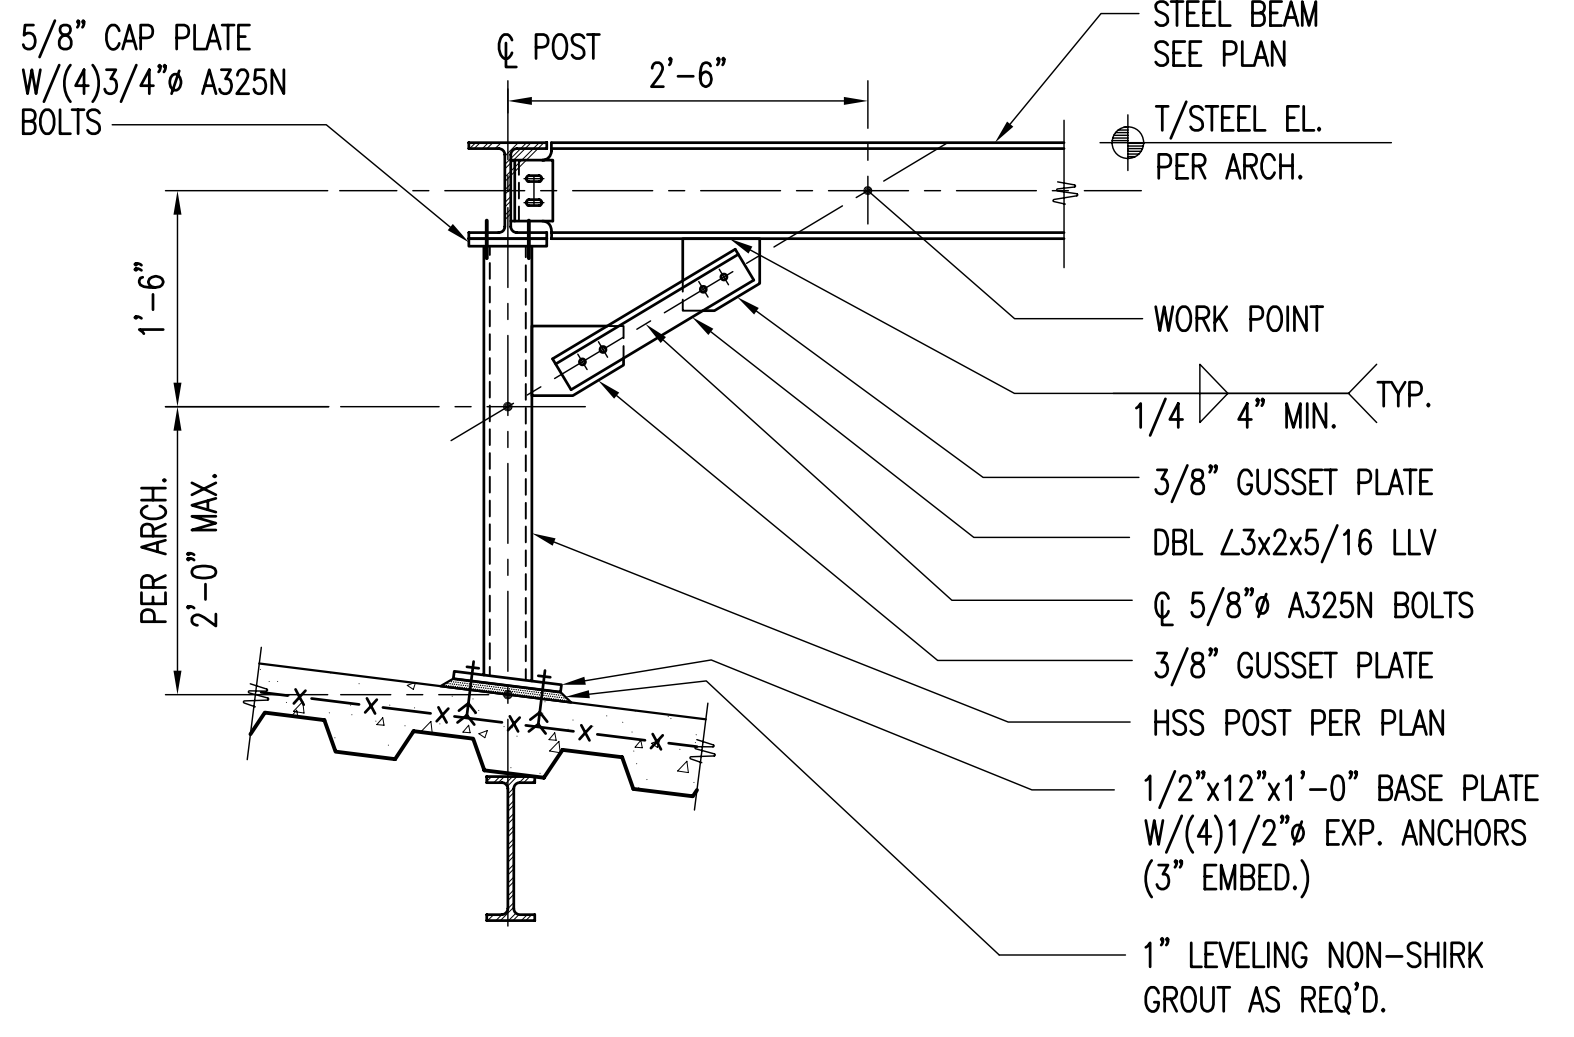

9 TYPICAL SECTION AT CHILLER FRAME SUPPORT
 S3.4 3/4"=1'-0"



EDISON PARK ELEMENTARY SCHOOL ANNEX
 6220 N. OLCOTT AVE
 CHICAGO, IL 60631
 CHICAGO PUBLIC SCHOOLS
 CITY OF CHICAGO, MAYOR RAHM EMANUEL

THESE DRAWINGS HAVE BEEN PREPARED AT AND / OR UNDER MY SUPERVISION AND TO THE BEST OF MY KNOWLEDGE AND BELIEF CONFORM AND COMPLY WITH THE REQUIREMENTS OF THE CHICAGO DEPARTMENT OF BUILDINGS.

ILLINOIS
 KATHLEEN O'DONNELL
 REGISTERED ARCHITECT
 001-016351
 EXPIRATION DATE: NOVEMBER 30, 2014

TRIPARTITE, INC
 Architecture Restoration Design
 4720 N. Virginia Ave.
 Chicago, Illinois 60625
 P: 773-681-0894
 www.tripartiteinc.com

MATRIX ENGINEERING CORPORATION
 23 W. JACKSON BLDG. 15TH FLOOR / CHICAGO, IL 60604
 STRUCTURAL ENGINEERING

SITE DESIGN GROUP, LTD.
 888 S. MICHIGAN AVE., SUITE 1000 / CHICAGO, IL 60605
 LANDSCAPE DESIGN

TERRA ENGINEERING, LTD.
 225 W. GRAND STREET, 4TH FLOOR / CHICAGO, IL 60654
 CIVIL ENGINEERING

CALOR DESIGN GROUP, LTD.
 221 N. WEBSTER AVE., CHICAGO, IL 60617
 MECHANICAL, PLUMBING, FIRE PROTECTION

TECHKNOW ENGINEERING, LLC
 30 E. ADAMS ST., SUITE 1100 / CHICAGO, IL 60603
 QUALITY CONTROL, LOW VOLTAGE SECURITY, FIRE ALARM

H. KESSLER ASSOCIATES
 3615 N. LAKE SHORE DRIVE, SUITE 811 / CHICAGO, IL 60613
 LEED CONSULTING

EDGE ASSOCIATES, INC
 220 E. LAKE STREET, SUITE 303 / ADDISON, IL 60101
 FOOD SERVICE

DOOR SECURITY SOLUTIONS
 718 FOSTER AVE. / BENSenville, IL 60106
 HARDWARE CONSULTANT

PN DROP ACOUSTICS
 251 W. LAKE STREET, 4TH FLOOR / CHICAGO, IL 60606
 ACOUSTIC CONSULTANT


MARK	DESCRIPTION	DATE
1	ISSUE FOR PERMIT	12-18-12
2	ISSUE FOR ADDENDUM 1	1-17-13
3		
4		
5		
6		
7		
8		

SCALE: AS NOTED
 PLOT DATE: 12/14/2012
 PBC PROJECT: EDISON PARK ELEMENTARY SCHOOL ANNEX
 PBC CONTRACT NO.: C1547
 PROJECT NO.: 05650

WARNING:
 ASBESTOS-CONTAINING BUILDING MATERIALS ARE OR MAY BE PRESENT IN THIS BUILDING. AN ASBESTOS MANAGEMENT PLAN IS AVAILABLE IN THE SCHOOL. ANY PERSON WHO REQUESTS THIS PERSON MAY DISTURB ASBESTOS-CONTAINING MATERIALS UNLESS THAT PERSON IS A LICENSED ASBESTOS WORKER OR CONDUCTS SUCH WORK IN ACCORDANCE WITH SPECIFICATIONS CONTAINED IN THE PROJECT DOCUMENTS AND IN COMPLIANCE WITH ILLINOIS DEPARTMENT OF HEALTH RULES AND REGULATIONS.


TITLE:
 FRAMING SECTIONS AND DETAILS

SHEET
S3.4

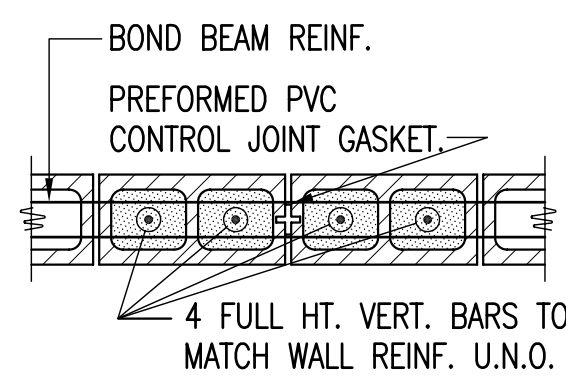


NOTE: DO NOT INTERRUPT BOND BEAM REINF. AT ROOF LEVELS.

1 TYPICAL CMU CONTROL JOINT
S5.0 N.T.S.

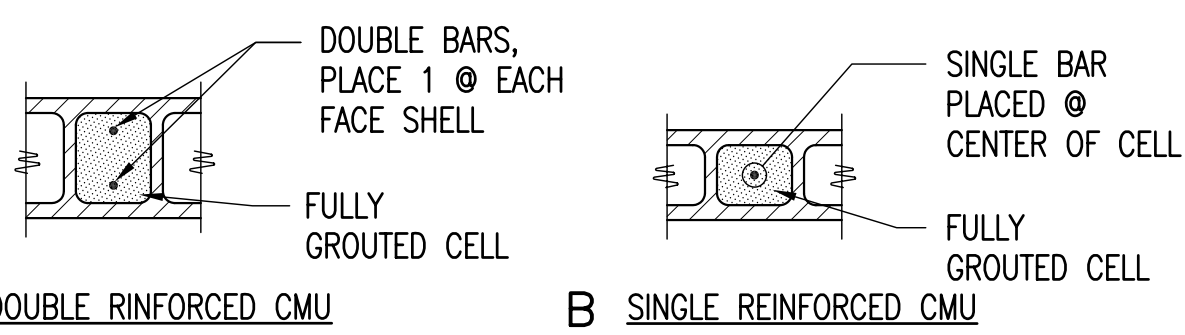


NOTE: SEE PLANS AND ELEVATIONS FOR BAR LOCATIONS AND SPACING.


2 TYPICAL MASONRY REINFORCEMENT
S5.0 N.T.S.

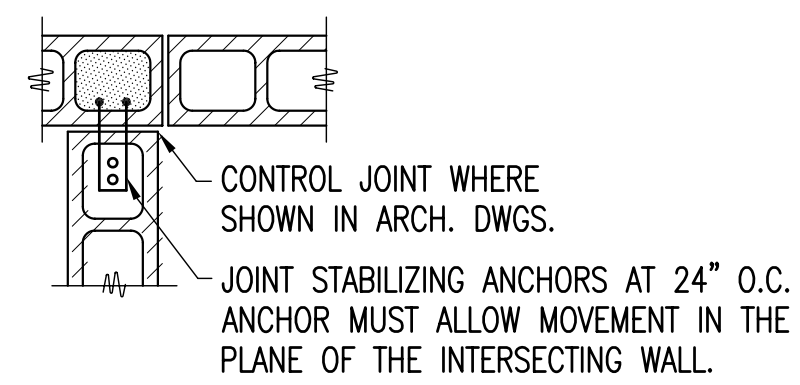


3 TYPICAL CONTROL JOINT AT INTERSECTING INTERIOR WALLS
S5.0 N.T.S.

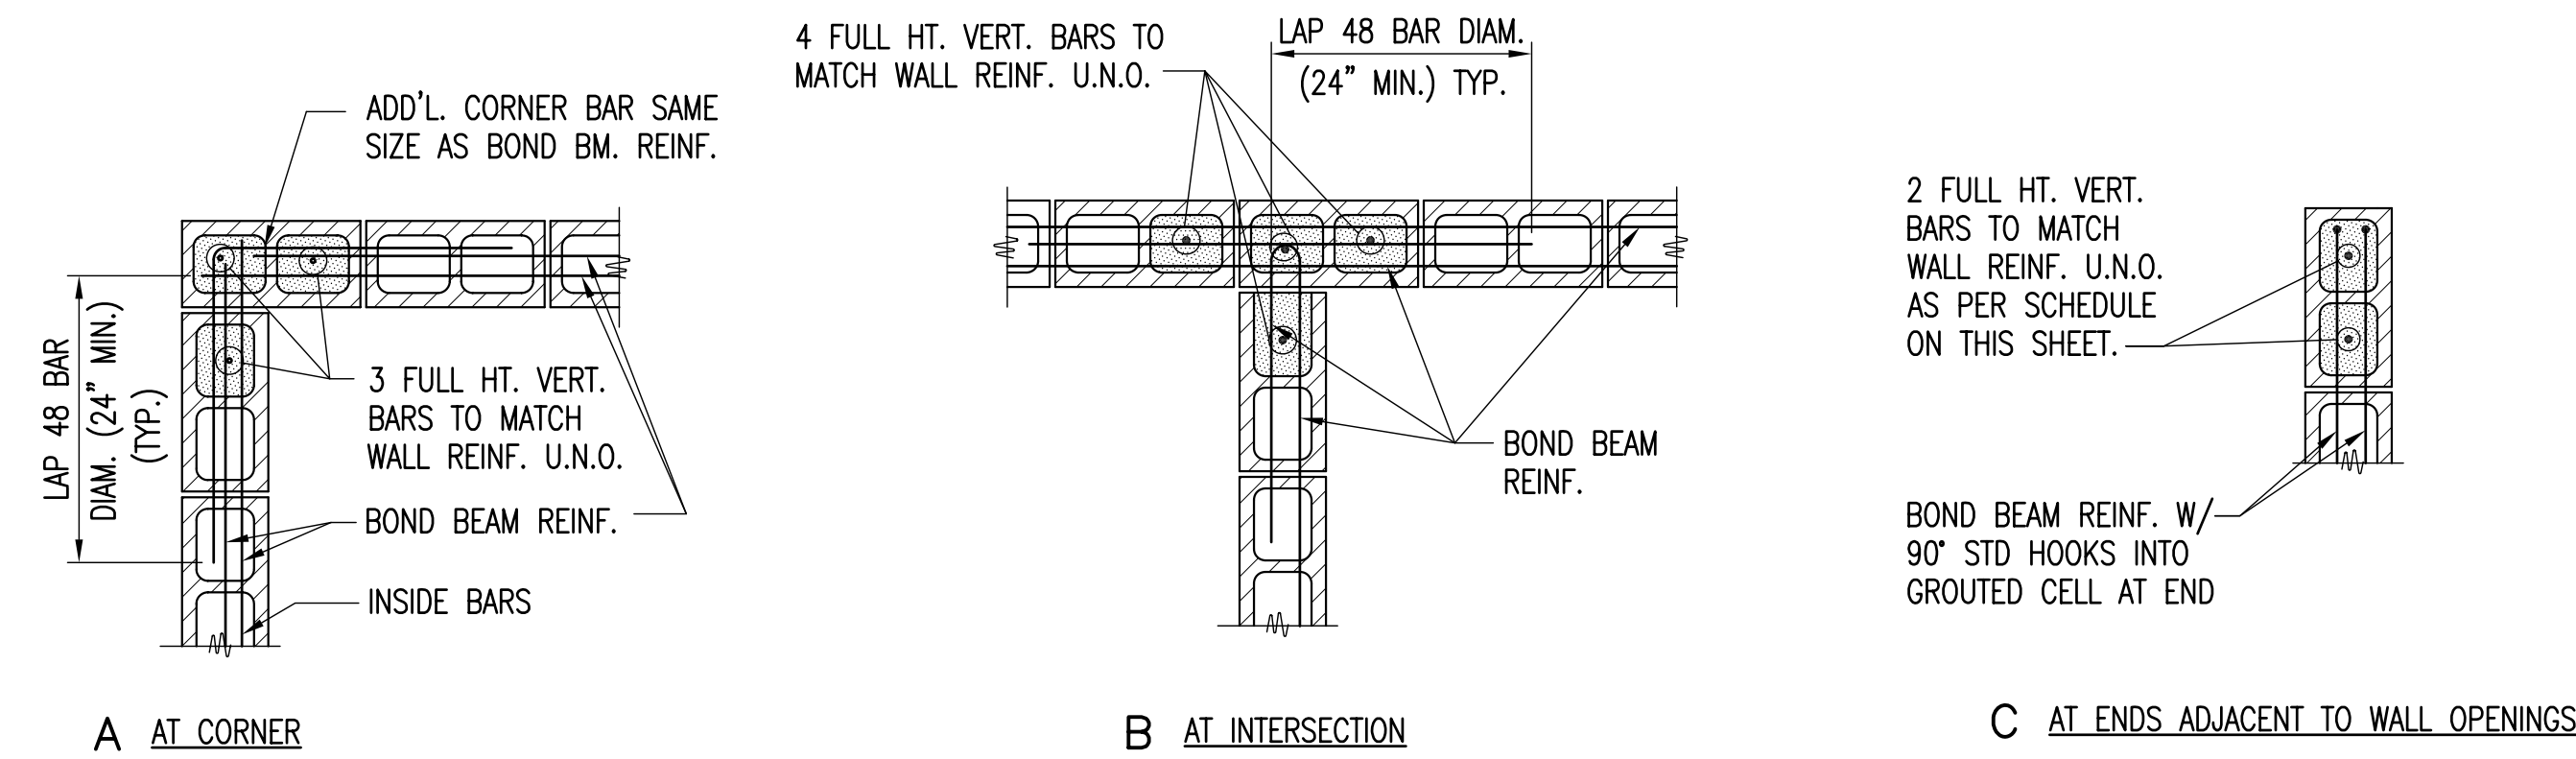


4 TYPICAL MASONRY WALL BOND BEAM AND ADD'L VERT. BAR DETAILS
S5.0 N.T.S.

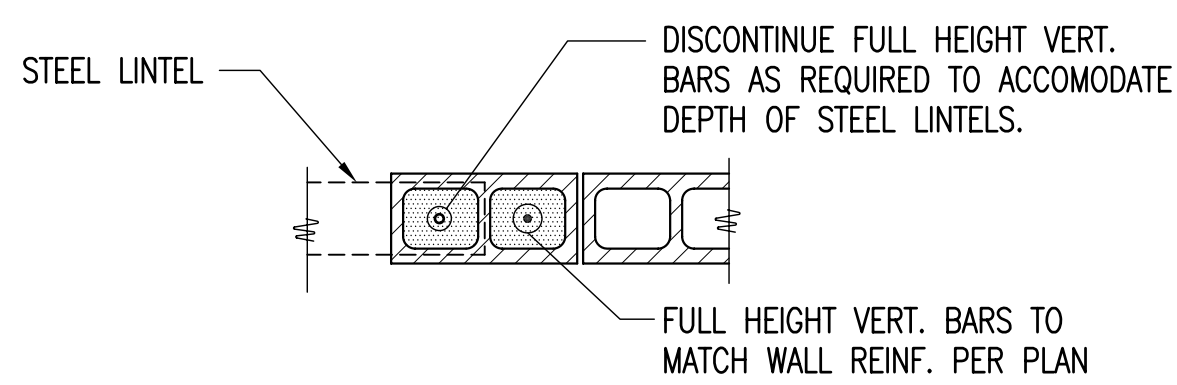


5 TYPICAL VERTICAL REINFORCEMENT AT WINDOWS AND DOORS
S5.0 3/4"=1'-0"

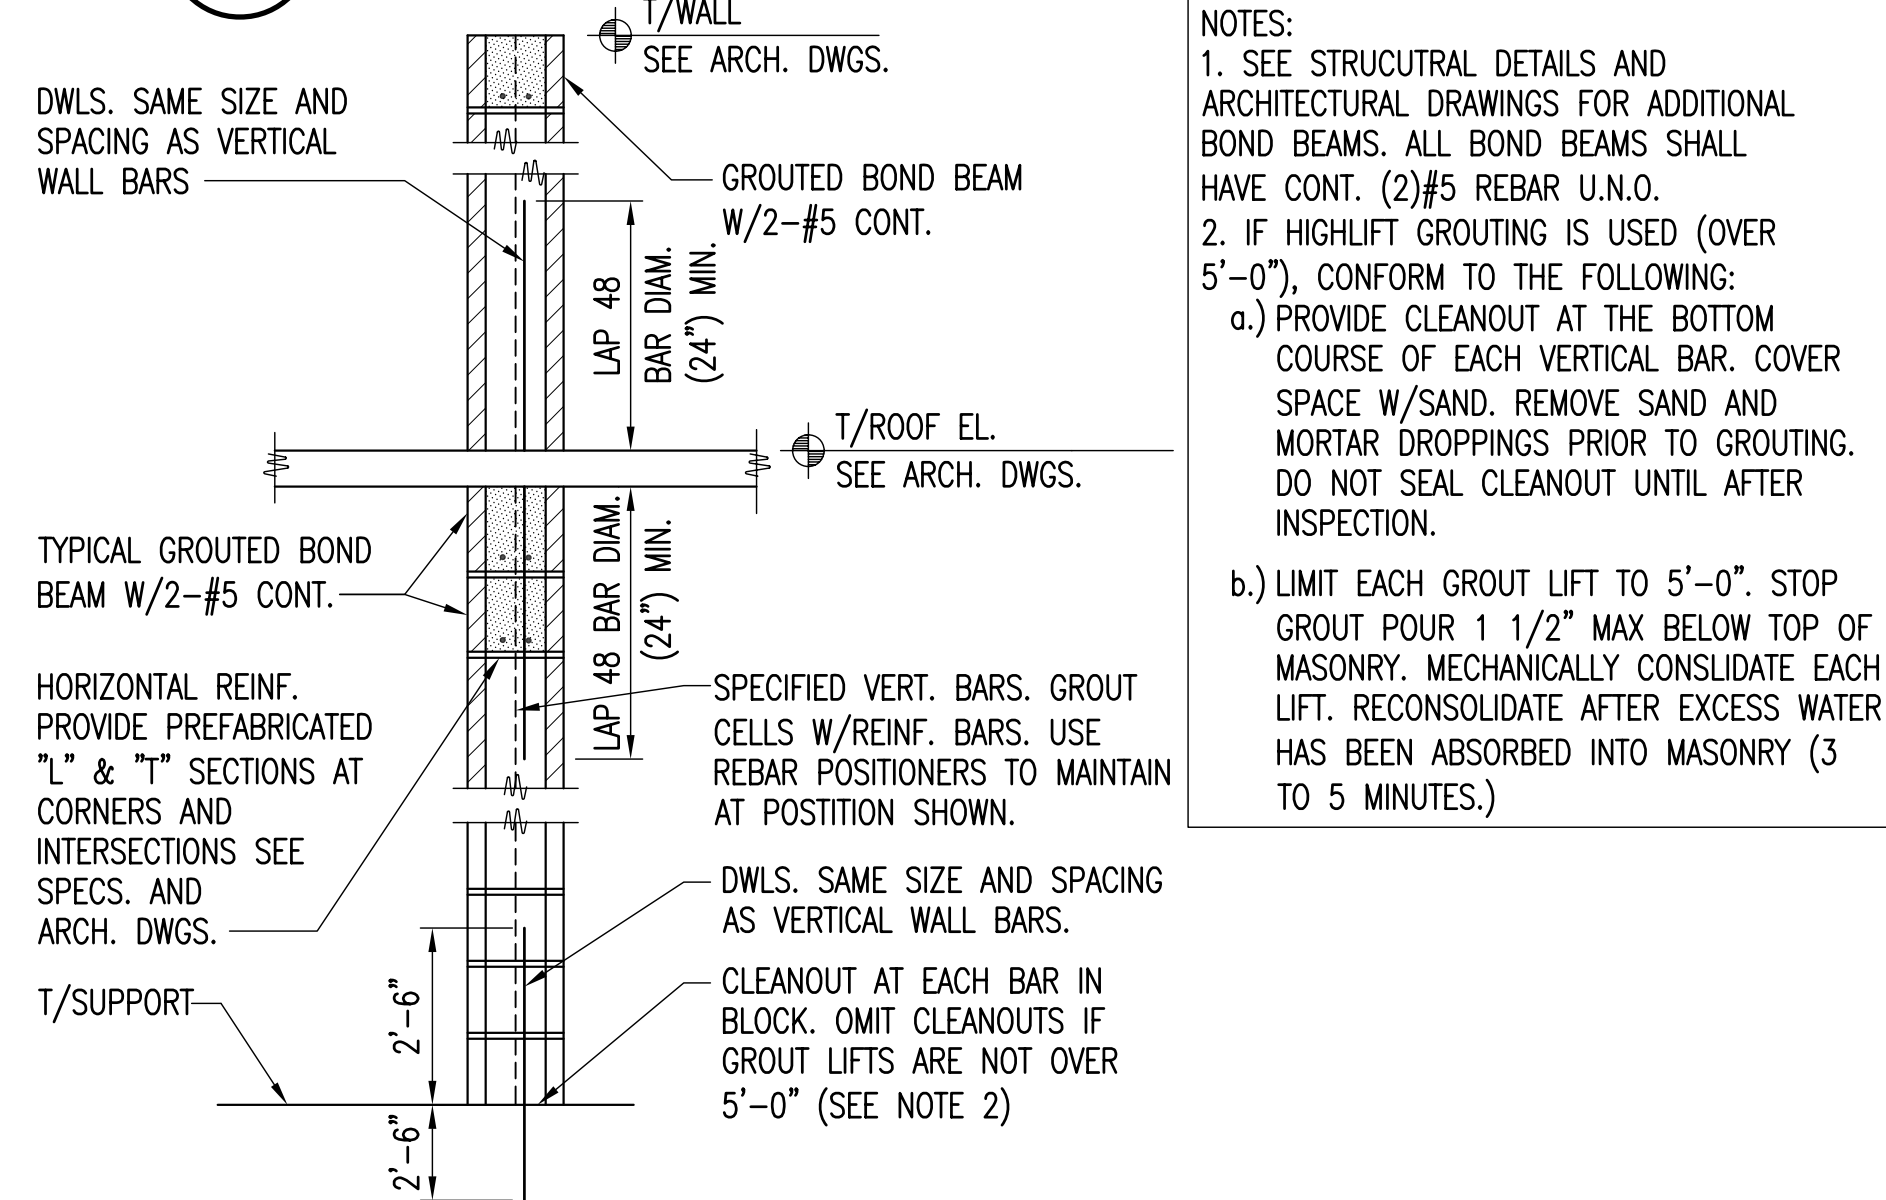


6 TYPICAL REINF. CONCRETE MASONRY WALL SECTION
S5.0 N.T.S.

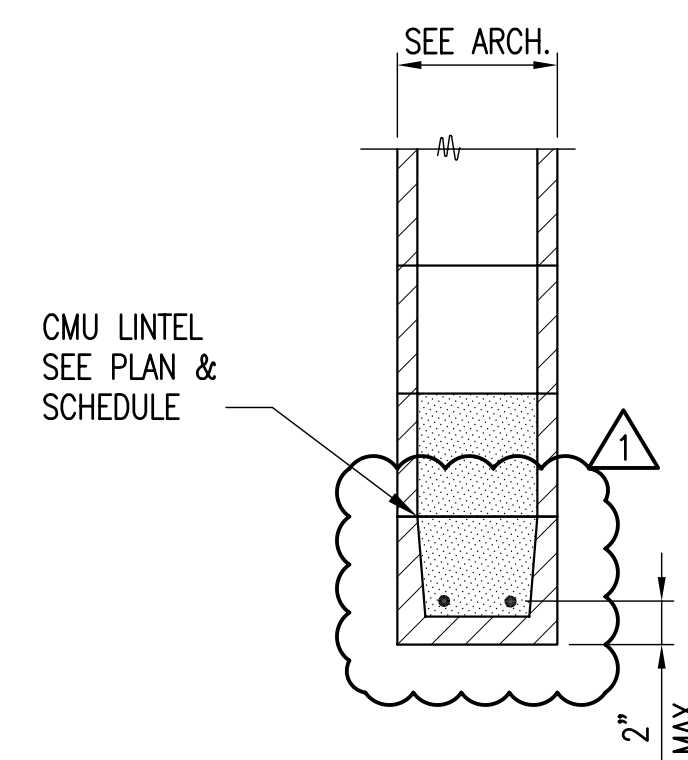


7 TYPICAL SECTION AT BOND BEAM LINTEL
S5.0 1"=1'-0"

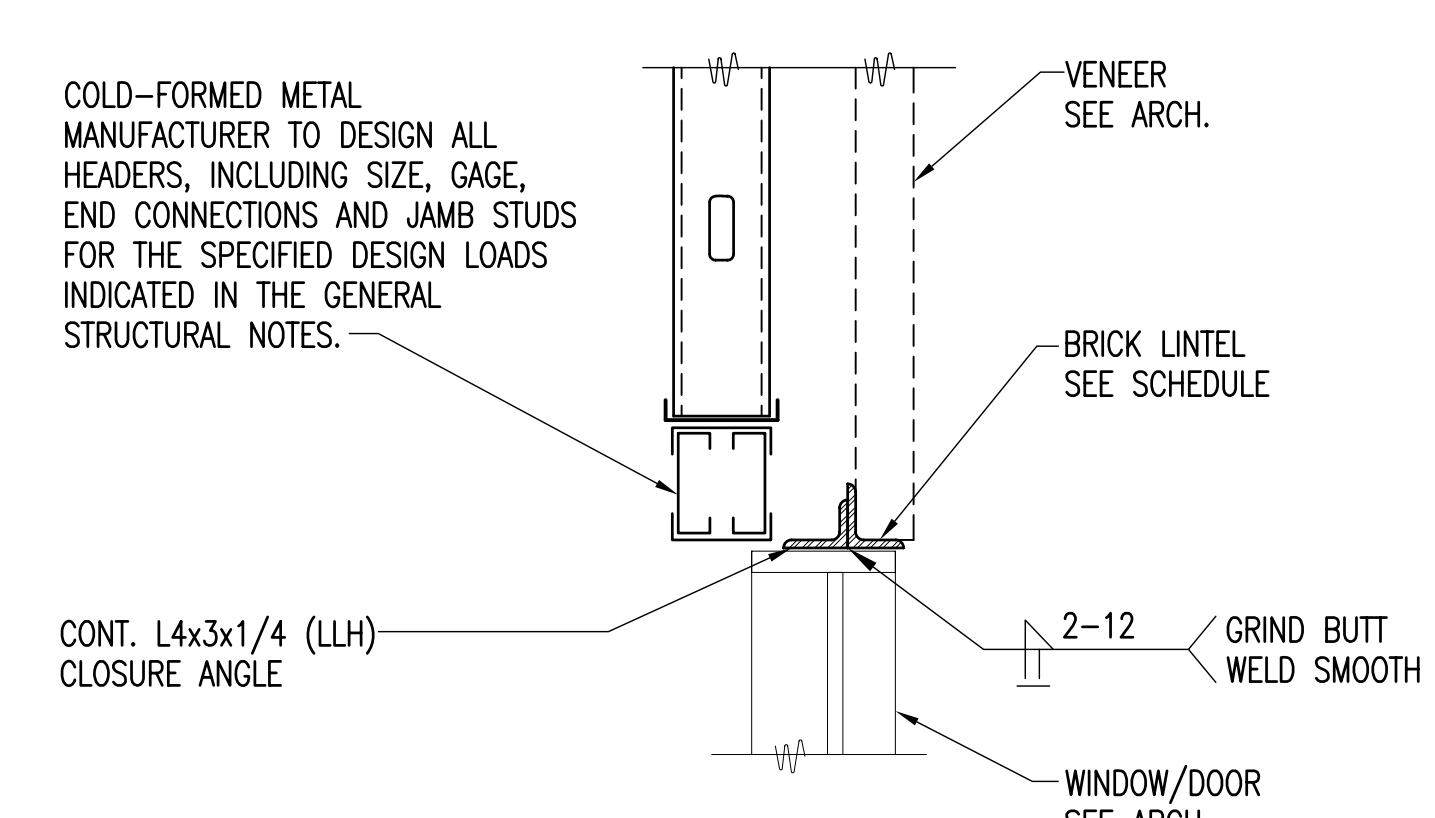


8 TYPICAL SECTION AT LOOSE ANGLE LINTEL AT LIGHT GAGE HEADER
S5.0 N.T.S.

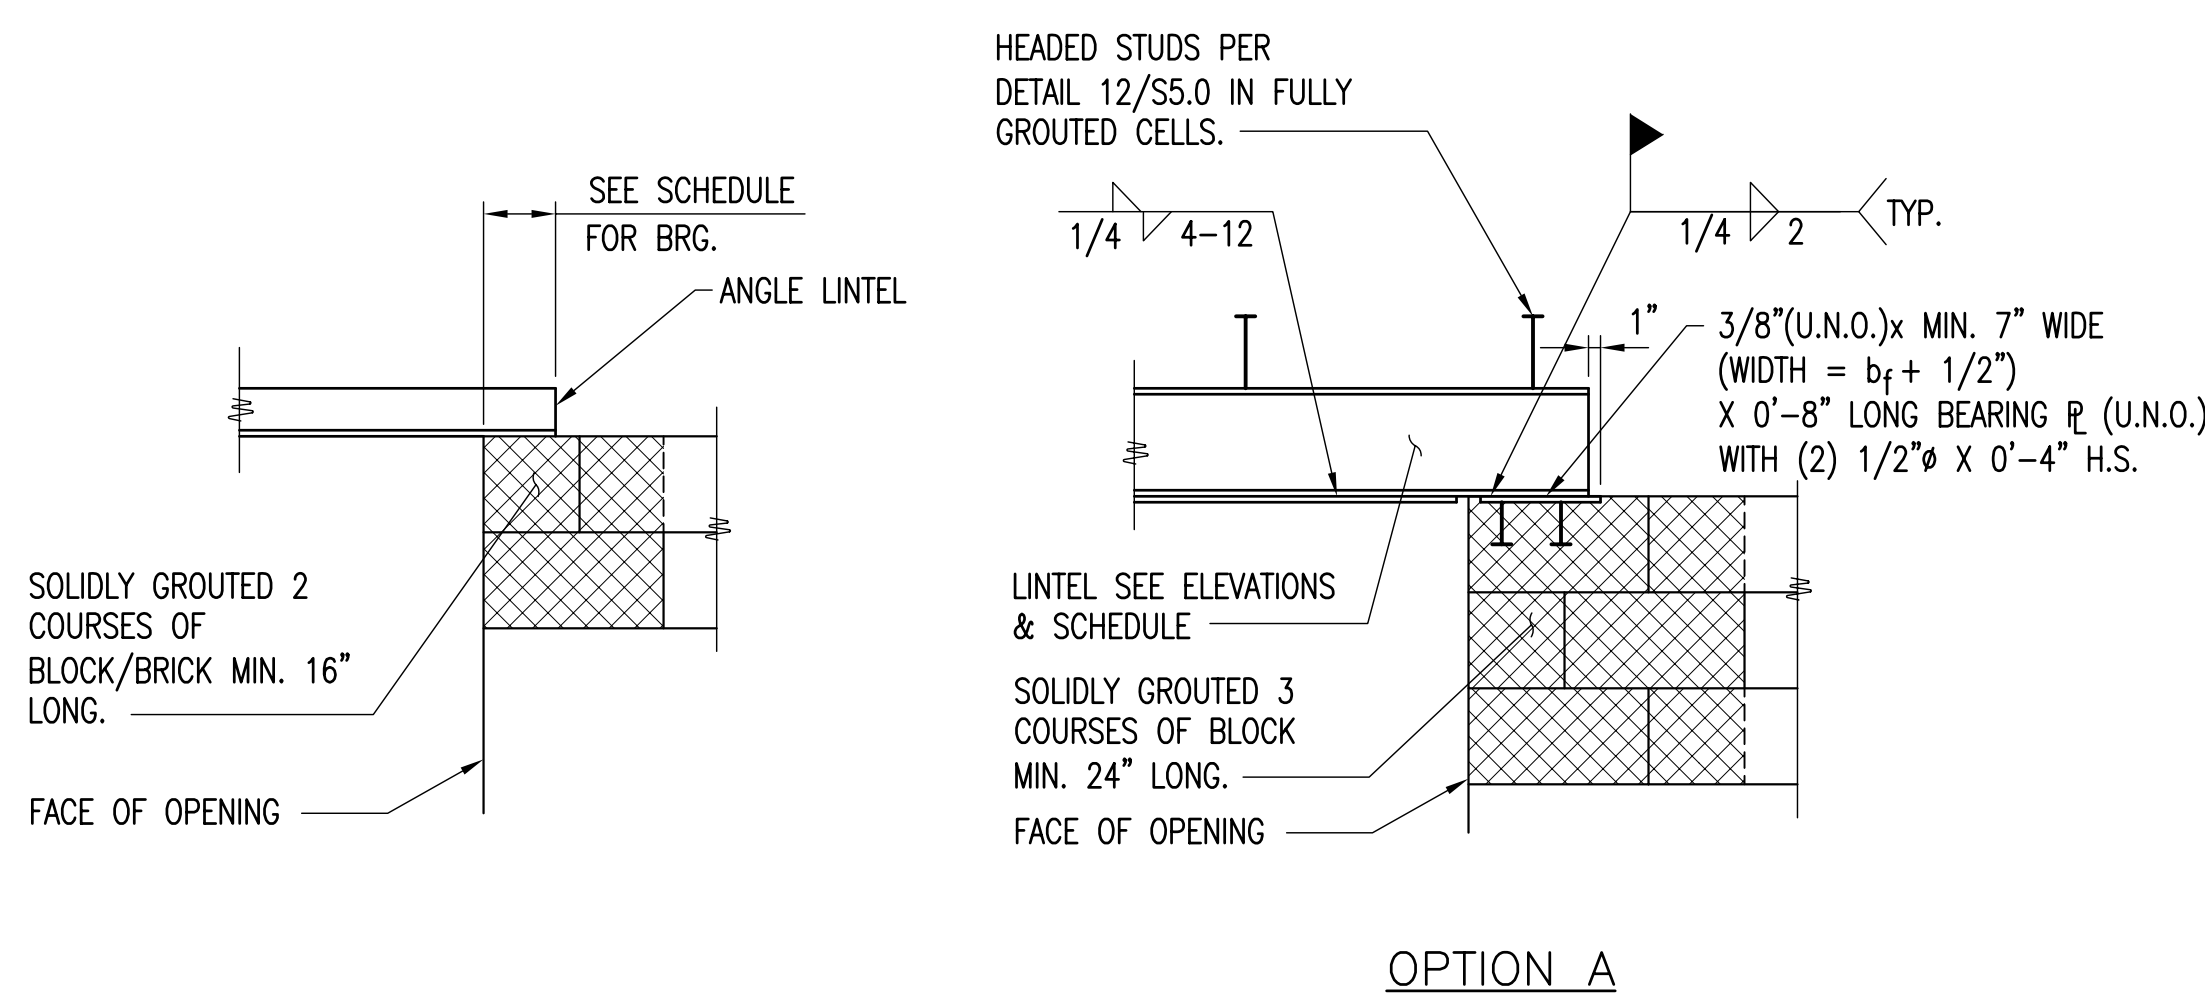

9 DETAIL AT STEEL LINTEL BEARING ON CMU
S5.0 N.T.S.

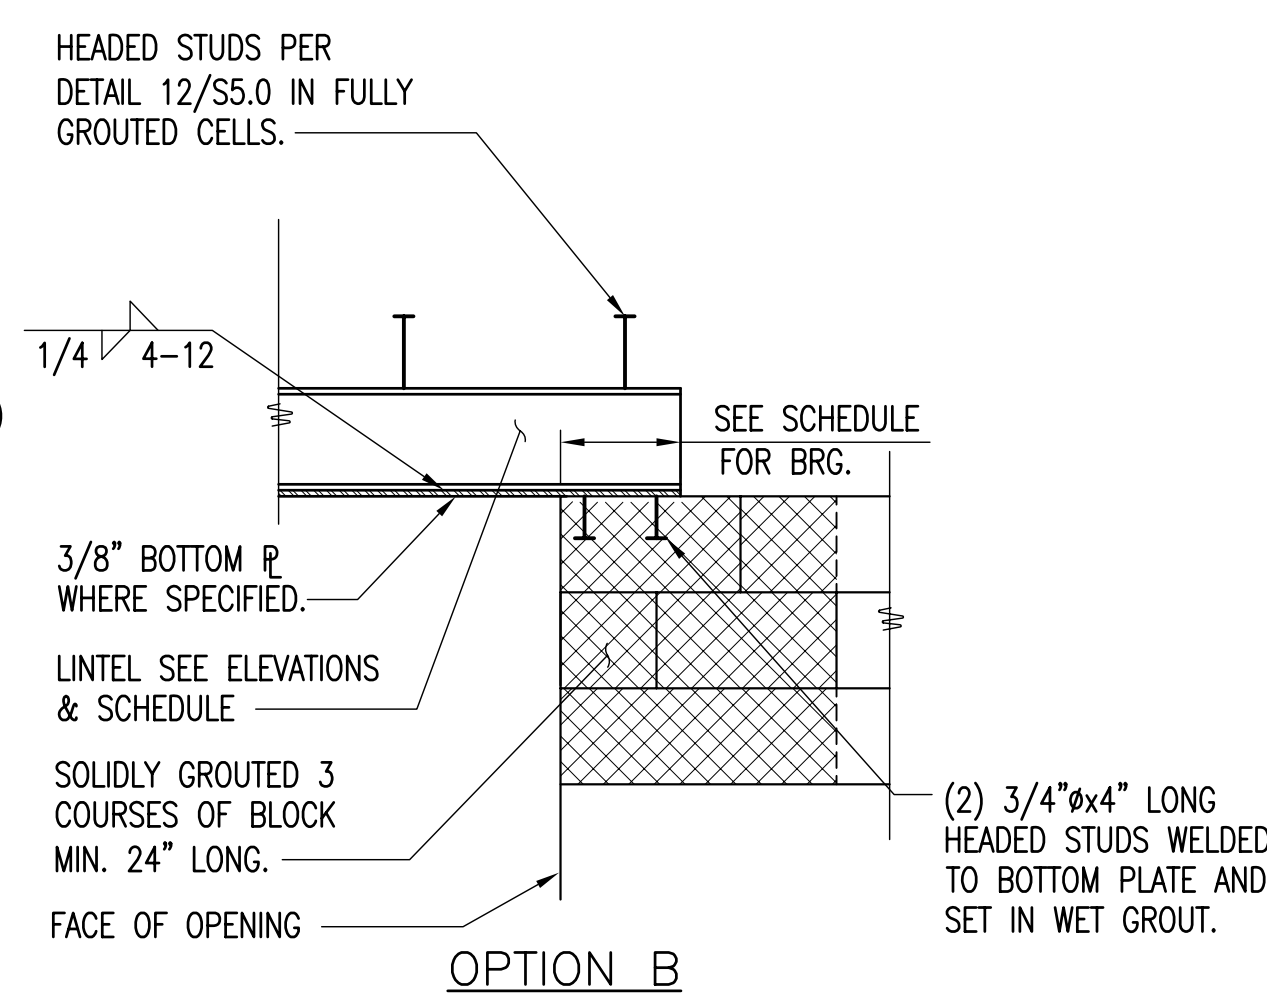

10 TYPICAL SECTION AT DECK BEARING ON CMU WALL
S5.0 3/4"=1'-0"

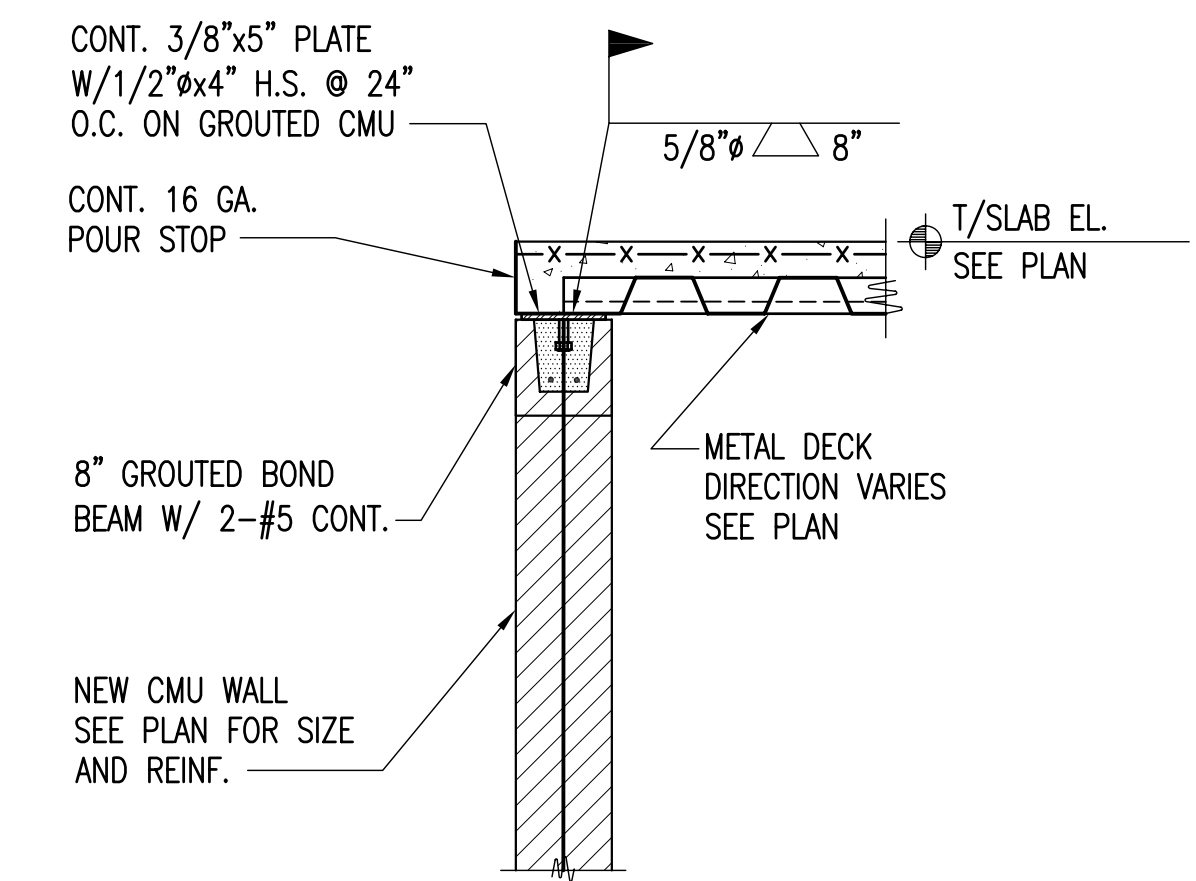

11 TYPICAL SECTION AT DECK BEARING ON TOP OF CMU WALL
S5.0 3/4"=1'-0"

LINTEL SCHEDULE (EXTERIOR AND INTERIOR)

LINTEL DESIGNATION	CLEAR SPAN	8" OR 10" CMU LINTEL	COLD-FORMED METAL	BRICK LINTEL (IF REQ'D)	EXIST. MASONRY	BEARING EA. END	REMARKS
L1	5'-0" OR LESS	16" TOTAL DEPTH GROUDED BOND BEAM W/2-#5	COLD-FORMED METAL HEADER	L4x3 1/2x 5/16 LLV	L4x3 1/2x 5/16 LLV PER 4" OF THICKNESS	4"	SOLIDLY GROUT CORE FOR TWO COURSES BELOW CMU LINTEL BRG. AT EA. END
L2	OVER 5'-0" TO 7'-0"	16" TOTAL DEPTH GROUDED BOND BEAM W/2-#5	COLD-FORMED METAL HEADER	L6x4x 3/8 LLV	L6x4x 3/8 LLV PER 4" OF THICKNESS	8"	SOLIDLY GROUT CORE FOR TWO COURSES BELOW CMU LINTEL BRG. AT EA. END
L3	OVER 7'-0" TO 8'-0"	16" TOTAL DEPTH GROUDED CMU BEAM W/2-#5	COLD-FORMED METAL HEADER	L6x3 1/2x3/8 LLV	W8x40 + 3/8" TOP PLATE	8"	SOLIDLY GROUT CORE FOR TWO COURSES BELOW CMU LINTEL BRG. AT EA. END SEE 2/S5.1 FOR LINTEL AT EXIST. MASONRY
L4	-	W8x21 + 3/8" BOT. PLATE	-	-	-	8"	SOLIDLY GROUT CORE FOR TWO COURSES BELOW CMU LINTEL BRG. AT EA. END

- ALL EXTERIOR STEEL LINTELS AND ATTACHED STEEL MEMBERS SHALL BE HOT DIP GALVANIZED AND PROPERLY FLASHED. SEE ARCH. DRAWINGS.
- CONTROL AND EXPANSION JOINTS SHALL NOT BE PLACED AT BEARING POINTS OR IN THE LINTEL SPAN.
- SEE 9/S5.0 FOR BEARING INFORMATION AT A STEEL LINTEL.

INTERIOR NON-LOAD BEARING MASONRY WALL REINFORCEMENT SCHEDULE

CMU WALL THICKNESS	MAX. HEIGHT OF CMU BETWEEN BRACE POINTS	REINFORCEMENT	REMARKS
4"	<= 8'-0"	#5 REBAR @ 32" O.C. IN FULLY GROUDED CELLS. TYP. U.N.O.	1. ADHERE TO TYPICAL DETAILS 1 THRU 6 ON S5.0. 2. USE #5 REBAR @ 24" O.C. IN FULLY GROUDED CELLS AT ALL WALLS OF STAIR ENCLOSURES, ELEVATOR ENCLOSURE. 3. USE #5 REBAR @ 32" O.C. IN FULLY GROUDED CELLS @ ALL WALLS OF FOUR HOUR VESTIBULE
6"	<= 14'-0"		
8" OR 10"	<= 16'-6"		

12 SECTION AT LINTEL
S5.0 1"=1'-0"



EDISON PARK ELEMENTARY SCHOOL ANNEX
6220 N. OLCOTT AVE
CHICAGO, IL 60631
CHICAGO PUBLIC SCHOOLS
CITY OF CHICAGO, MAYOR RAHM EMANUEL

THESE DRAWINGS HAVE BEEN PREPARED AT AND / OR UNDER MY SUPERVISION AND TO THE BEST OF MY KNOWLEDGE AND BELIEF CONFORM AND COMPLY WITH THE REQUIREMENTS OF THE CHICAGO DEPARTMENT OF BUILDING.

ILLINOIS
KATHLEEN O'DONNELL
REGISTERED ARCHITECT
001-016651
EXPIRATION DATE: NOVEMBER 30, 2014

TRIPARTITE, INC
Architecture Restoration Design

4720 N. Virginia Ave.
Chicago, Illinois 60625
P: 773-681-0894
www.tripartiteinc.com

MATRIX ENGINEERING CORPORATION
28 W. JACKSON BLDG. 8TH FLOOR CHICAGO, IL 60604
STRUCTURAL ENGINEERING

SITE DESIGN GROUP, LTD.
888 S. MICHIGAN AVE. SUITE 1000 CHICAGO, IL 60605
LANDSCAPE DESIGN

TERRA ENGINEERING, LTD.
225 W. GRAND STREET 4TH FLOOR CHICAGO, IL 60604
CIVIL ENGINEERING

CALOR DESIGN GROUP, LTD.
221 W. WEBSTER AVE. CHICAGO, IL 60607
MECHANICAL, PLUMBING, FIRE PROTECTION

TECHNOW ENGINEERING, LLC
30 E. ADAMS ST. SUITE 1100 CHICAGO, IL 60603
QUALITY CONTROL, LOW VOLTAGE SECURITY, FIRE ALARM

HJ KESSLER ASSOCIATES
360 N. LAKE SHORE DRIVE, SUITE 801 CHICAGO, IL 60613
LEED CONSULTING

EDGE ASSOCIATES, INC
220 E. LAKE STREET, SUITE 303 ADDISON, IL 60101
FOOD SERVICE

DOOR SECURITY SOLUTIONS
718 FOSTER AVE. BENSenville, IL 60106
HANDYMAN CONSULTING

PN DROP ASSOCIATES
251 W. LAKE STREET 18TH FLOOR CHICAGO, IL 60606
ACOUSTIC CONSULTANT

ISSUANCE

MARK	DESCRIPTION	DATE
1	ISSUE FOR PERMIT	12-18-12
2	ISSUE FOR ADDENDUM 1	1-17-13
3		
4		
5		
6		
7		
8		

SCALE: AS NOTED

PLOT DATE: 12/14/2012

PBC PROJECT: EDISON PARK ELEMENTARY SCHOOL ANNEX

PBC CONTRACT NO.: C1547


PROJECT NO.: 0650

WARRANTY: ASBESTOS-CONTAINING BUILDING MATERIALS ARE OR MAY BE PRESENT IN THIS BUILDING. AN ASBESTOS MANAGEMENT PLAN IS AVAILABLE IN THE PROJECT MANUAL. NO PERSON SHALL REMOVE OR DISTURB ASBESTOS-CONTAINING MATERIALS UNLESS THAT PERSON IS A LICENSED ASBESTOS WORKER OR CONDUCTS SUCH WORK IN ACCORDANCE WITH SPECIFIC REGULATIONS CONTAINED IN THE PROJECT DOCUMENTS AND IN COMPLIANCE WITH ILLINOIS DEPARTMENT OF HEALTH RULES AND REGULATIONS.


TITLE:
MASONRY DETAILS & SCHEDULES

SHEET


S5.0

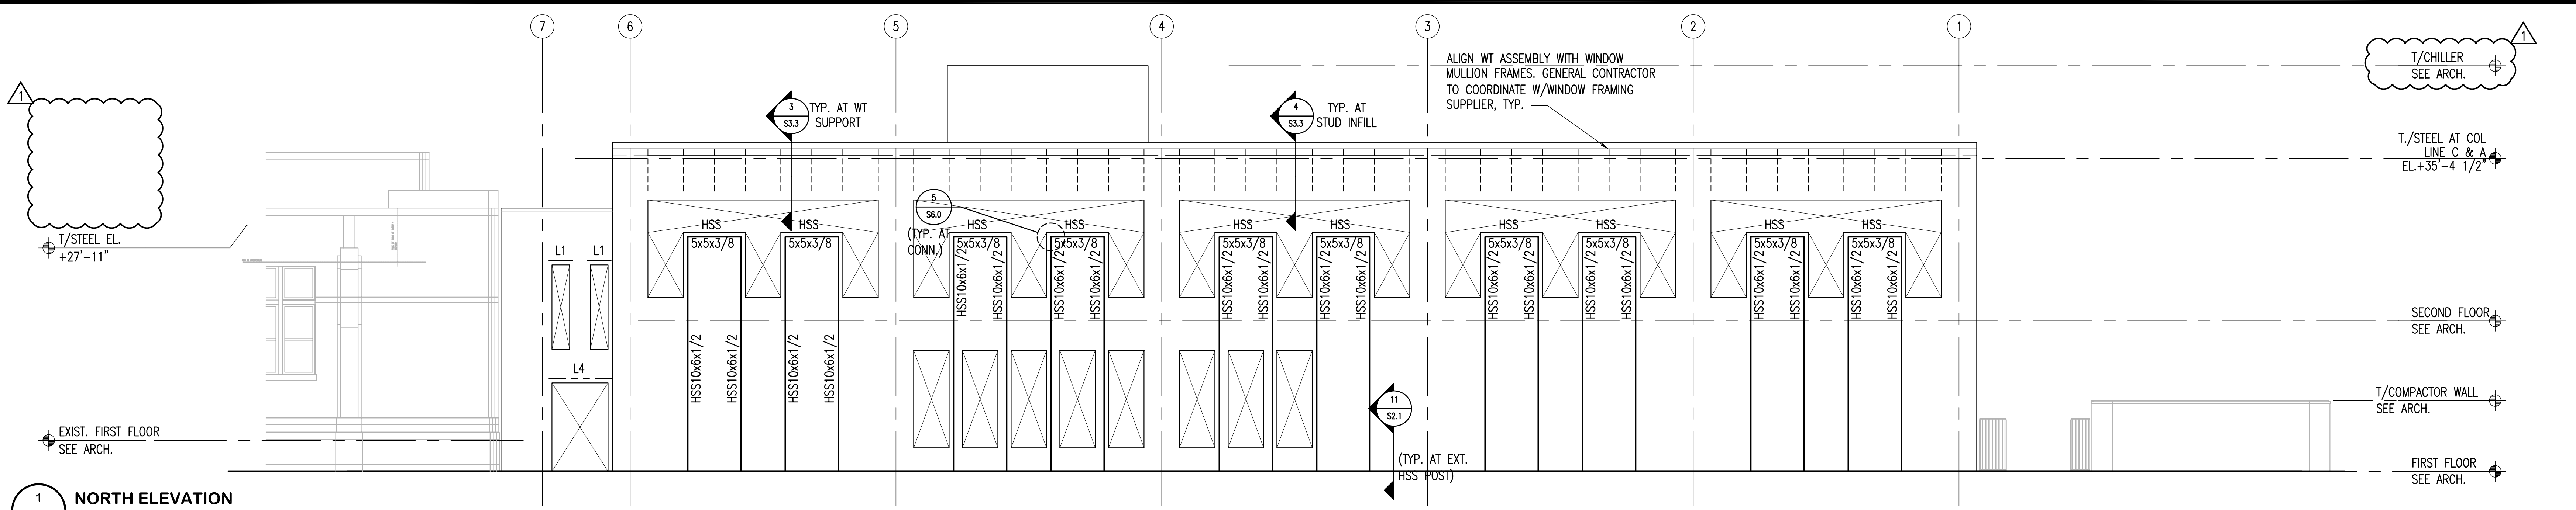


1 NORTH ELEVATION
S6.0 N.T.S.

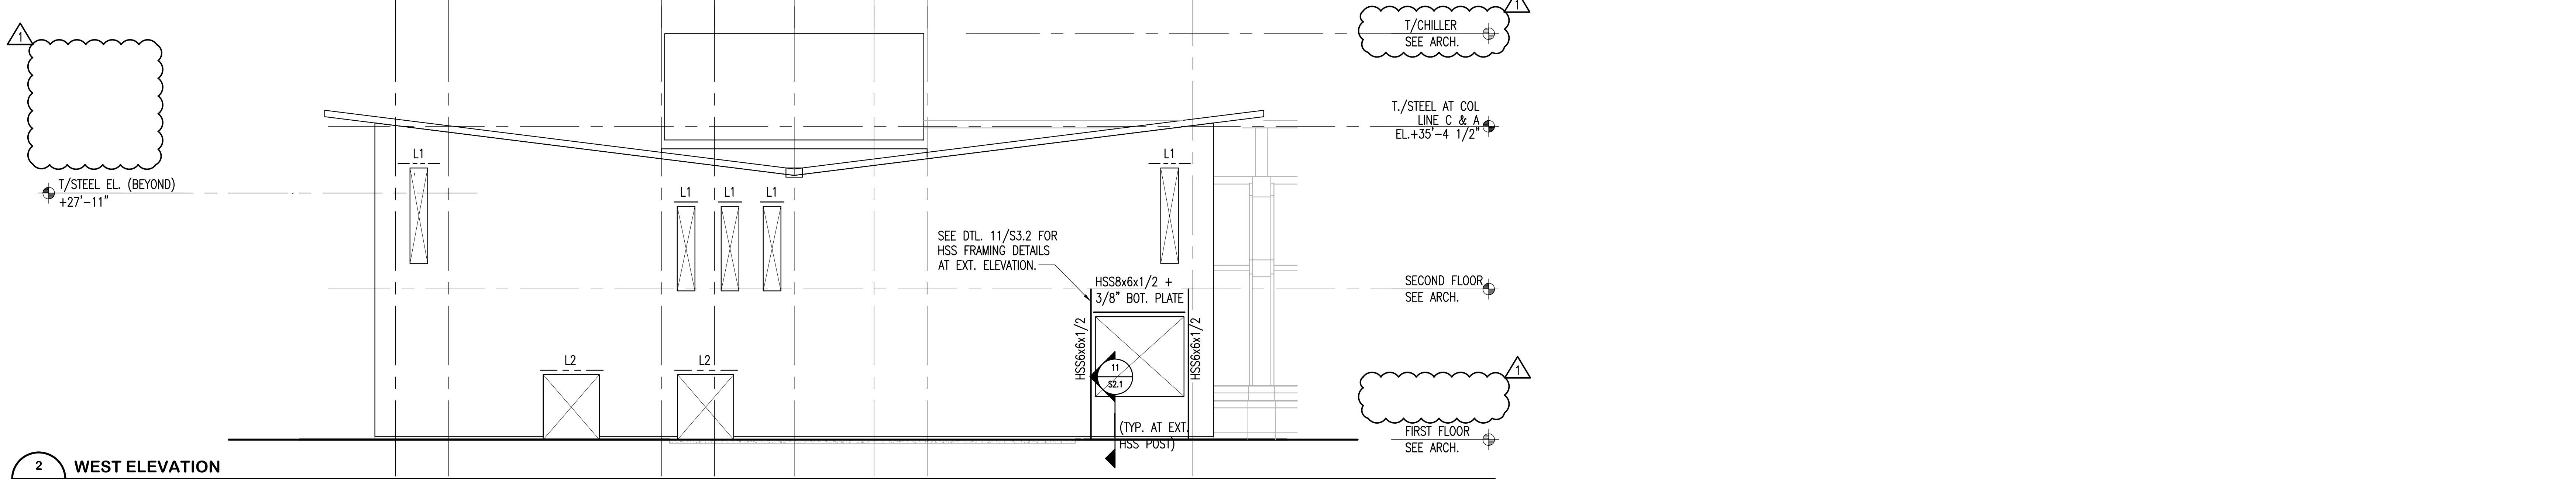


2 WEST ELEVATION
S6.0 N.T.S.

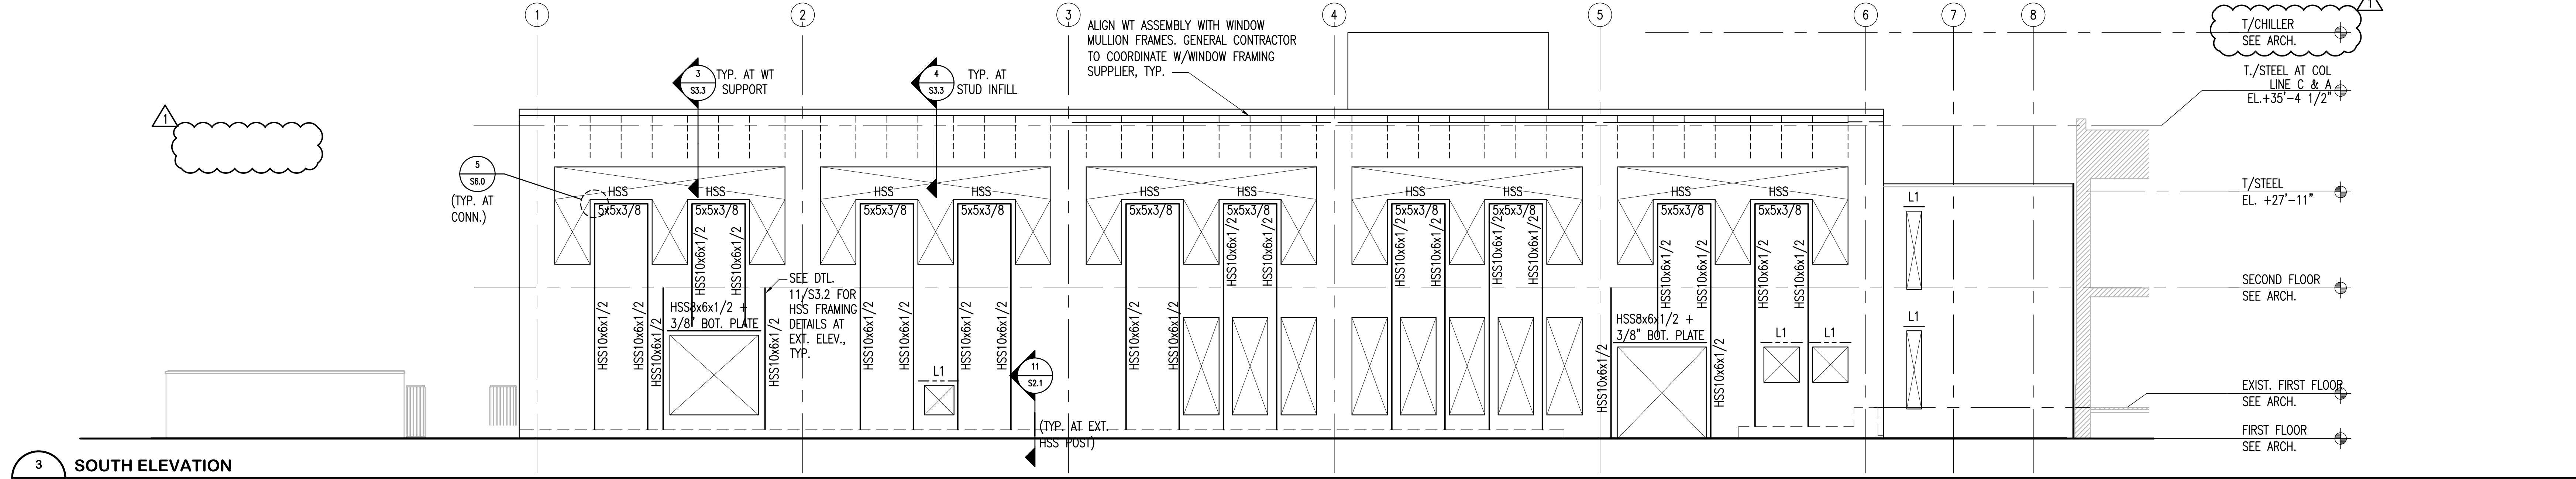

3 SOUTH ELEVATION
S6.0 N.T.S.

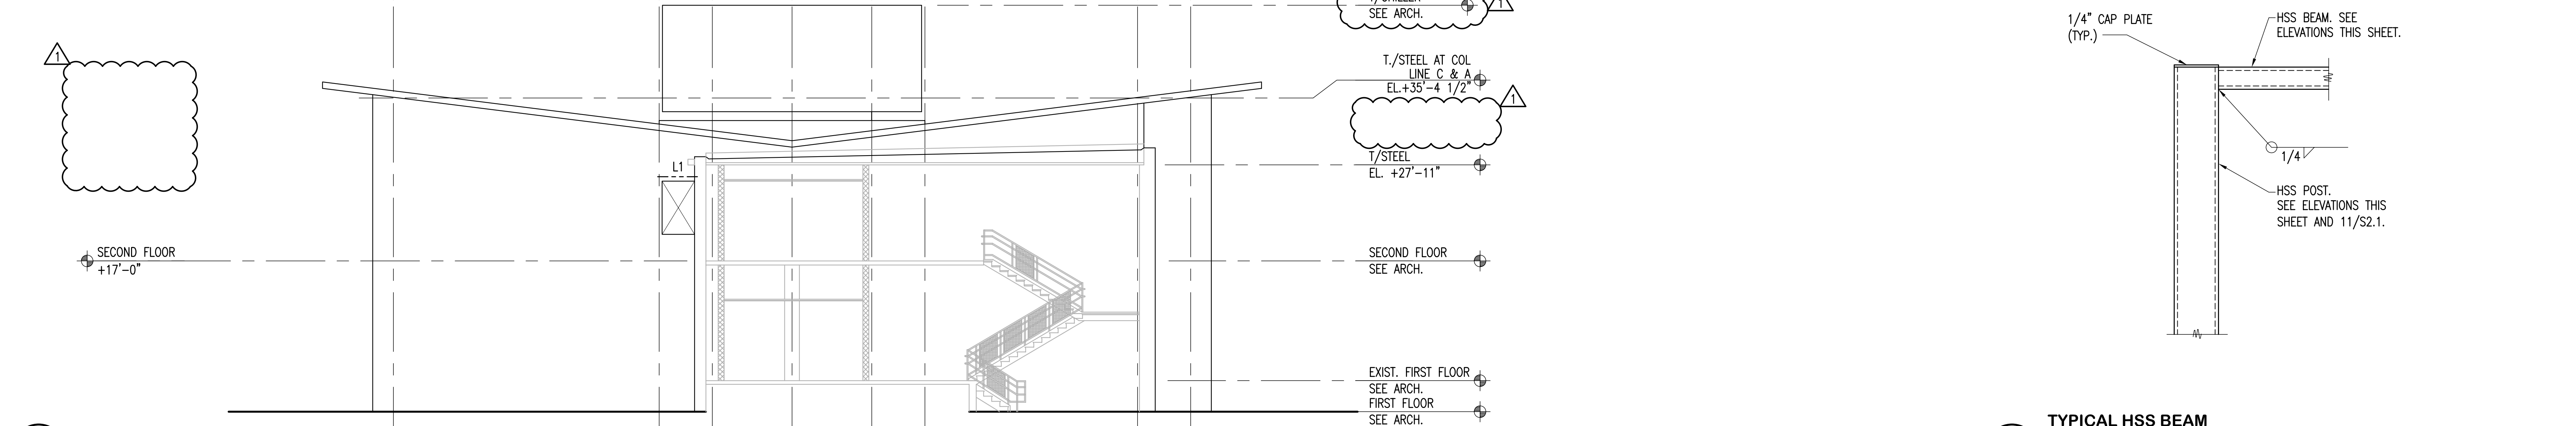

4 EAST ELEVATION
S6.0 N.T.S.

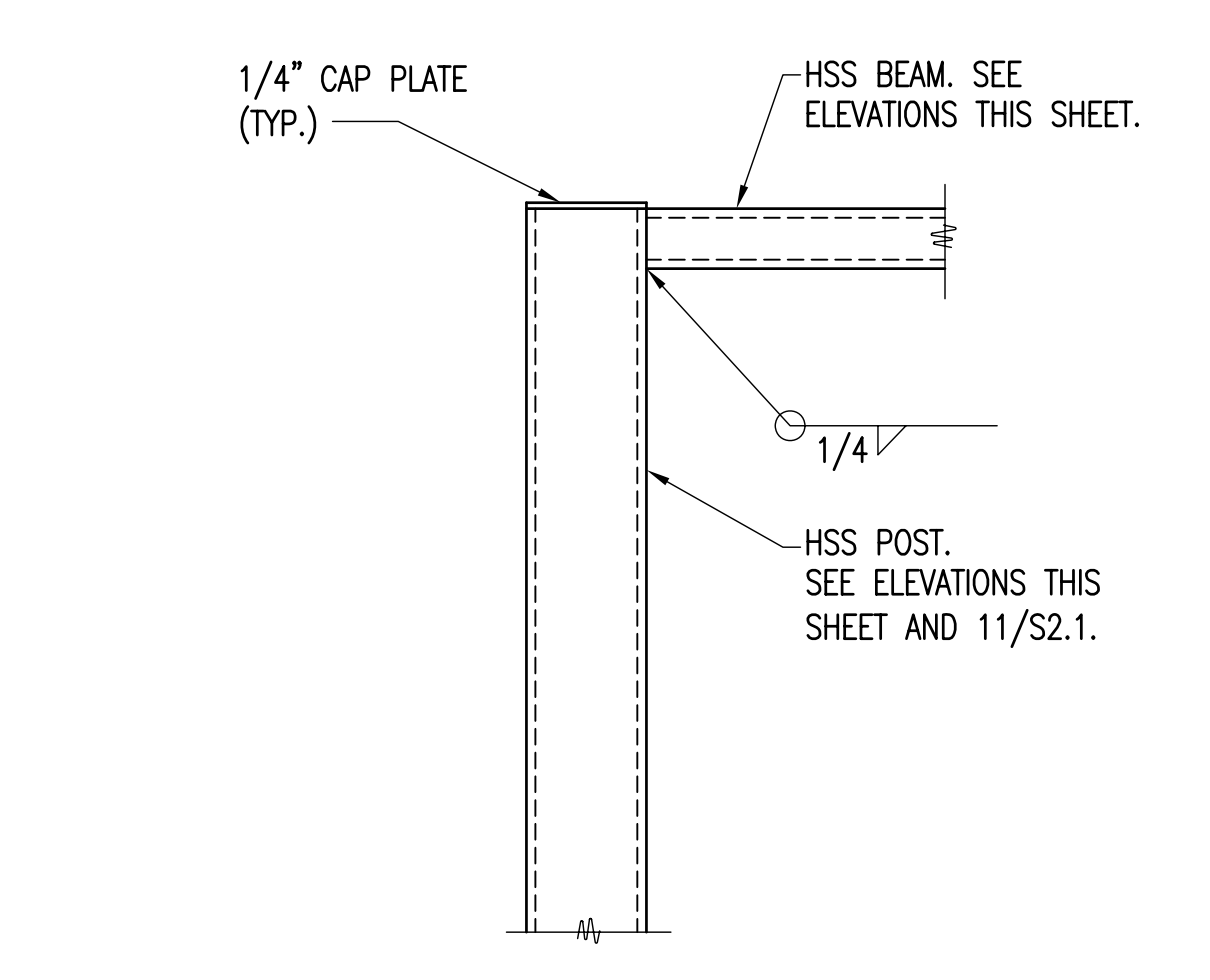

5 TYPICAL HSS BEAM TO HSS POST CONNECTION
S6.0 3/4\"=1'-0\"



EDISON PARK ELEMENTARY SCHOOL ANNEX
6220 N. OLCOTT AVE
CHICAGO, IL 60631
CHICAGO PUBLIC SCHOOLS
CITY OF CHICAGO, MAYOR RAHM EMANUEL

THESE DRAWINGS HAVE BEEN PREPARED AT AND / OR UNDER MY SUPERVISION AND TO THE BEST OF MY KNOWLEDGE AND BELIEF CONFORM AND COMPLY WITH THE REQUIREMENTS OF THE CHICAGO DEPARTMENT OF BUILDING.

ILLINOIS
KATHLEEN O'DONNELL
REGISTERED ARCHITECT
001-01-0351
EXPIRATION DATE: NOVEMBER 30, 2014

TRIPARTITE, INC
Architecture Restoration Design
4720 N. Virginia Ave.
Chicago, Illinois 60625
P: 773-681-0894
www.tripartiteinc.com

MATRIX ENGINEERING CORPORATION
28 W. JACKSON BLDG. 4TH FLOOR CHICAGO, IL 60604
STRUCTURAL ENGINEERING

SITE DESIGN GROUP, LTD.
886 S. MICHIGAN AVE. SUITE 1000 CHICAGO, IL 60605
LANDSCAPE DESIGN

TERRA ENGINEERING, LTD.
225 W. OHIO STREET 4TH FLOOR CHICAGO, IL 60604
CIVIL ENGINEERING

CALOR DESIGN GROUP, LTD.
221 N. WEBSTER AVE. CHICAGO, IL 60610
MECHANICAL, PLUMBING, FIRE PROTECTION

TECHNOW ENGINEERING, LLC
30 E. ADAMS ST. SUITE 1100 CHICAGO, IL 60603
QUALITY CONTROL, LOW VOLTAGE SECURITY, FIRE ALARM

HJ KESSLER ASSOCIATES
360 N. LAKE SHORE DRIVE, SUITE 801 CHICAGO, IL 60613
LEED CONSULTING

EDGE ASSOCIATES, INC
220 E. LAKE STREET, SUITE 303 ADDISON, IL 60101
FOOD SERVICE

DOOR SECURITY SOLUTIONS
718 FOSTER AVE. BENSenville, IL 60156
WINDOW CONSULTANT

PN DROP ACOUSTICS
201 W. LAKE STREET 4TH FLOOR CHICAGO, IL 60606
ACOUSTIC CONSULTANT


MARK	DESCRIPTION	DATE
1	ISSUE FOR PERMIT	12-18-12
2	ISSUE FOR ADDENDUM 1	1-17-13
3		
4		
5		
6		
7		
8		

SCALE: AS NOTED
PLOT DATE: 12/14/2012
PBC PROJECT: EDISON PARK ELEMENTARY SCHOOL ANNEX
PBC CONTRACT NO.: C1547
PROJECT NO.: 05650


WARNING:
ASBESTOS-CONTAINING BUILDING MATERIALS ARE OR MAY BE PRESENT IN THIS BUILDING. AN ASBESTOS MANAGEMENT PLAN IS AVAILABLE IN THE PROJECT MANUAL. REQUESTOR AND PERSON MAY DISTURB ASBESTOS-CONTAINING MATERIALS UNLESS THAT PERSON IS A LICENSED ASBESTOS WORKER OR CONDUCTS SUCH WORK IN ACCORDANCE WITH SPECIFICATIONS CONTAINED IN THE PROJECT DOCUMENTS AND IN COMPLIANCE WITH ILLINOIS DEPARTMENT OF HEALTH RULES AND REGULATIONS.

TITLE:
BUILDING ELEVATIONS

SHEET
S6.0

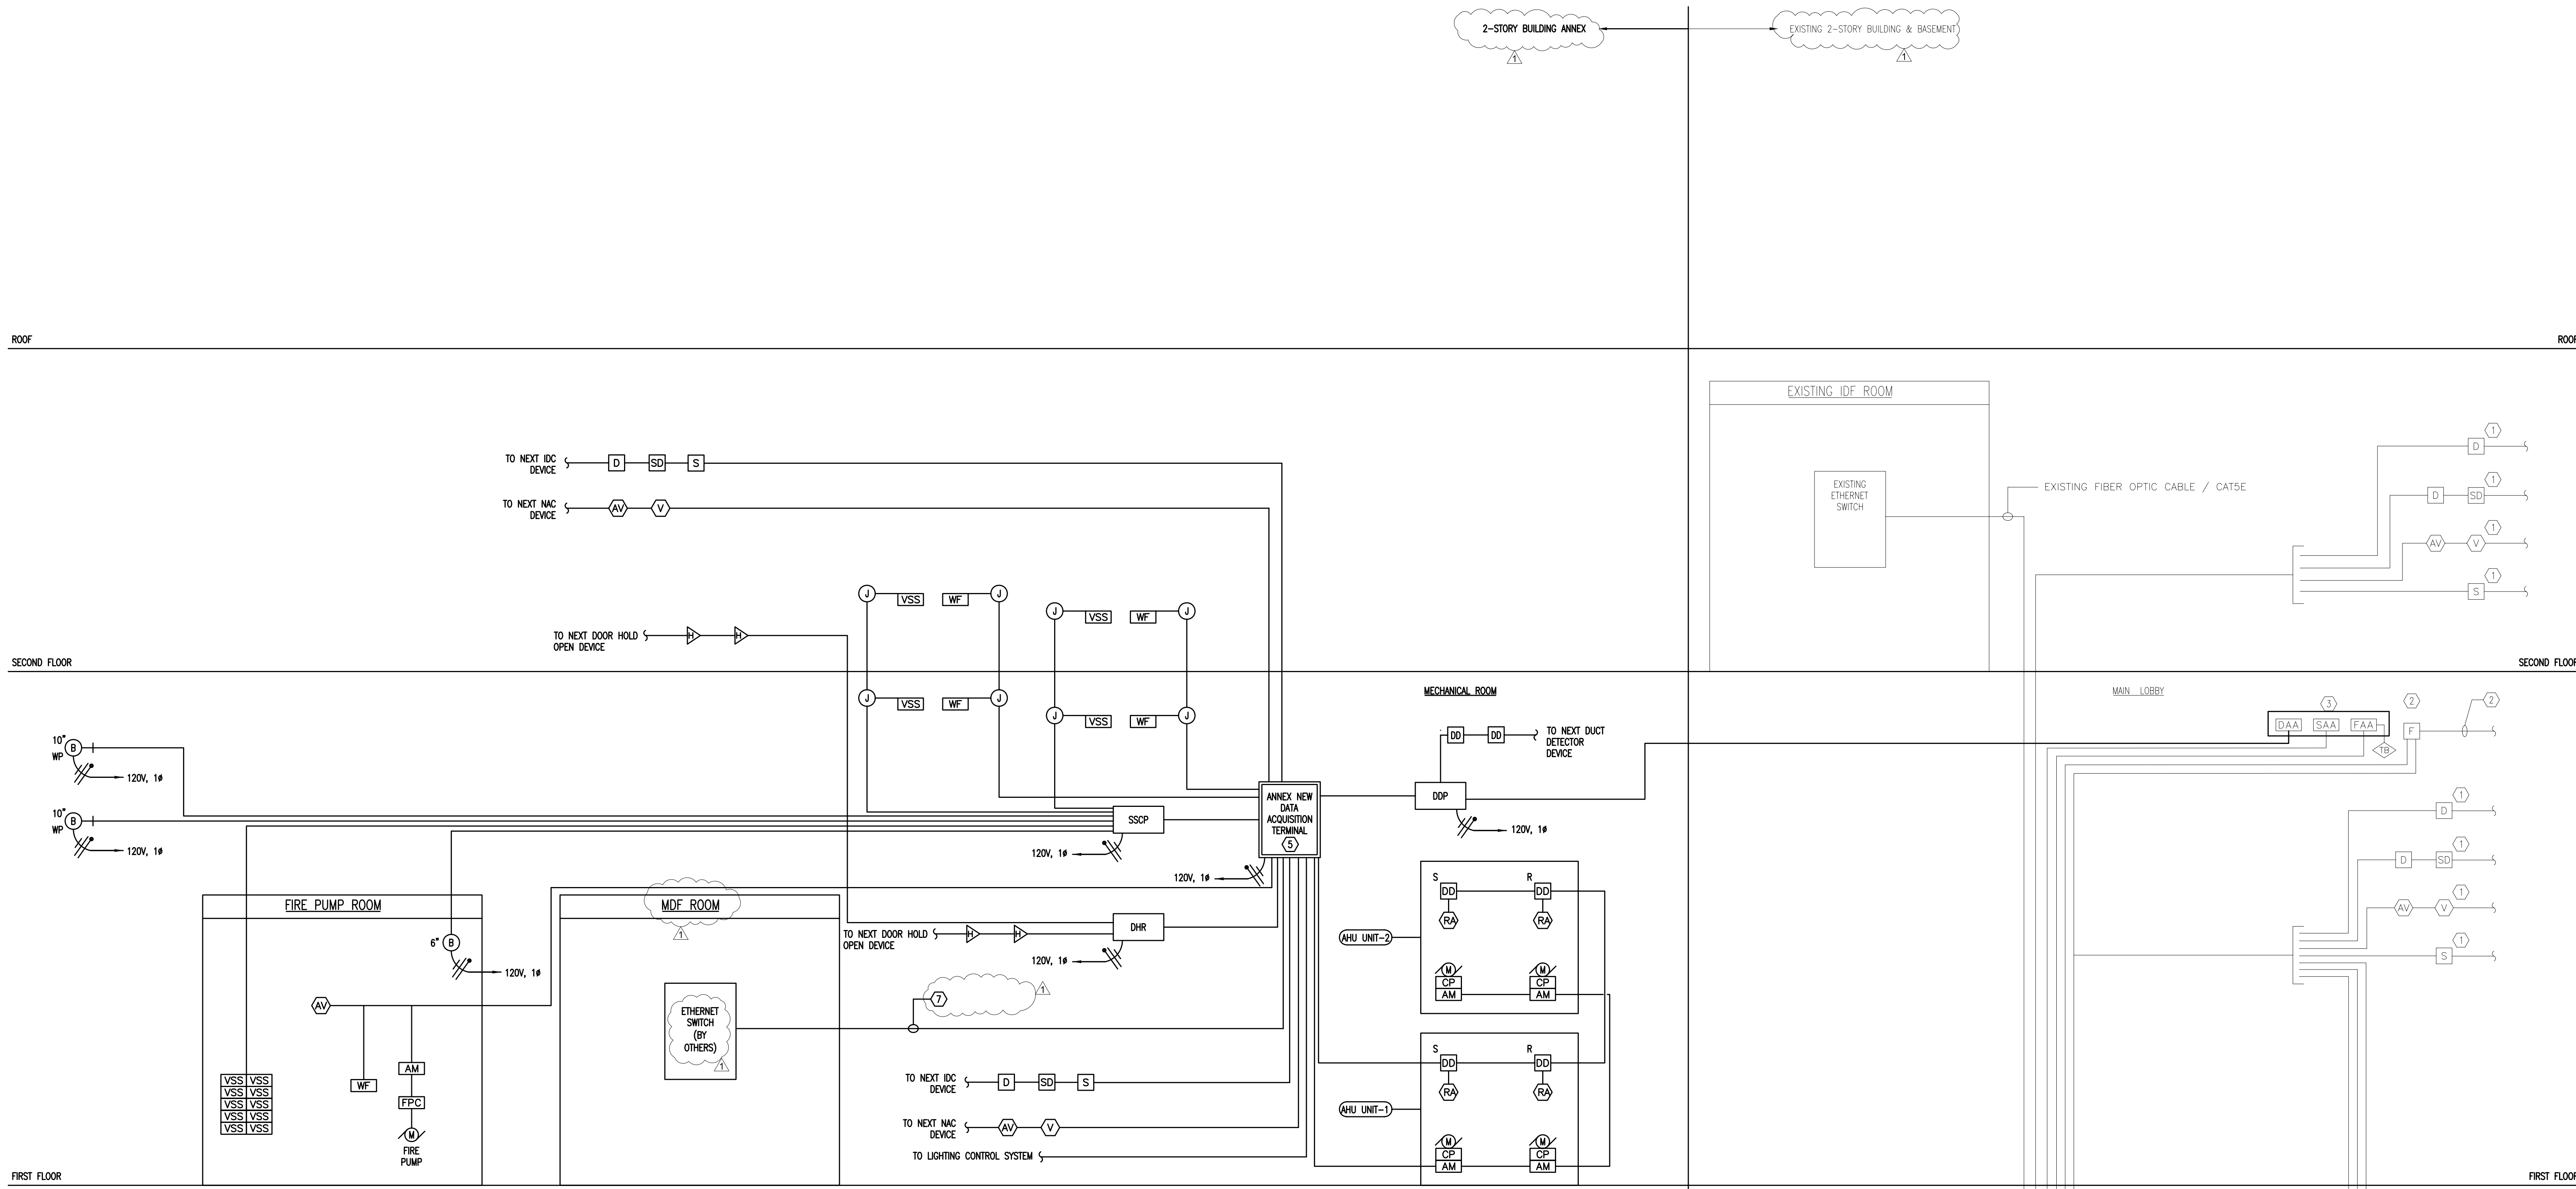

1 FIRE ALARM SYSTEM RISER DIAGRAM
 E4.2 SCALE: N.T.S.

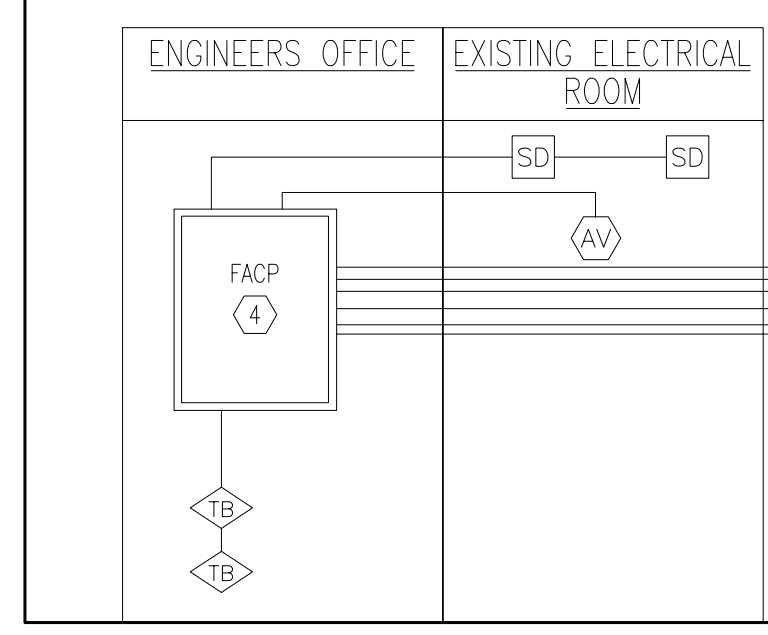


NOTES:

- RISER DIAGRAM ABOVE IS DIAGRAMMATIC AND IS SHOWN TO PROVIDE A GENERAL OVERVIEW OF MAJOR SYSTEM COMPONENTS AND THEIR INTERCONNECTIONS. THIS DIAGRAM IS NOT TO BE USED FOR FIELD INSTALLATION PURPOSES. DEVICES SHOWN IN LIGHTWEIGHT LINES ARE EXISTING TO REMAIN, UNO. DEVICES SHOWN IN DARK/HEAVY LINES ARE NEW.
- THIS SYSTEM SHALL BE INSTALLED IN ACCORDANCE WITH NFPA 72.
- SEE PLANS FOR DEVICE LOCATIONS AND QUANTITIES.
- PROVIDE ALL ANCILLARY COMPONENTS, HARDWARE, POWER CONNECTIONS AND WIRING AS REQUIRED FOR A COMPLETE AND OPERATING FIRE ALARM SYSTEM.
- ALL WIRING SHALL BE IN CONDUIT, 3/4" MINIMUM. ALL WIRING SHALL BE PROVIDED PER MANUFACTURER'S RECOMMENDATIONS.
- ALL VISUAL DEVICE OPERATION SHALL BE SYNCHRONIZED IN COMPLIANCE WITH ICC/ANSI A117.1-2003 SECTION 7.702.
- REUSE EXISTING RACEWAY AND WIRING WHERE POSSIBLE.
- REMOVE ANY EXISTING DEVICES NOT SCHEDULED TO REMAIN AFTER NEW SYSTEM IS INSTALLED, TESTED, AND APPROVED BY AHI.
- ALL WIRING PROVIDED SHALL BE INSTALLED TO FULFILL VOLTAGE DROP REQUIRED BY NFPA STANDARDS. PROVIDE ENOUGH BATTERY POWER TO FEED ALL HORNS, DETECTORS, DAMPER CONTROL MODULES, AND ALL FP EQUIPMENT.


KEYED NOTES:

- CONNECT EXISTING DEVICES SCHEDULED TO REMAIN TO NEW FIRE ALARM CONTROL PANEL.
- EXISTING CITY TIE DEVICE TO REMAIN. CITY TIE BOX LOCATED IN MAIN ENTRANCE OF EXISTING BUILDING.
- REPLACE EXISTING FAI TO ACCOMMODATE NEW FIRE ALARM SYSTEM. REUSE EXISTING RACEWAY. FAI SHALL BE A CHICAGO-APPROVED MODEL.
- EXISTING FIRE ALARM CONTROL PANEL LOCATED IN MAIN OFFICE FIRST FLOOR. MODIFY EXISTING FIRE ALARM CONTROL PANEL WITH NEW ADDRESSABLE CITY OF CHICAGO APPROVED CONTROL PANEL. PROVIDE ADDRESSABLE MODULES CARDS IN NEW PANEL AS NECESSARY TO INCORPORATE EXISTING DEVICES.
- SIEMENS 1724-22 OR NOTIFIER NFS2-640 DATA ACQUISITION TERMINAL IN ANNEX MECHANICAL ROOM.
- DISCONNECT, REMOVE, AND REPLACE EXISTING FIRE ALARM TROUBLE BELLS WITH NEW.
- PROVIDE FIBER OPTIC CABLE PER MANUFACTURER'S RECOMMENDATIONS TO TRANSMIT DATA FOR ALL CONNECTED DEVICES.

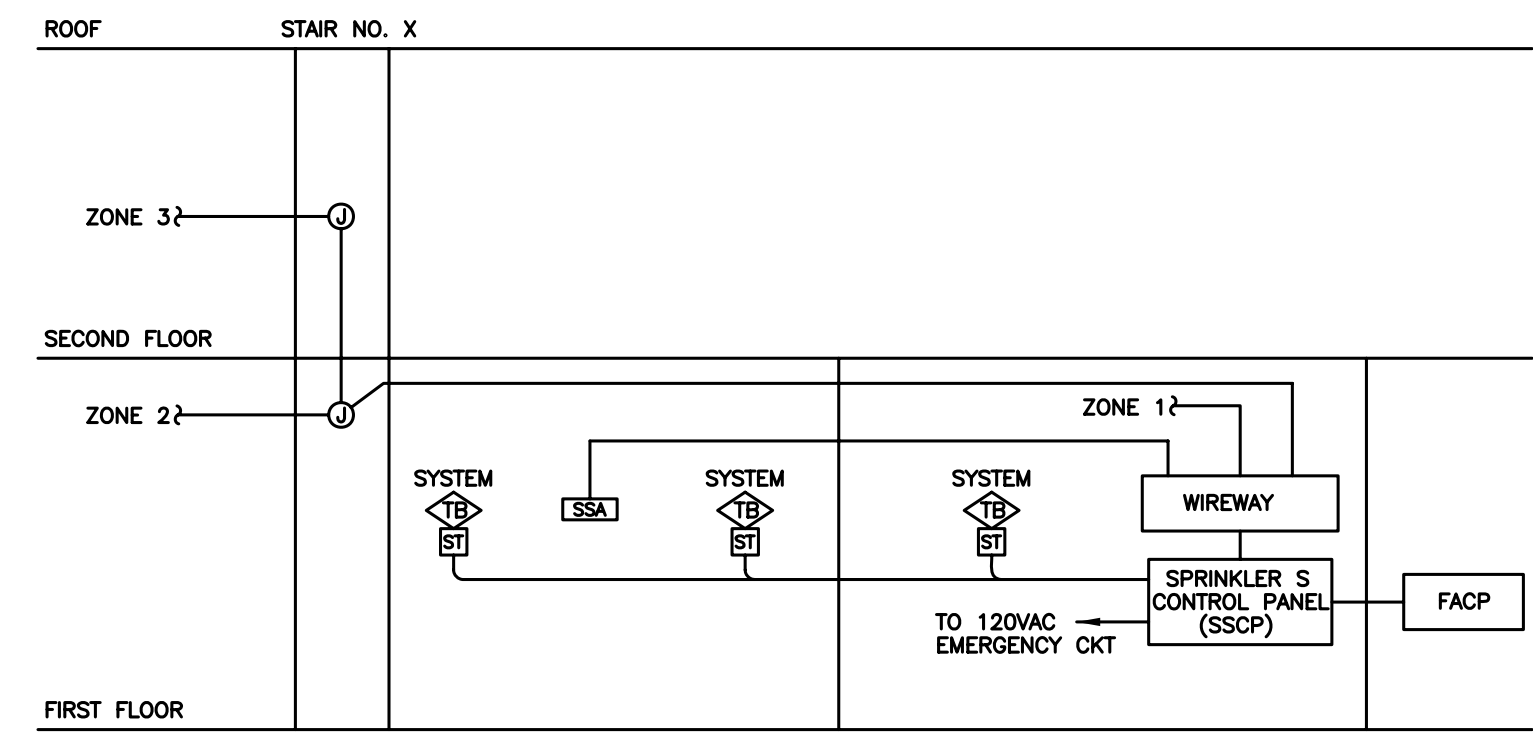

2 SPRINKLER SUPERVISORY SYSTEM RISER DIAGRAM
 E4.2 SCALE: N.T.S.

- NOTES:**
- RISER DIAGRAM ABOVE IS DIAGRAMMATIC AND IS SHOWN TO PROVIDE A GENERAL OVERVIEW OF MAJOR SYSTEM COMPONENTS AND THEIR INTERCONNECTIONS. THIS DIAGRAM IS NOT TO BE USED FOR FIELD INSTALLATION PURPOSES.
 - ALL WIRING SHALL BE IN CONDUIT, 3/4" MINIMUM. ALL WIRING SHALL BE PROVIDED PER MANUFACTURER'S RECOMMENDATIONS.
 - SEE PLANS FOR DEVICE LOCATIONS AND QUANTITIES.
 - PROVIDE ALL ANCILLARY COMPONENTS, HARDWARE, POWER CONNECTIONS AND WIRING AS REQUIRED FOR A COMPLETE AND OPERATING VALVE SUPERVISORY (VAMP) SYSTEM.

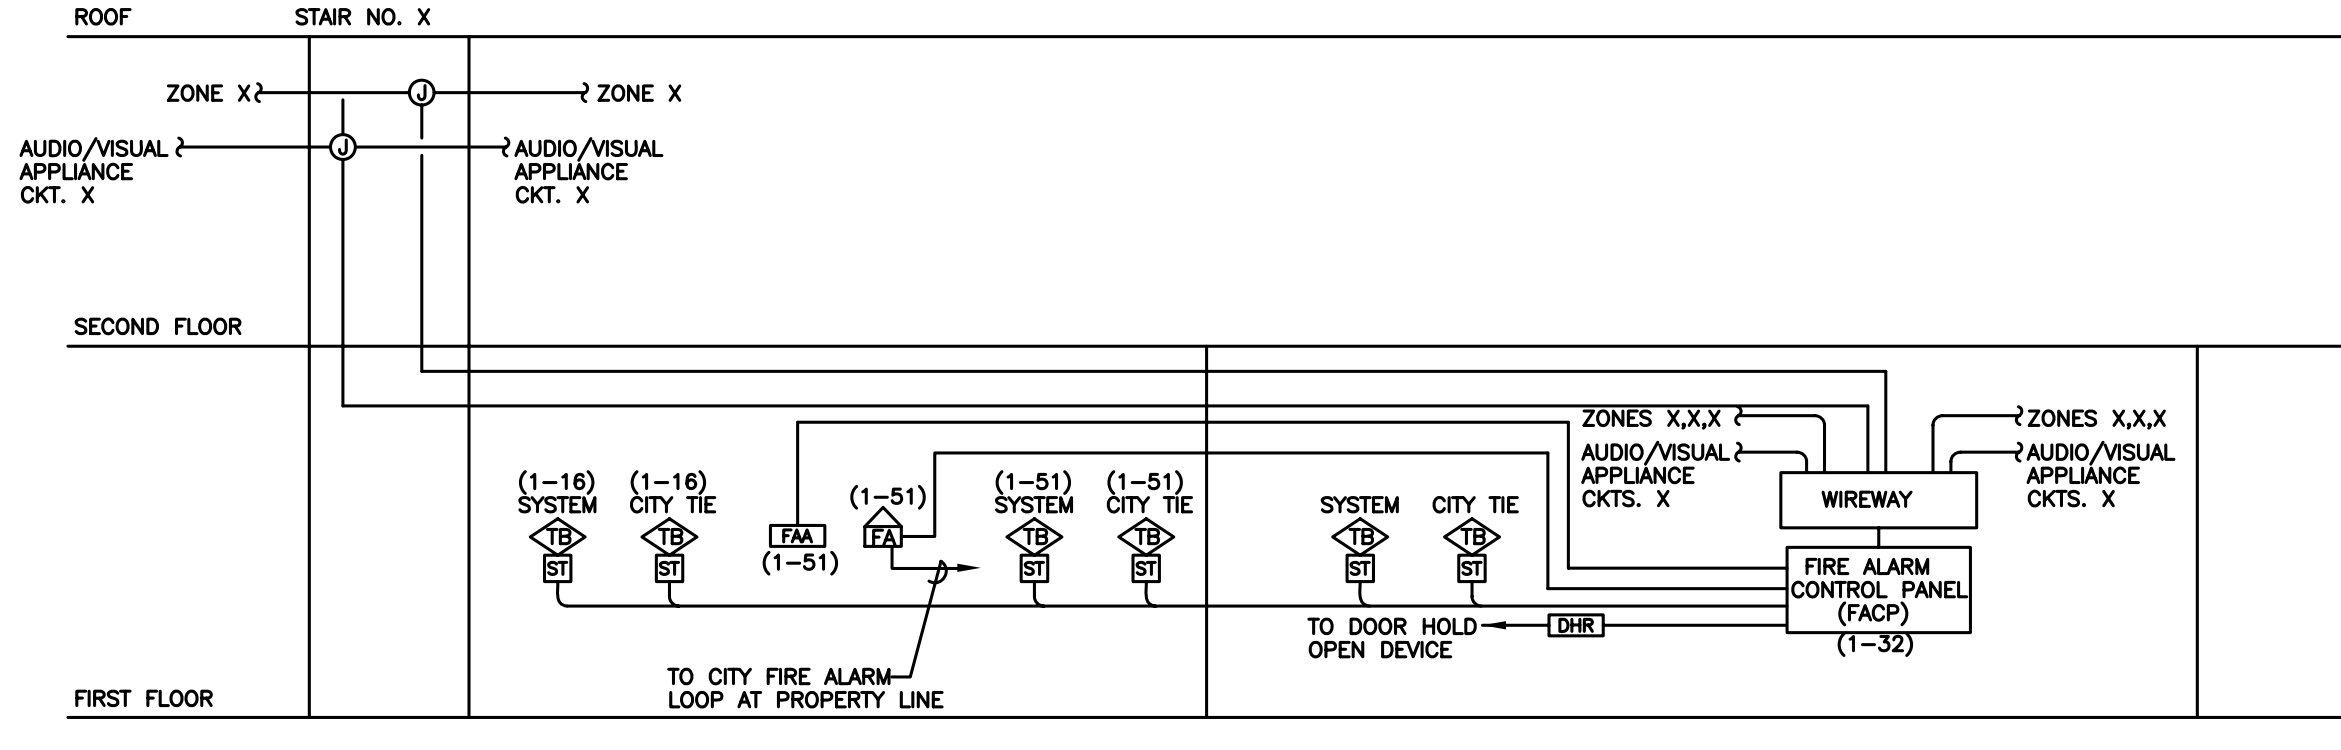

3 FIRE ALARM SYSTEM RISER DIAGRAM
 E4.2 SCALE: N.T.S.

- NOTES:**
- RISER DIAGRAM ABOVE IS DIAGRAMMATIC AND IS SHOWN TO PROVIDE A GENERAL OVERVIEW OF MAJOR SYSTEM COMPONENTS AND THEIR INTERCONNECTIONS. THIS DIAGRAM IS NOT TO BE USED FOR FIELD INSTALLATION PURPOSES.
 - SEE PLANS FOR DEVICE LOCATIONS AND QUANTITIES.
 - PROVIDE ALL ANCILLARY COMPONENTS, HARDWARE, POWER CONNECTIONS AND WIRING AS REQUIRED FOR A COMPLETE AND OPERATING FIRE ALARM SYSTEM.



EDISON PARK ELEMENTARY SCHOOL ANNEX
 6220 N. OLCOTT AVE
 CHICAGO, IL 60631
 CHICAGO PUBLIC SCHOOLS
 CITY OF CHICAGO, MAYOR RAHM EMANUEL

THESE DRAWINGS HAVE BEEN PREPARED AT AND / OR UNDER MY SUPERVISION AND TO THE BEST OF MY KNOWLEDGE AND BELIEF CONFORM AND COMPLY WITH THE REQUIREMENTS OF THE CHICAGO DEPARTMENT OF BUILDING.

ILLINOIS
 KATHLEEN O'DONNELL
 REGISTERED ARCHITECT
 001-016351
 EXPIRATION DATE: NOVEMBER 30, 2012

TRIPARTITE, INC
 Architecture Restoration Design
 4720 N. Virginia Ave.
 Chicago, Illinois 60625
 P: 773-581-0594
 www.tripartiteinc.com

MATRIX ENGINEERING CORPORATION
 3318 JACKSON BLVD, 4TH FLOOR, CHICAGO, IL 60654
 STRUCTURAL ENGINEERING

SITE DESIGN GROUP, LTD.
 600 N. MICHIGAN AVE, SUITE 1001 CHICAGO, IL 60605
 LANDSCAPE DESIGN

TERRA ENGINEERING, LTD.
 225 W. OHIO STREET, 4TH FLOOR / CHICAGO, IL 60604
 CIVIL ENGINEERING

CALOR DESIGN GROUP, LTD.
 2017 N. WESTERN AVE. / CHICAGO, IL 60647
 MECHANICAL, PLUMBING, FIRE PROTECTION

TECHKNOW ENGINEERING, LLC
 1816 S. MICHIGAN ST. SUITE 1100 CHICAGO, IL 60605
 QUALITY CONTROL, LOW VOLTAGE, SECURITY, FIRE ALARM

HJ KESSLER ASSOCIATES
 1860 N. LAKE SHORE DRIVE, SUITE 501 CHICAGO, IL 60613
 LEED CONSULTING

EDGE ASSOCIATES, INC
 205 S. LAKE STREET, SUITE 303 / ADDISON, IL 60101
 FOOD SERVICES

DOOR SECURITY SOLUTIONS
 114 KOSTER AVE. / BENSenville, IL 60009
 HARDWARE CONSULTANT

PIN DROP ACOUSTICS
 201 W. LAKE STREET, #100 / CHICAGO, IL 60606
 ACOUSTIC CONSULTANT

ISSUANCE

MARK	DESCRIPTION	DATE
1	ISSUE FOR BID	12-18-12
2	ADDENDUM #1	01-17-13
3		
4		
5		
6		
7		
8		

SCALE: AS NOTED
 PLOT DATE: 1/16/2013
 PROJECT NAME: EDISON PARK ELEMENTARY SCHOOL ANNEX
 PROJECT NO.: 05650

PBC CONTRACT NO.: -
 ASBESTOS-CONTAINING BUILDING MATERIALS ARE OR MAY BE PRESENT IN THE BUILDING. AN ASBESTOS MANAGEMENT PLAN IS AVAILABLE IN THE SCHOOL, FOR REVIEW UPON REQUEST. NO PERSONS SHALL REMOVE OR DESTROY CONTAINMENT MATERIALS UNLESS THAT PERSON IS A LICENSED ASBESTOS WORKER OR CONTRACTOR WHO WORKS IN ACCORDANCE WITH THE SPECIFICATIONS CONTAINED IN THE PROJECT DOCUMENTS AND IN COMPLIANCE WITH ILLINOIS DEPARTMENT OF HEALTH RULES AND REGULATIONS.

TITLE:
 FIRE ALARM SYSTEM RISER DIAGRAM

SHEET
E4.2