



AS BUILT CONDITIONS MAP HAAS PARK FIELD HOUSE CHICAGO, ILLINOIS

NOTE: ALL LOCATIONS DEPICTED HEREON ARE APPROXIMATE AND ARE TO BE USED FOR ELEVATION REFERENCE ONLY. NO HORIZONTAL POSITION SHOULD BE DERIVED FROM THIS MAP.

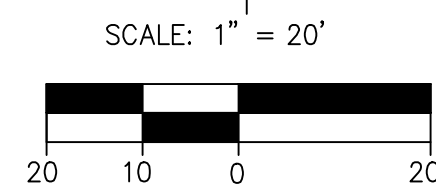

- 1: CUT CROSS IN GARAGE FLOOR:
ELEV. = 15.59 (7/28/10)
- 2: CUT CROSS IN GARAGE FLOOR:
ELEV. = 15.92 (7/28/10)
- 3: CUT CROSS IN GARAGE FLOOR:
ELEV. = 16.09 (7/28/10)
- 4: CUT CROSS IN 1ST FLOOR WINDOW SILL:
ELEV. = 17.15 (7/28/10)

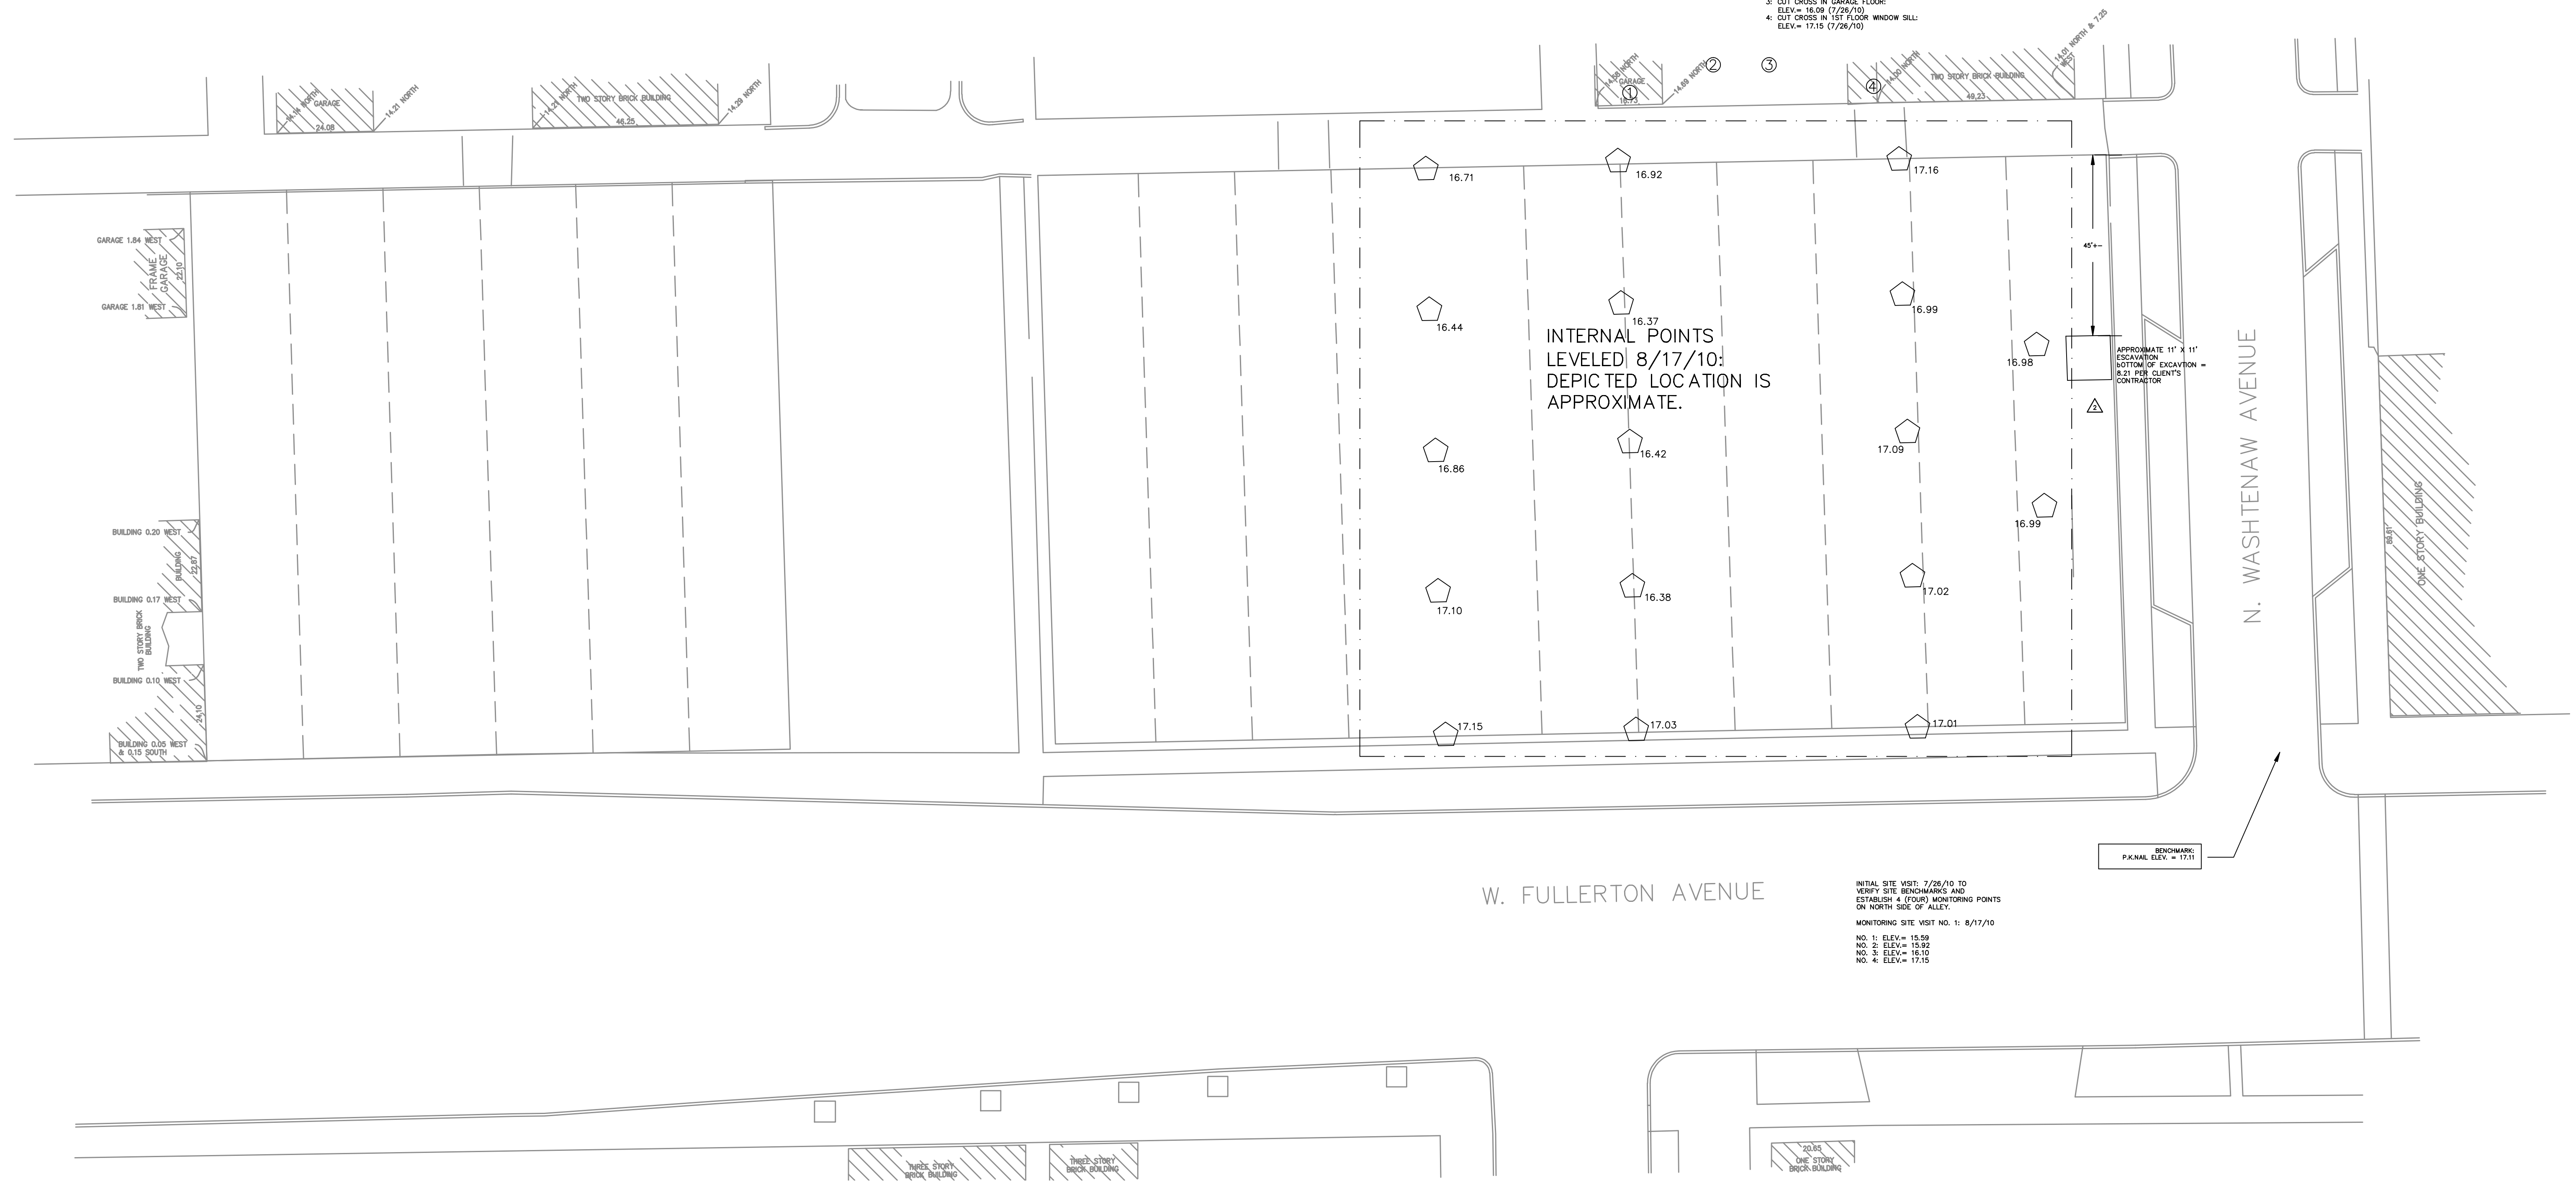

NO.	DATE	DESCRIPTION	BY
2	08/26/10	ADD SITE CONTRACTOR'S INFORMATION PER CLIENT	SP
1	08/25/10	REMOVE SITE IMPROVEMENTS	SP
-	08/25/10	ISSUE DATE	SP

MIDWEST TECHNICAL CONSULTANTS, INC.
 LAND SURVEYORS
 www.midwesttech.com
 1832 CENTRE POINT DRIVE
 SUITE 108
 NAPERVILLE, ILLINOIS 60563
 TELEPHONE: (630) 555-0101
 FACSIMILE: (630) 555-0318

PREPARED FOR:
 PACIFIC CONSTRUCTION

 JOB NO.: 426-118 DRAWN BY: SP